F.H.W.A. REGION NO.	STATE	FED. AID PROJ. NO.	SHEET NO.	TOTAL SHEETS
3	MD.	SEE TITLE SHEET		

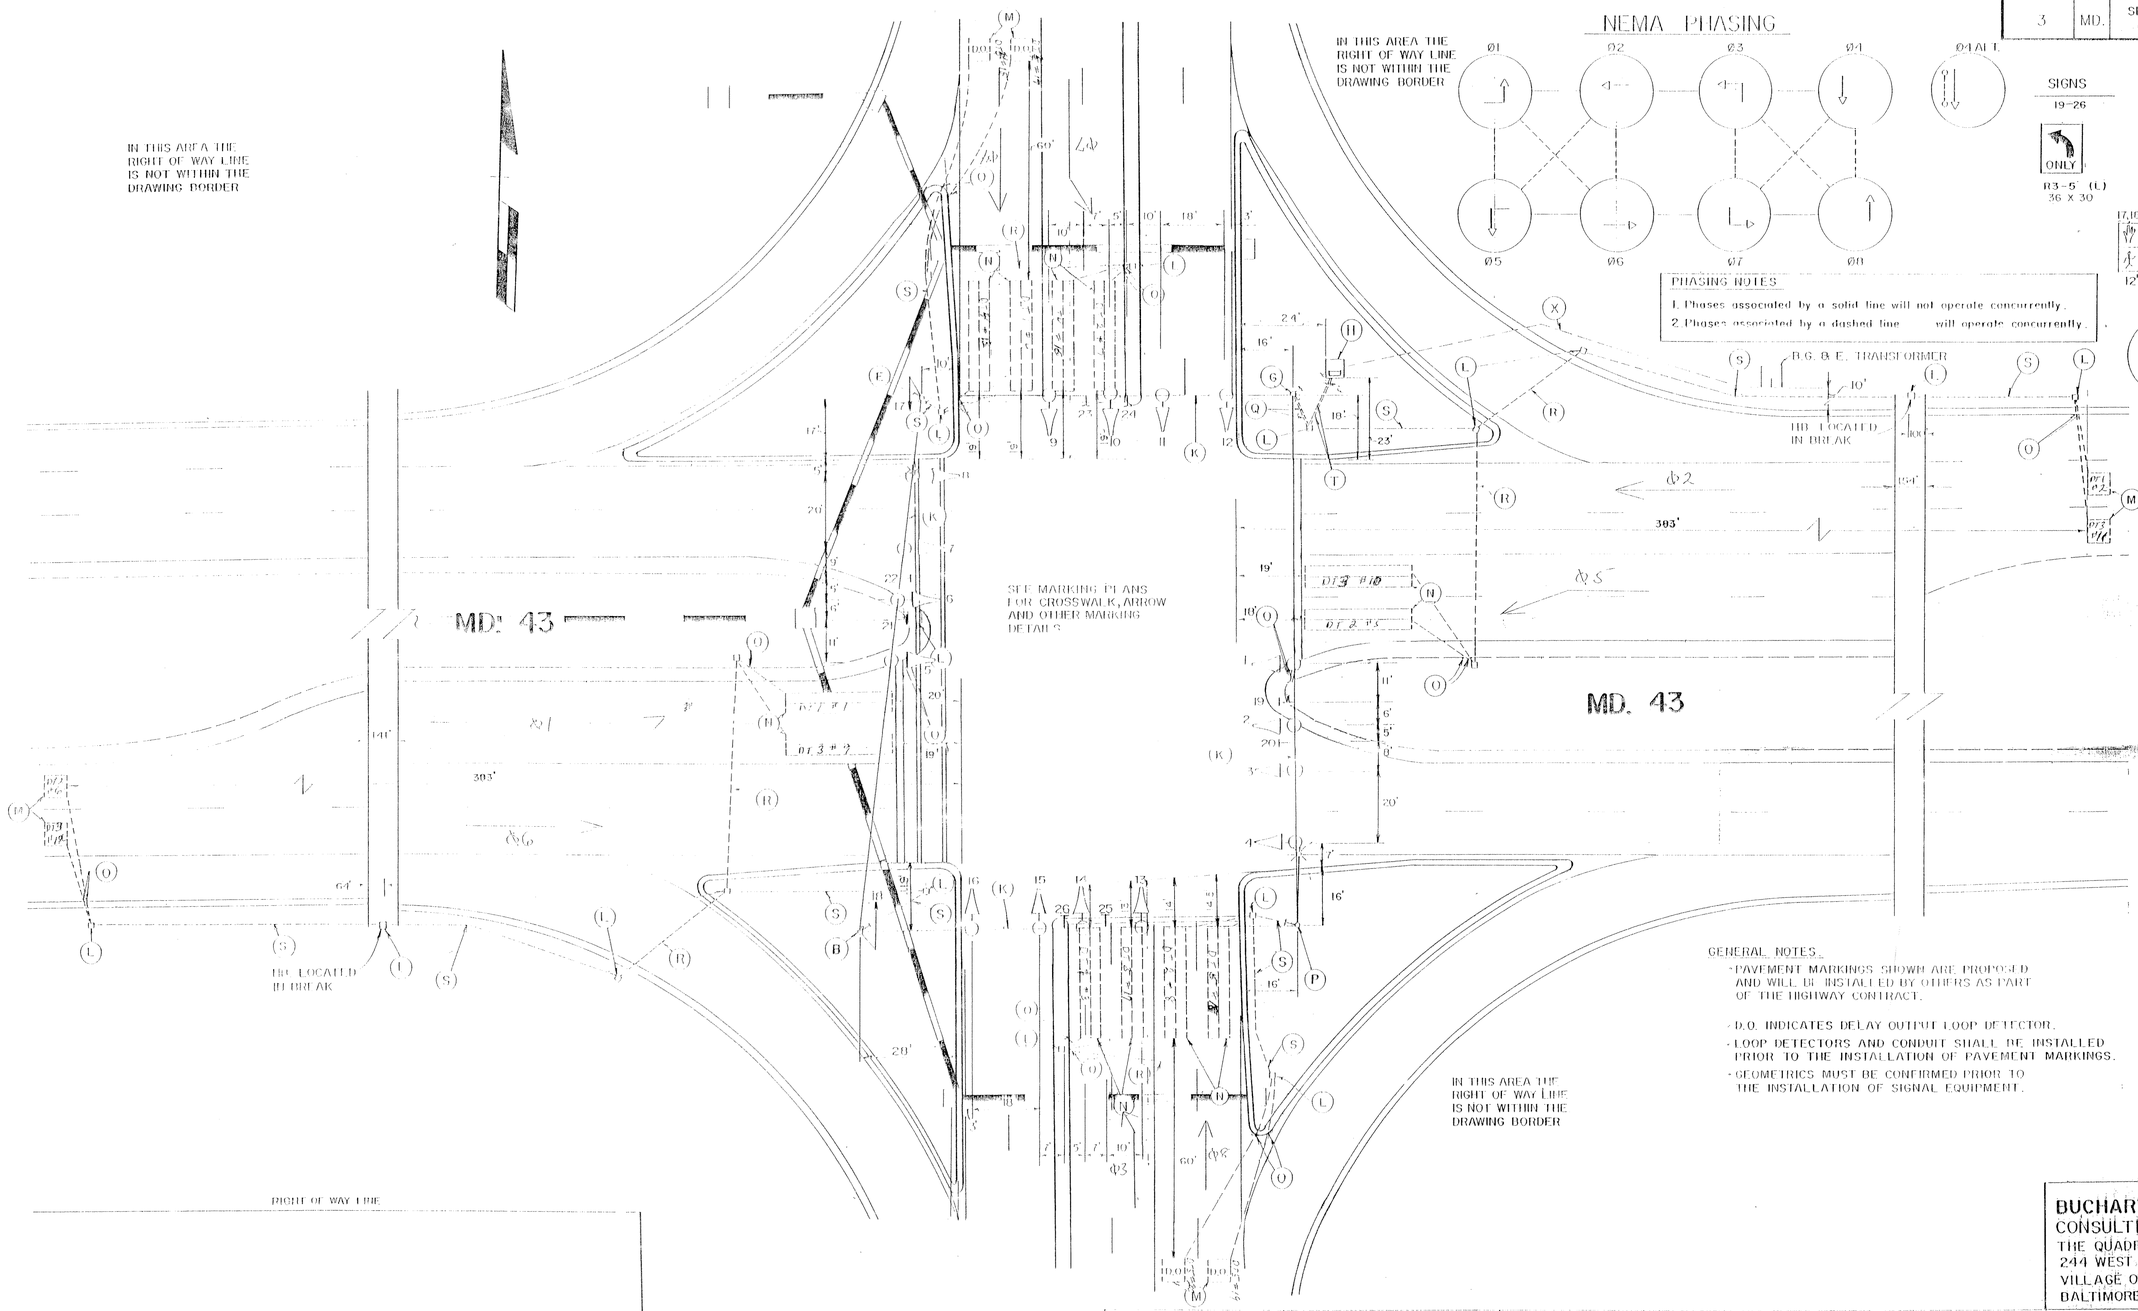

GENERAL NOTES.

- PAVEMENT MARKINGS SHOWN ARE PROPOSED AND WILL BE INSTALLED BY OTHERS AS PART OF THE HIGHWAY CONTRACT.
- D.O. INDICATES DELAY OUTPUT LOOP DETECTOR.
- LOOP DETECTORS AND CONDUIT SHALL BE INSTALLED PRIOR TO THE INSTALLATION OF PAVEMENT MARKINGS.
- GEOMETRICS MUST BE CONFIRMED PRIOR TO THE INSTALLATION OF SIGNAL EQUIPMENT.

HONEYGO BOULEVARD

REVISIONS

APPROVALS

CHIEF, SIGNAL DESIGN SECTION

ASST. DISTRICT ENGINEER, TRAFFIC

CHIEF, BUREAU OF TRAFFIC ENGINEERING

DEPUTY CHIEF ENGINEER, OFFICE OF TRAFFIC

BUCHART-HORN INC.
CONSULTING ENGINEERS
THE QUADRANGLE
244 WEST BLOCK
VILLAGE OF CROSS KEYS
BALTIMORE, MARYLAND 21210

MARYLAND DEPARTMENT OF TRANSPORTATION
STATE HIGHWAY ADMINISTRATION – OFFICE OF TRAFFIC
BUREAU OF TRAFFIC ENGINEERING

DRAWN BY: A.G.S.
DES. BY: J.D.M.
CHK. BY: D.D.S.

MD 43 AND HONEYGO BOULEVARD

COUNTY: BALTIMORE

DATE: JANUARY, 1989
SCALE: 1" = 20'
F.A.P. NO. SEE TITLE SHEET
S.H.A. NO. B 910-502-471

TS/TLE NO. TS-2512

SHEET NO. ___ OF ___

03 004300.00