DRAWING NO.	STATE	PROJ. NO.	NO.	SHEET
3	MD			

PROPOSED SIGNALS

12"
(Y)
1.2

PROPOSED SIGNS

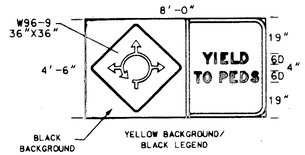

3

EXISTING SIGN

4
TO BE REMOVED

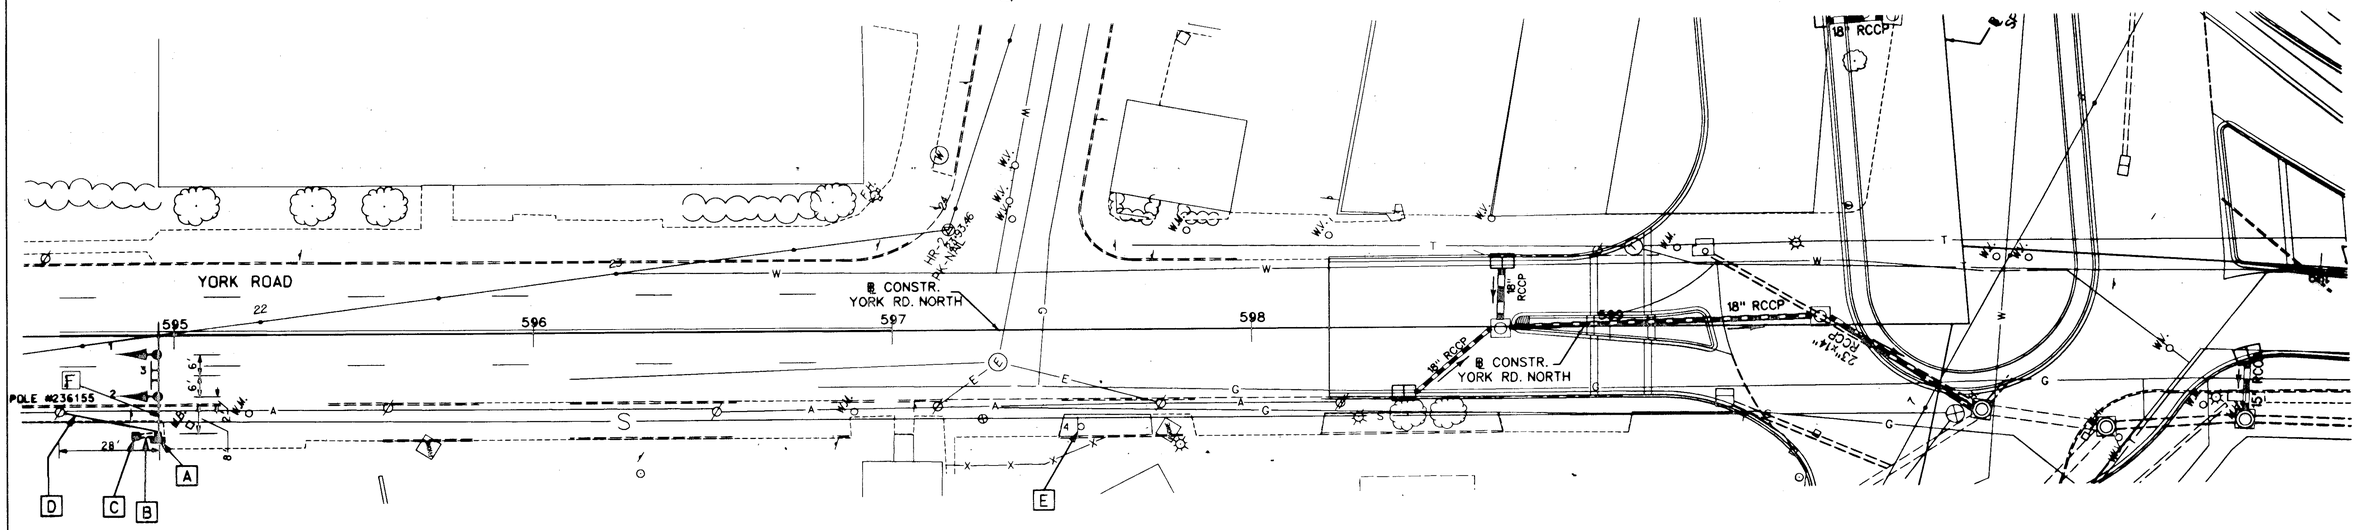

CONSTRUCTION DETAILS

A. Install a 21 ft. steel pole with a 40 ft. mast arm, signal heads and sign, flasher & cabinet, and controll & distribution equipment. (Note: One - 2 in. PVC schedule 80 conduit bend and four - 1 1/2 in. x 60 in. anchor bolts). Also, cut & cap mast arm to 24 ft.

B. Install a 2 in. PVC schedule 80 electrical conduit - trenched.

C. Install electrical handhole.

D. Proposed overhead power service.

E. Remove ground mounted sign.

F. Install 3 conductor electrical cable (No. 14 AWG) in mast arm.

UTILITY LEGEND	
T	TELEPHONE CABLES
G	GAS MAIN
W	WATER MAIN
S	SEWER MAIN
E	ELECTRIC CABLES
A	AERIAL CABLES
BC	BURIED CABLE
SD	STORM DRAIN

GEOMETRIC LEGEND	
- - - - - -	EXISTING GEOMETRICS
———	PROPOSED GEOMETRICS

REVISIONS	APPROVALS
REDLINE REVISION ADD SHEET	ASST. DIVISION CHIEF, TEDD
	ASST. DISTRICT ENGINEER, TRAFFIC
	CHIEF, TRAFFIC ENGINEERING DESIGN DIVISION
	DIRECTOR, OFFICE OF TRAFFIC & SAFETY

MARYLAND DOT - STATE HIGHWAY ADMINISTRATION
Office of Traffic & Safety
TRAFFIC ENGINEERING DESIGN DIVISION
MD 45 (YORK ROAD) AT INVESTMENT AVENUE

TS# 3947

DATE 8 / /98

DRAWN BY: R CICCHINI	F.A.P. NO.		PLAN SHEET NO.	SHEET NO. 1 OF 1
CHECK BY: D PETERS	S.H.A. NO.			
SCALE: 1"=20'	COUNTY	BALTIMORE		