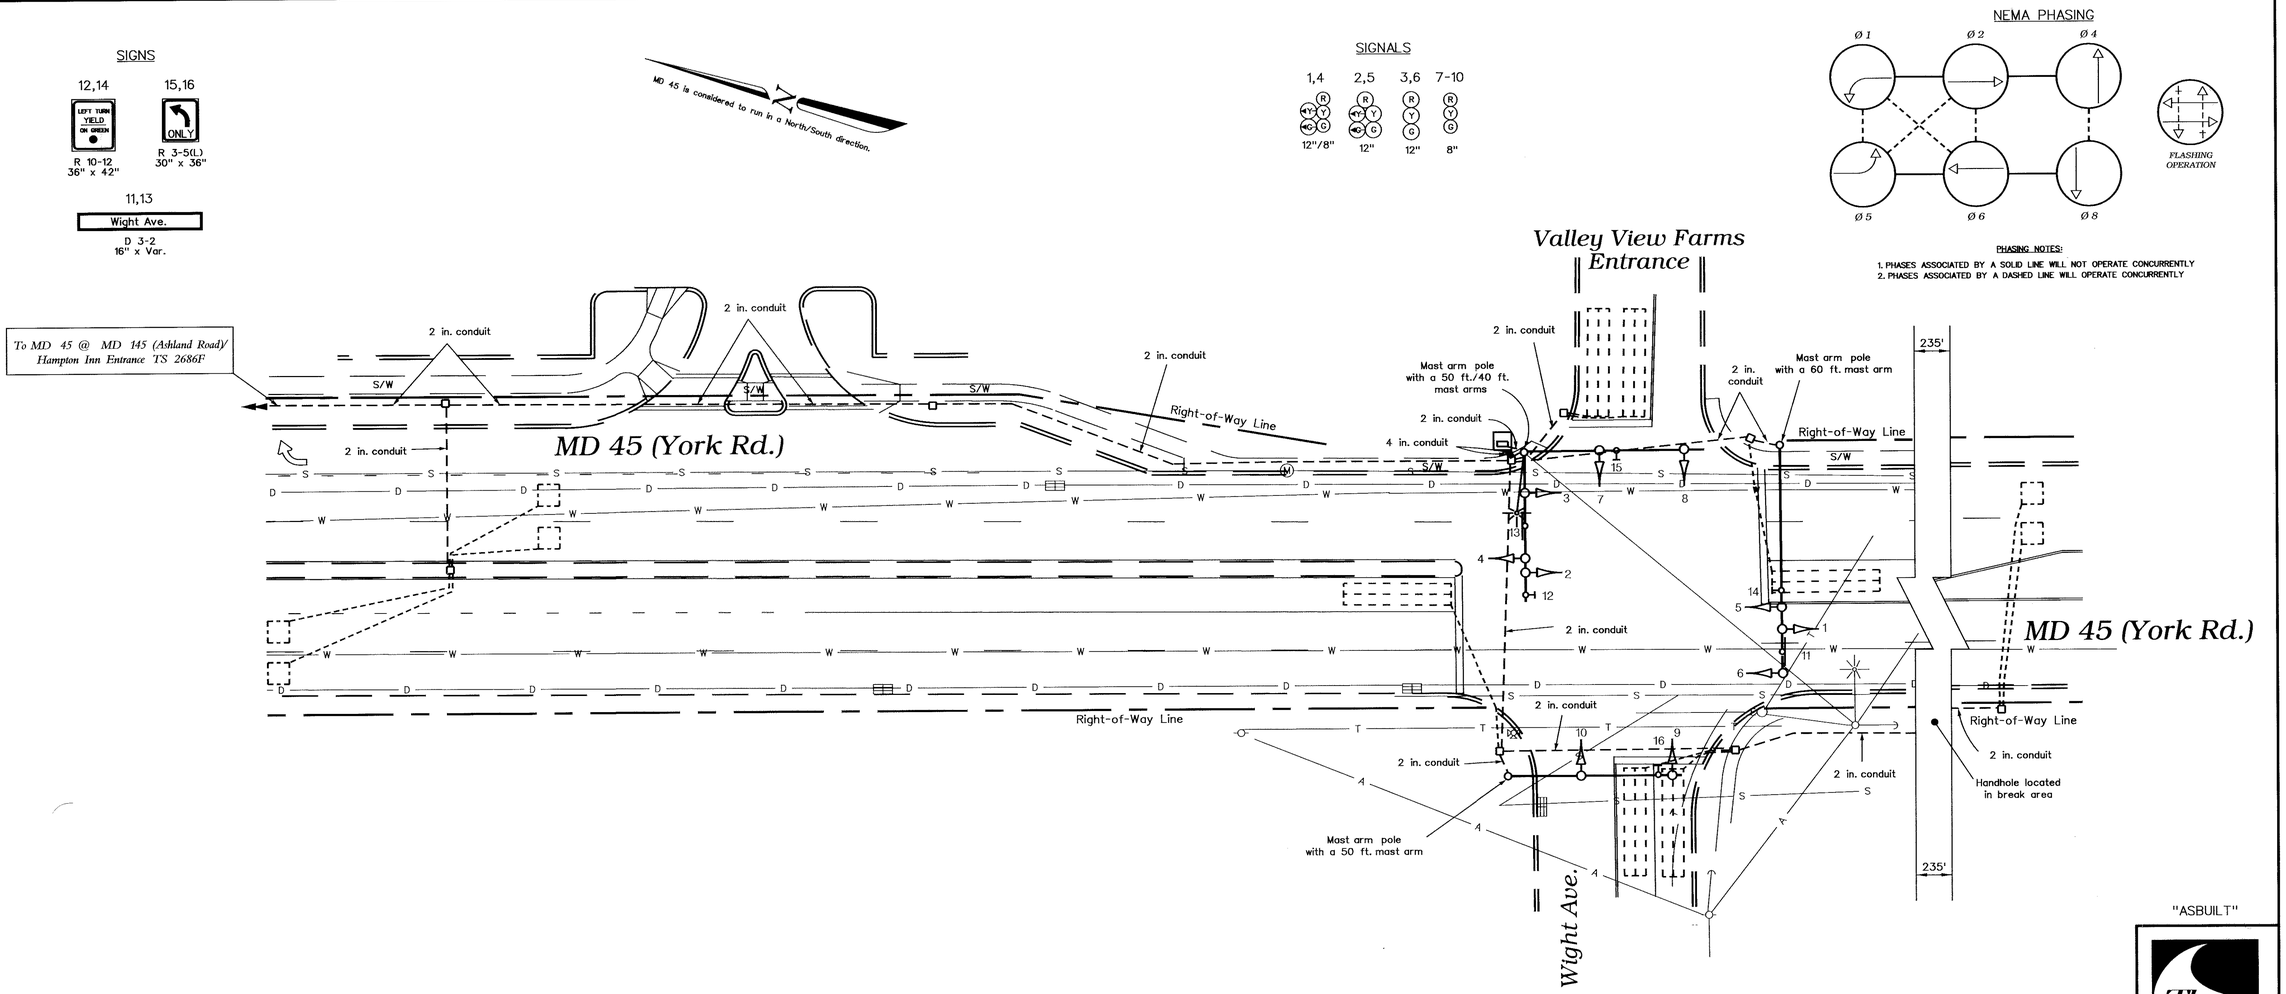

The Traffic Group

The Traffic Group, Inc.
Suite H
9900 Franklin Square Drive
Baltimore, Maryland 21236
410-931-86600
1-800-583-8411
Fax 410-931-6601
Job. No. 971114
ASBUILT2.DGN

GEOMETRIC LEGEND	REVISIONS	APPROVALS
EXISTING GEOMETRICS		ASST. TRAFFIC ENGINEERING DESIGN DIVISION
PROPOSED GEOMETRICS		ASST. DISTRICT ENGINEER - TRAFFIC
UTILITY LEGEND		CHIEF, TRAFFIC ENGINEERING DESIGN DIVISION
GAS MAIN	ASBUILT January 7, 2000	DIRECTOR, OFFICE OF TRAFFIC & SAFETY
WATER MAIN	S.H.A. No.:BW996M82	
SEWER MAIN	FJH	
ELECTRIC CABLES		
STORM DRAIN		
AERIAL CABLES		
TELEPHONE CABLES		

ORIGINAL ON FILE

MDOT - STATE HIGHWAY ADMINISTRATION
Office of Traffic & Safety
TRAFFIC ENGINEERING DESIGN DIVISION
(Traffic Signal Plan)

MD 45 (York Rd.) at Wight Ave./ Valley View Farms Entrance

DATE: July 13, 1989 LOG MILE • 03004508.71

DRAWN BY:	B.K.Miller	F.A.P. NO.	N/A	PLAN SHEET NO.:	SHEET NO.
CHK. BY:	D. Doda	S.H.A. NO.	B 904-459-485	2573B	1 of 1
SCALE:	1" = 20'	COUNTY:	BALTIMORE		

f:\971114\des\asbuilt2.dgn 06 JAN 2000