LEGEND

			QUANTITY
R / A / G	DONT WALK	A - Mongolever Pole Type - 28'-28' Mast Arm	2
		B - Controller #1826	1
1-6	7,	C - Transensor Detector	4
		D - Hand Box	3
		E - Loop Detector	1
		F - Sign - NTOR	1
		G - 4'x8' Steel Strain Pole 4" Slip Fitter	1
		H - Push Button	2

SEQUENCE

PHASE		A		B		FLASH
SIGNAL FACE	1	G	A	R	R	A
	2	G	A	R	R	A
	3	G	A	R	R	A
	4	G	A	R	R	A
	5	R	R	G	A	R
	6	R	R	G	A	R
	7	DW	DW	F/W	F/DW	—

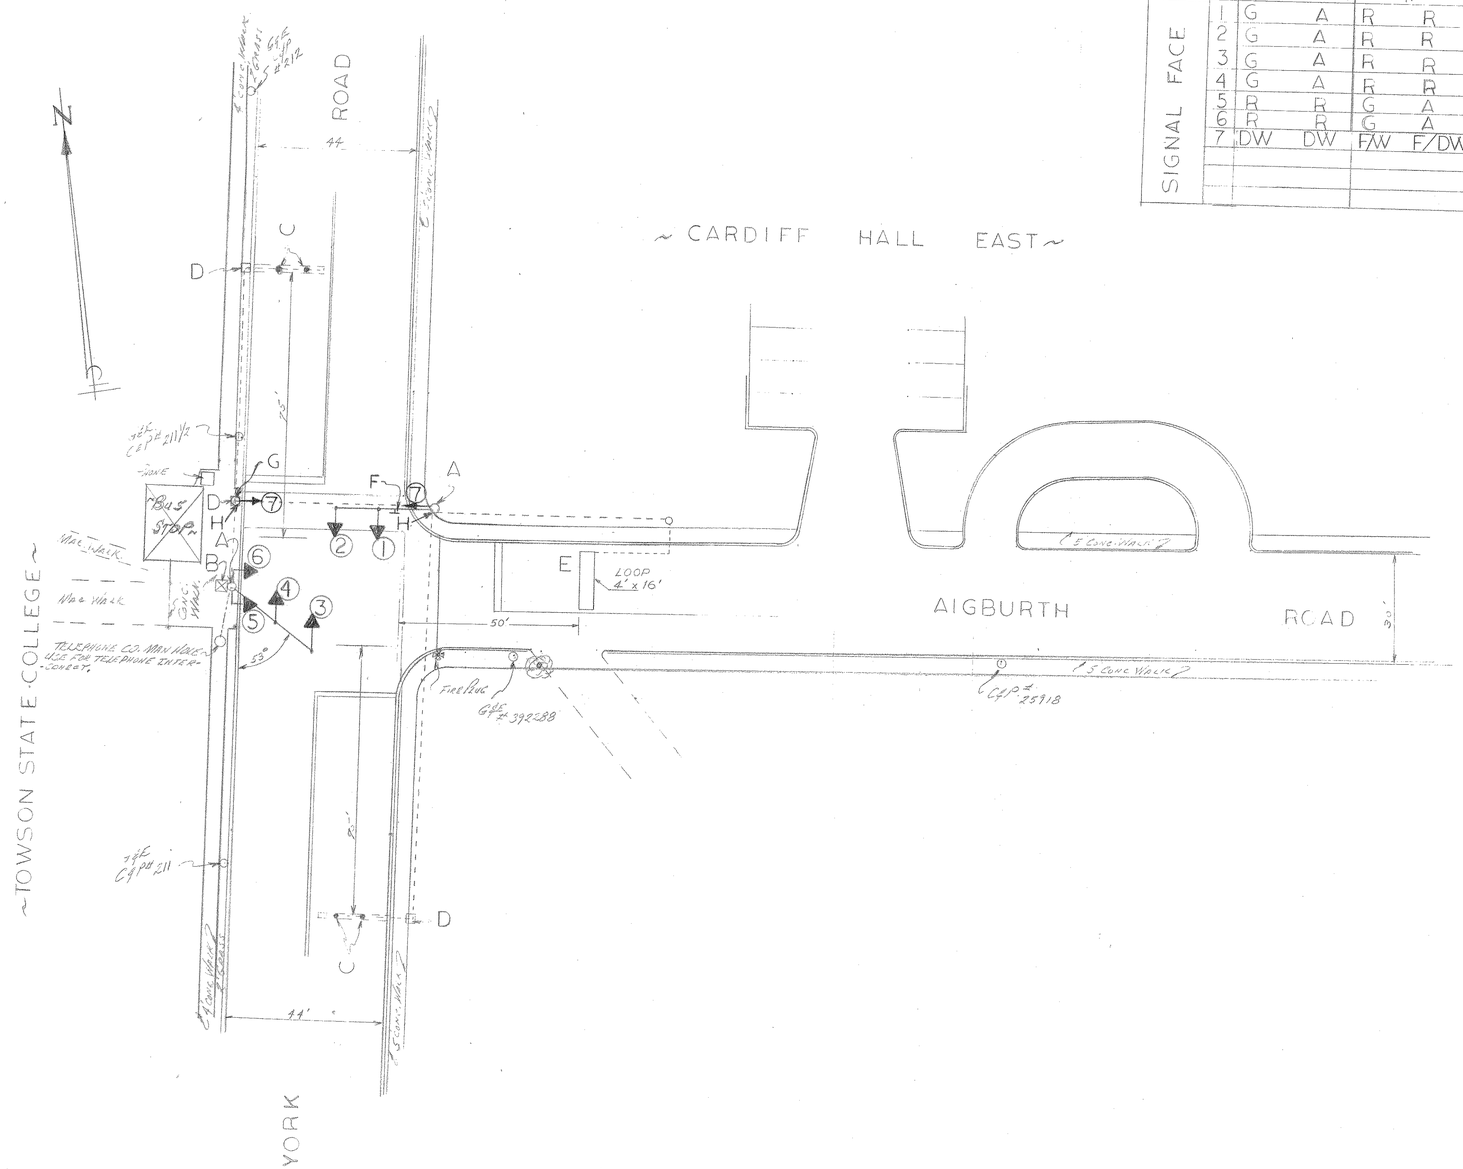

TS# 159 C

	REVISION	BY	DATE
1	Legend Rev.	[illegible]	2/25/70
2	Added Loop Detector, Deleted Treadle & Hand Box. No Cor.	E. Silvert	1/7/76
3	Ped. Signals & Push Button	[illegible]	12/11/79
4			
5			
6			

BALTIMORE COUNTY MARYLAND
DEPARTMENT OF
TRAFFIC ENGINEERING

MD 45

AIGBURTH RD. & YORK RD.