DRILL HOLES
DRILL HOLES
DRILL HOLES
BORDER REV: DATE: June 1, 2004
BY: BJG

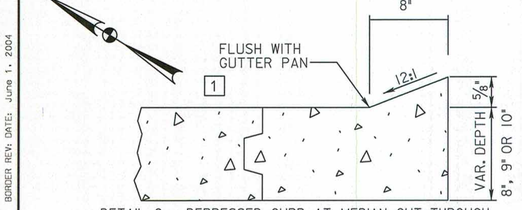


DETAIL C - DEPRESSED CURB AT MEDIAN CUT-THROUGH
NOT TO SCALE

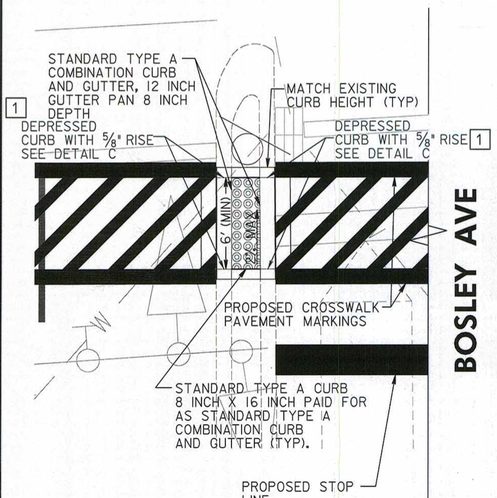


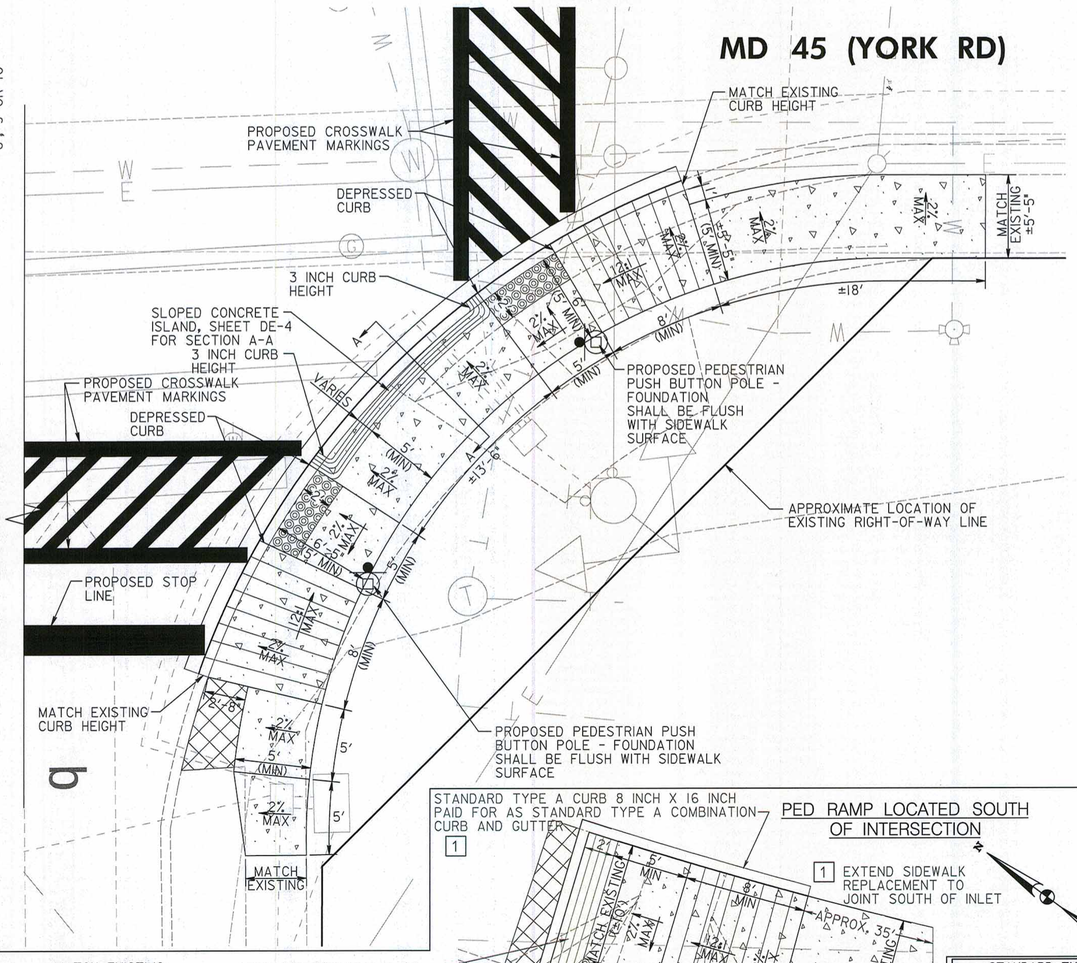


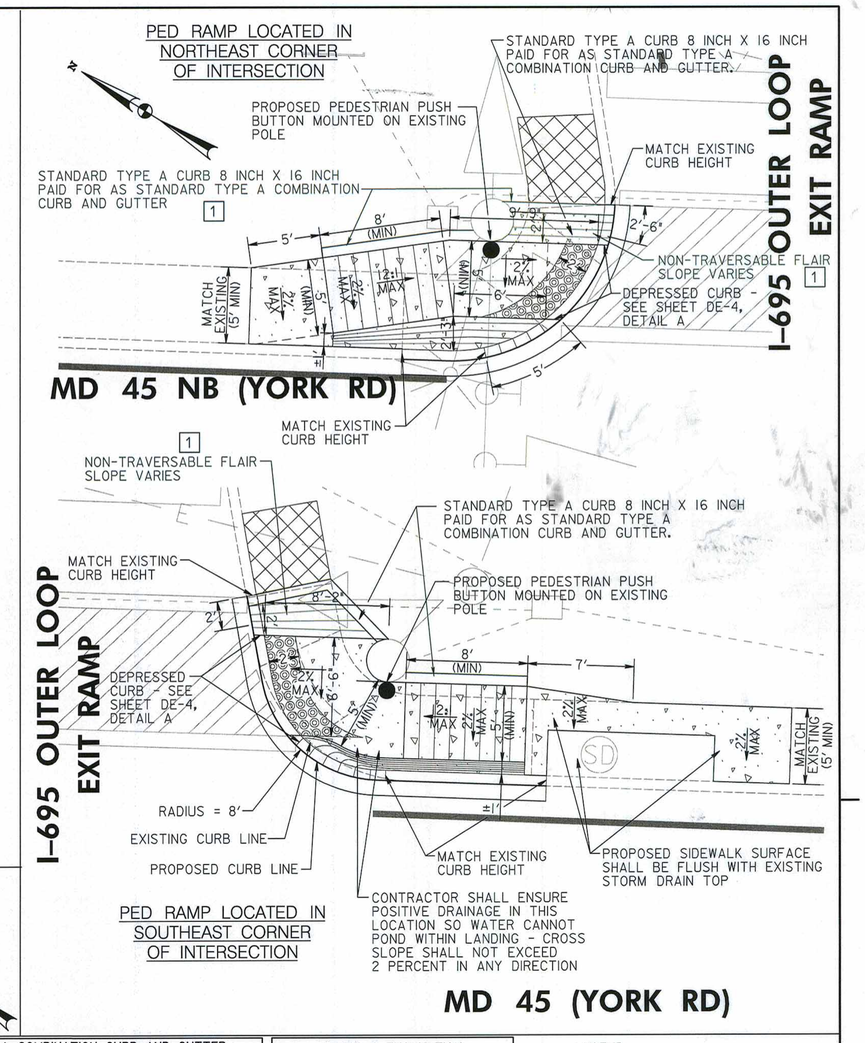


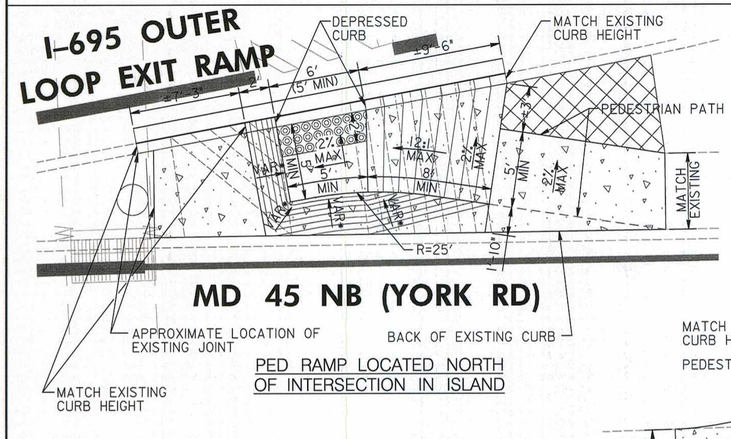


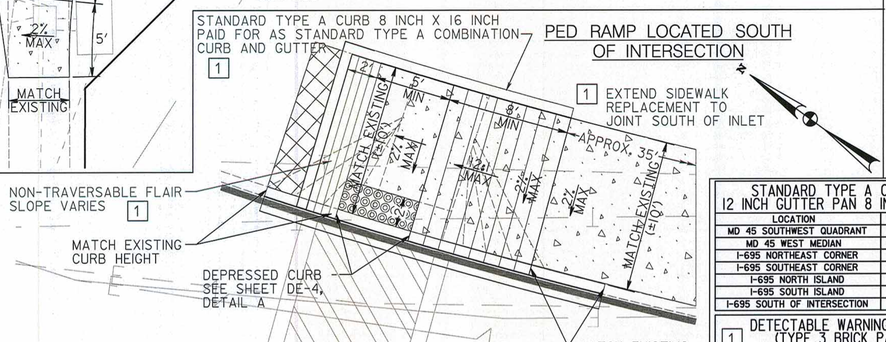


*NOTE: VARIABLE (VAR) SLOPES INDICATE CONCRETE SHALL BE SLOPED AS NEEDED TO TIE EXISTING FEATURES INTO PROPOSED FEATURES. THESE LOCATIONS ARE NOT DESIGNATED PEDESTRIAN ROUTES

| STANDARD TYPE A COMBINATION CURB AND GUTTER 12 INCH GUTTER PAN 8 INCH DEPTH SHA STD. NO. MD-620.02 | |
|---|---|
| LOCATION | QUANTITY (LF) |
| MD 45 SOUTHWEST QUADRANT | 47 |
| MD 45 WEST MEDIAN | 24 |
| I-695 NORTHEAST CORNER | ~~27~~ 38 |
| I-695 SOUTHEAST CORNER | ~~37~~ 50 |
| I-695 NORTH ISLAND | 25 |
| I-695 SOUTH ISLAND | 20 |
| I-695 SOUTH OF INTERSECTION | ~~47~~ 50 |

| CLASS 2 EXCAVATION | |
|---|---|
| LOCATION | QUANTITY (CY) |
| MD 45 SOUTHWEST QUADRANT | 0.5 |
| I-695 NORTHEAST CORNER | 1 |
| I-695 SOUTHEAST CORNER | 1 |
| I-695 NORTH ISLAND | 1 |
| I-695 SOUTH OF INTERSECTION | 1 |

LEGEND
- CONCRETE PAVEMENT
- DETECTABLE WARNING SURFACE (TYPE 3 BRICK PAVERS) SHA STD. NO. MD-655.40
- REMOVE EXISTING SIDEWALK (CLASS 2 EXCAVATION)

| 1 DETECTABLE WARNING SURFACE (TYPE 3 BRICK PAVERS) SHA STD. NO. MD-655.40 | |
|---|---|
| LOCATION | QUANTITY (SF) |
| MD 45 SOUTHWEST QUADRANT | 23 |
| I-695 NORTHEAST CORNER | 14 |
| I-695 SOUTHEAST CORNER | 16 |
| I-695 NORTH ISLAND | 12 |
| I-695 SOUTH ISLAND | 13 |
| I-695 SOUTH OF INTERSECTION | 10 |
| MD 45 WEST MEDIAN | 12 |

| 1 5 INCH CONCRETE SIDEWALK | |
|---|---|
| LOCATION | QUANTITY (SF) |
| MD 45 SOUTHWEST QUADRANT | 430 |
| MD 45 WEST MEDIAN | ~~12~~ 0 |
| I-695 NORTHEAST CORNER | ~~134~~ 150 |
| I-695 SOUTHEAST CORNER | ~~165~~ 181 |
| I-695 NORTH ISLAND | 241 |
| I-695 SOUTH ISLAND | 266 |
| I-695 SOUTH OF INTERSECTION | ~~102~~ 452 |

REFER TO SHEET DE-1 FOR ALL GENERAL NOTES 1

STATE OF MARYLAND
DEPARTMENT OF TRANSPORTATION
STATE HIGHWAY ADMINISTRATION

MD 45 (YORK RD) AT BOSLEY AVE AND I-695 RAMPS

RK&K
RUMMEL, KLEPPER & KAHL, LLP
81 MOSHER STREET | BALTIMORE, MD 21217
PH: (410) 728-2900 FAX: (410) 728-3160
Engineers | Construction Managers | Planners | Scientists
www.rkk.com

REVISIONS
1 GREENLINE NO. 1 04-2013 MODIFY SIDEWALK 5-1-13

**RAMP DETAILS**

SCALE 1" = 5' DATE OCTOBER 2012 CONTRACT NO. XY1255185

DESIGNED BY JDG
DRAWN BY JBB
CHECKED BY ATD
FAP NO.
COUNTY BALTIMORE
LOGMILE 03004502.59 AND 03004503.22
TIMS NO. L667
TOD NO.

TS NO. 3982B-DE 4115A-DE | DRAWING DE-2 OF 4 | SHEET NO. 10 OF 12

PLOTTED: Thursday, April 25, 2013 AT 11:17 AM
FILE: \\balsvr03\c2008\2008\08148_tcddesk\Task 141_MD 45 Lutherville\CADD\pDE-P002_MD45-Bosley-695 - merge.dgn