
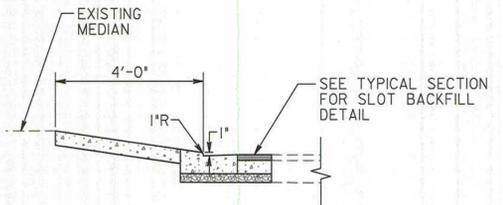


BORDER REV. DATE: June 11, 2004


DRILL HOLES

DRILL HOLES


DRILL HOLES

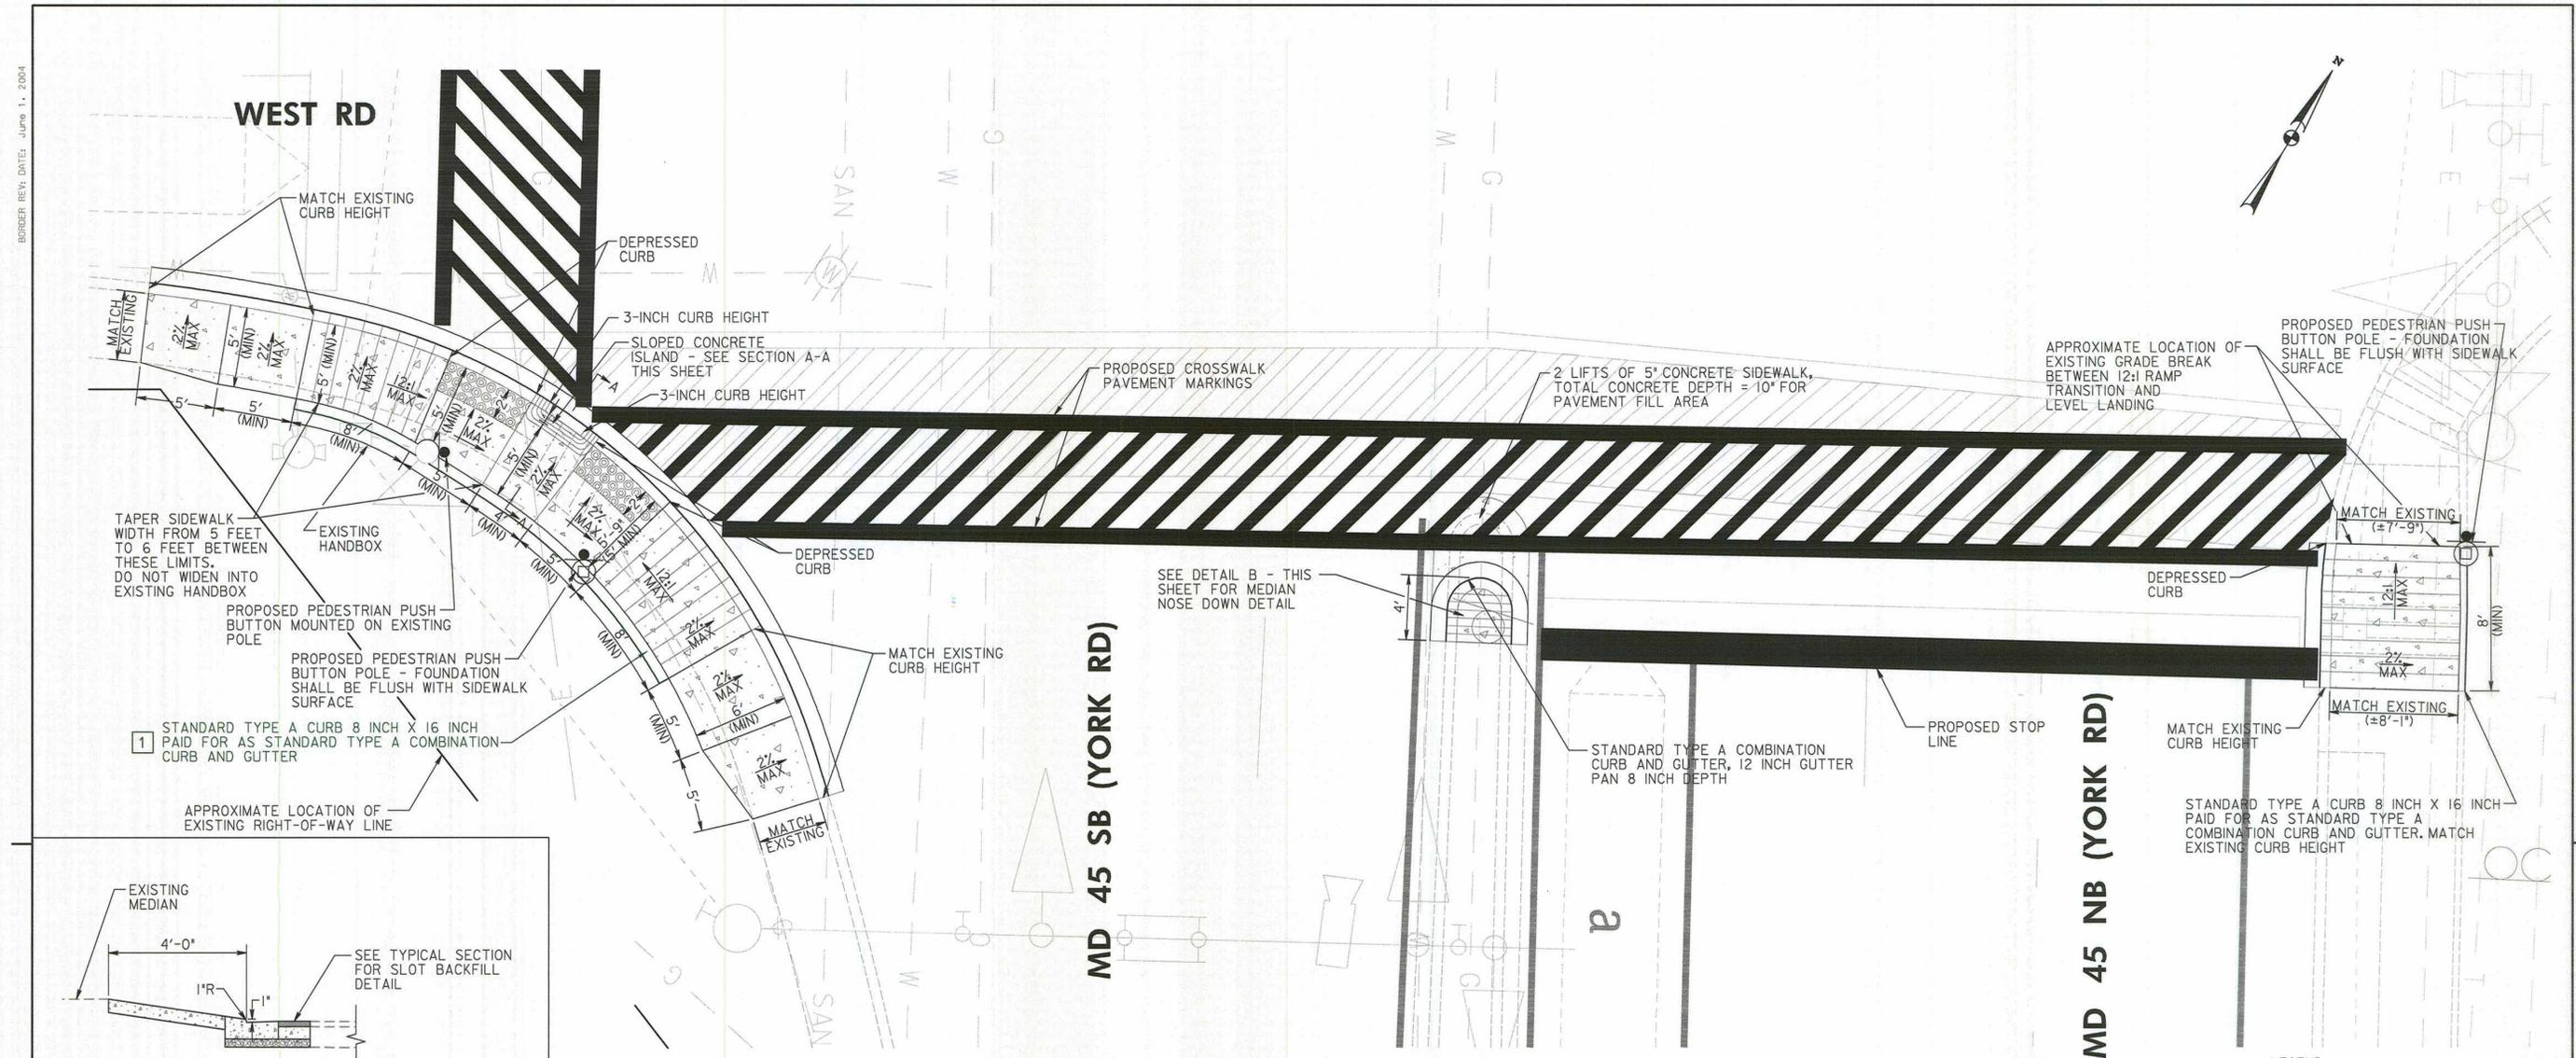

DETAIL B
PROPOSED MEDIAN NOSE DOWN
NOT TO SCALE

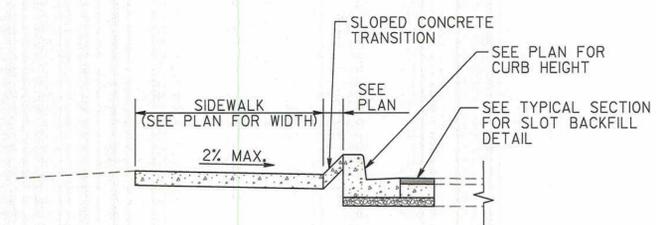

SECTION A-A
PROPOSED SIDEWALK AND
SLOPED CONCRETE ISLAND
NOT TO SCALE

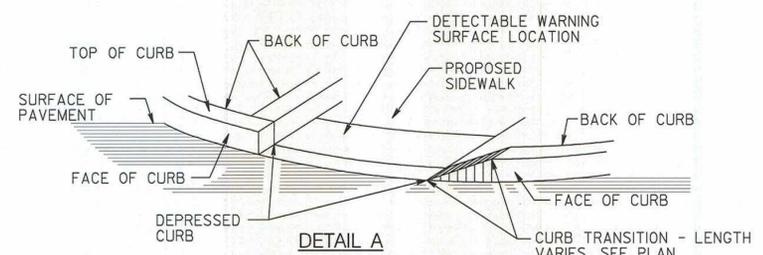

DETAIL A
ISOMETRIC VIEW
OF CURB TRANSITION
AND RAMP LAYOUT
NOT TO SCALE

LEGEND

	CONCRETE PAVEMENT
	DETECTABLE WARNING SURFACE (TYPE 3 BRICK PAVERS) SHA STD. NO. MD-655.40

REFER TO SHEET DE-1 FOR ALL GENERAL NOTES

1 STANDARD TYPE A COMBINATION CURB AND GUTTER
12 INCH GUTTER PAN 8 INCH DEPTH SHA STD. NO. MD-620.02

LOCATION	QUANTITY (LF)
SOUTHWEST QUADRANT	58.88
SOUTH MEDIAN	11
SOUTHEAST QUADRANT	18

DETECTABLE WARNING SURFACE
(TYPE 3 BRICK PAVERS)
SHA STD. NO. MD-655.40

LOCATION	QUANTITY (SF)
SOUTHWEST QUADRANT	23

5 INCH CONCRETE SIDEWALK

LOCATION	QUANTITY (SF)
SOUTHWEST QUADRANT	296
SOUTH MEDIAN	60
SOUTHEAST QUADRANT	75

SHA STATE OF MARYLAND
DEPARTMENT OF TRANSPORTATION
STATE HIGHWAY ADMINISTRATION

MD 45 (YORK RD) AT WEST RD

RK&K
RUMMEL, KLEPPER & KAHL, LLP
81 MOSHER STREET | BALTIMORE, MD 21217
PH: (410) 728-2900 FAX: (410) 728-3180

Engineers | Construction Managers | Planners | Scientists
www.rkk.com

REVISIONS		RAMP DETAILS	
1	GREENLINE NO. 1 04-2013 MODIFY SIDEWALK	SCALE 1" = 5'	DATE OCTOBER 2012 CONTRACT NO. XY1255185
DESIGNED BY	JDG	COUNTY	BALTIMORE
DRAWN BY	JBB		03004503.07
CHECKED BY	ATD	TIMS NO.	L667
FAP NO.		TOD NO.	
TS NO. 3384F-DE	DRAWING DE-4	OF 4	SHEET NO. 12 OF 12

BY: BJG