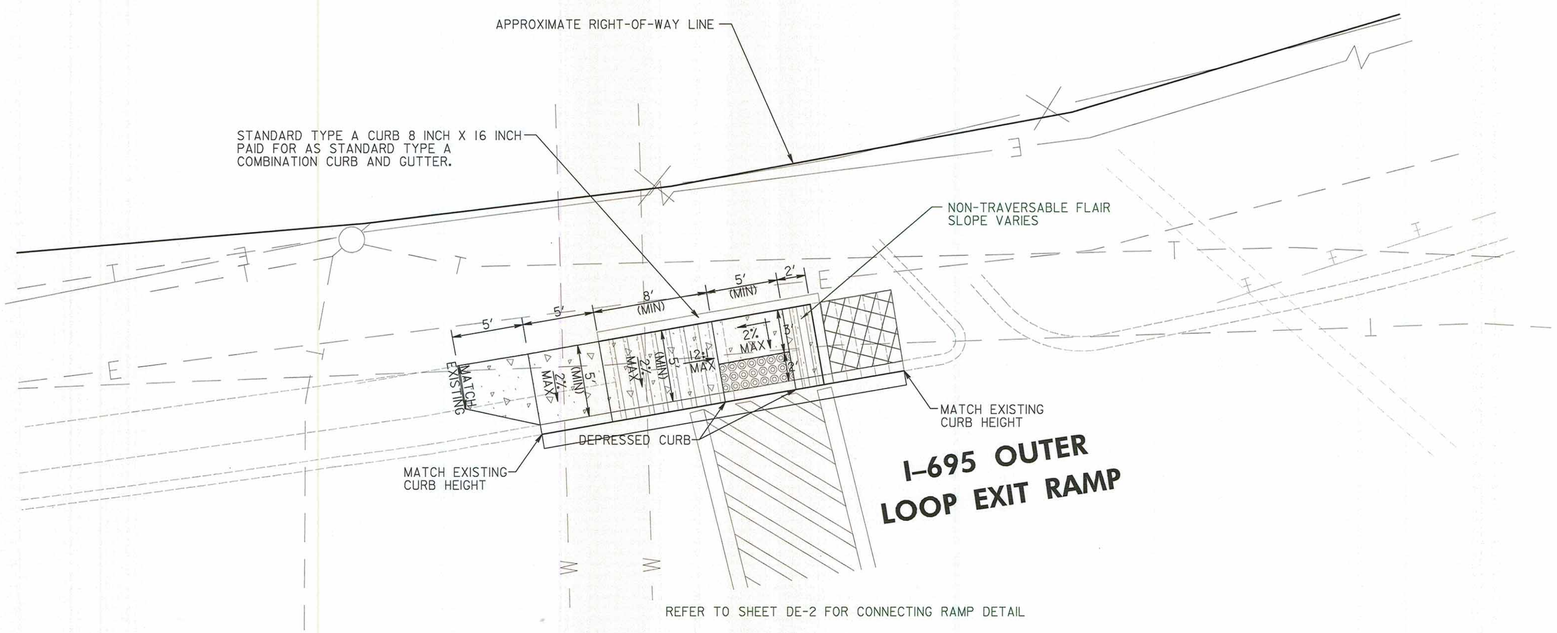

REFER TO SHEET DE-1 FOR ALL GENERAL NOTES

STANDARD TYPE A COMBINATION CURB AND GUTTER 12 INCH GUTTER PAN 8 INCH DEPTH SHA STD. NO. MD-620.02	
LOCATION	QUANTITY (LF)
I-695 RAMP	41

CLASS 2 EXCAVATION	
LOCATION	QUANTITY (CY)
I-695 RAMP	1

DETECTABLE WARNING SURFACE (TYPE 3 BRICK PAVERS) SHA STD. NO. MD-655.40	
LOCATION	QUANTITY (SF)
I-695 RAMP	10

5 INCH CONCRETE SIDEWALK	
LOCATION	QUANTITY (SF)
I-695 RAMP	115

LEGEND

- CONCRETE PAVEMENT
- DETECTABLE WARNING SURFACE (TYPE 3 BRICK PAVERS) SHA STD. NO. MD-655.40
- REMOVE EXISTING SIDEWALK (CLASS 2 EXCAVATION)

RK&K
RUMMEL, KLEPPER & KAHL, LLP
81 MOSHER STREET | BALTIMORE, MD 21217
PH: (410) 728-2900 FAX: (410) 728-3160
Engineers | Construction Managers | Planners | Scientists
www.rkk.com

REVISIONS

1 GREENLINE NO. 1 04-2013 INSERT SHEET

STATE OF MARYLAND
DEPARTMENT OF TRANSPORTATION
STATE HIGHWAY ADMINISTRATION

MD 45 (YORK RD) I-695 RAMPS

RAMP DETAILS

SCALE 1" = 5'	DATE OCTOBER 2012	CONTRACT NO. XY1255185	
DESIGNED BY JDG		COUNTY BALTIMORE	
DRAWN BY JBB		LOGMILE 03004503.22	
CHECKED BY ATD		TIMS NO. L667	
FAP NO.		TOD NO.	
TS NO. 4115A-DE	DRAWING DE-5 OF 5	SHEET NO. 12A OF 12	

PLOTTED: Wednesday, April 24, 2013 AT 07:22 AM
FILE: \\balsrv03\v20081\2008\08148_bridges\Task 141_MD 45 Lutherville\CADD\pDE-P005_MD45-695 - merge.dgn

DRILL HOLES
DRILL HOLES
DRILL HOLES
BORDER REV: DATE: June 1, 2004
BY: BJG