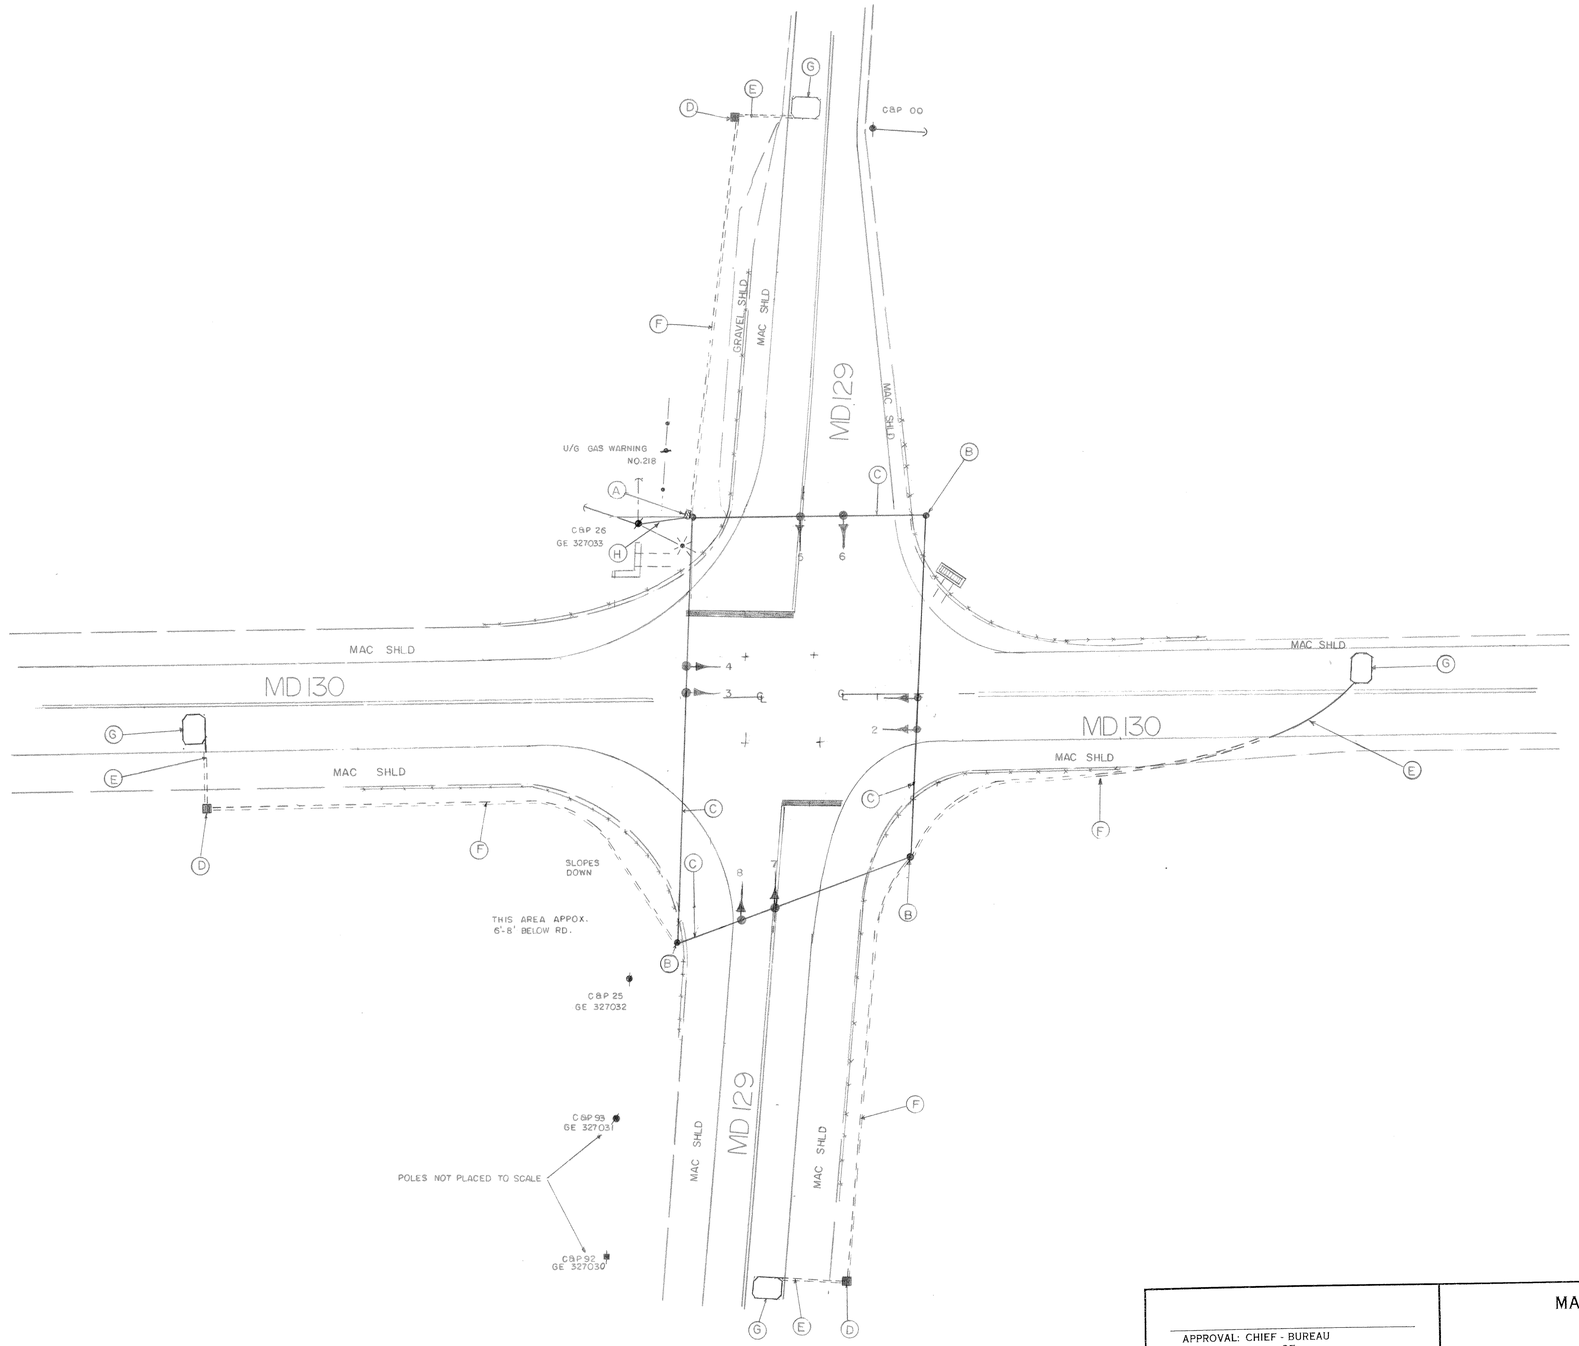


SIGNALS
1-8
R
Y
G

PHASE A

PHASE B

FLASHING
OPERATION

| | |
|---|---|
| A | 7-11-73 |
| | ASBUILT |
| BM | |
| | REVISIONS |

APPROVAL: CHIEF - BUREAU OF TRAFFIC ENGINEERING

10-23-72

APPROVAL: ASS'T CHIEF ENGINEER TRAFFIC SAFETY

MARYLAND STATE ROADS COMMISSION
DIVISION OF TRAFFIC SAFETY
BUREAU OF TRAFFIC ENGINEERING

MD 129 & MD 130

SIGNAL NO. 02148

DATE 10-22-72
SCALE 1"=20'
DRAWN BY: WES GUCKERT

CONTRACT NO B-212X-475
COUNTY BALTIMORE
CHECKED BY: William J. Fitch 11-23-72

DRAWING NO.
TS 752A

03012902.98