FHWA REGION NO.	STATE	FED. AID PROJ. NO.	SHEET NO.	TOTAL SHEETS
3	MD			

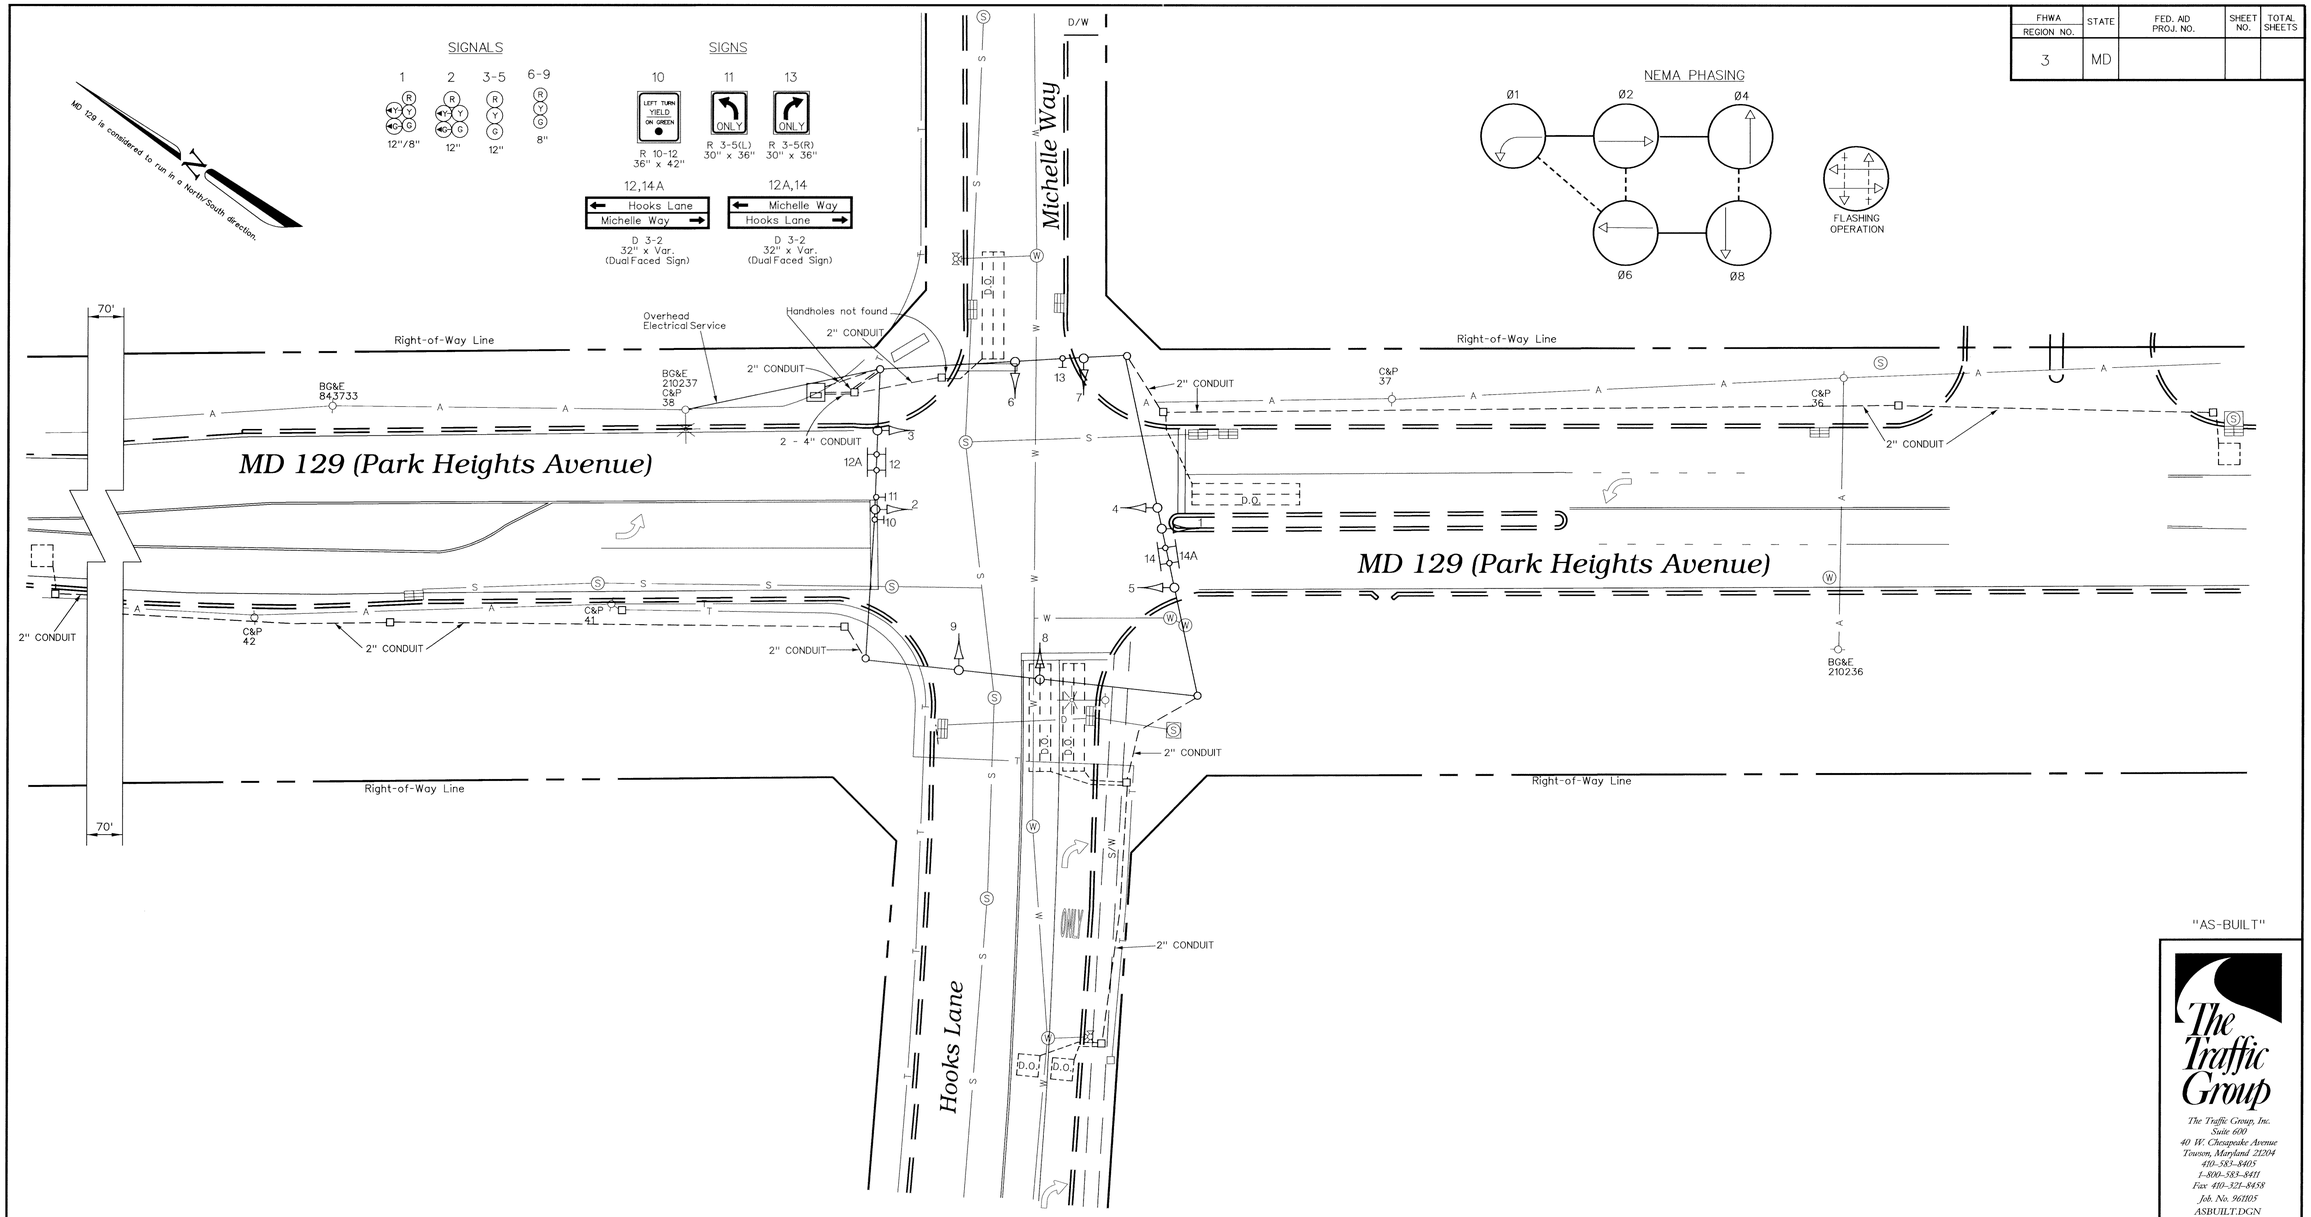

"AS-BUILT"

The Traffic Group

The Traffic Group, Inc.
Suite 600
40 W. Chesapeake Avenue
Towson, Maryland 21204
410-583-8405
1-800-583-8411
Fax 410-321-8458
Job. No. 961105
ASBUILT.DGN

GEOMETRIC LEGEND

EXISTING GEOMETRICS
PROPOSED GEOMETRICS

UTILITY LEGEND

G	GAS MAIN
W	WATER MAIN
S	SEWER MAIN
E	ELECTRIC CABLES
D	STORM DRAIN
A	AERIAL CABLES
T	TELEPHONE CABLES

REVISIONS

(B) ASBUILT November 20, 1996
S.H.A. No.:
DD

APPROVALS

ORIGINAL ON FILE

ASST. DIVISION CHIEF TRAFFIC ENGINEERING DESIGN DIVISION
CHIEF, TRAFFIC ENGINEERING DESIGN DIVISION
ASST. DISTRICT ENGINEER - TRAFFIC
DIRECTOR, OFFICE OF TRAFFIC & SAFETY

MDOT – STATE HIGHWAY ADMINISTRATION
Office of Traffic & Safety
TRAFFIC ENGINEERING DESIGN DIVISION

DRAWN BY: W. J. NIES
DES. BY: R. R. Zacherl
CHK. BY: D. J. D.

(Traffic Signal Plan)
MD 129 (Park Heights Avenue) and Hooks Lane/Michele Way

COUNTY: BALTIMORE
LOG MILE • 033012901.63

DATE: September 11, 1987
SCALE: 1" = 20'
F.A.P. NO.
S.H.A. NO.

TS/STD. NO. 2444B

SHEET NO. 1 of 1