F H WA REGION NO	STATE	FED. AID PROJ. NO	SHEET NO.	TOTAL SHEETS
3	MD.			

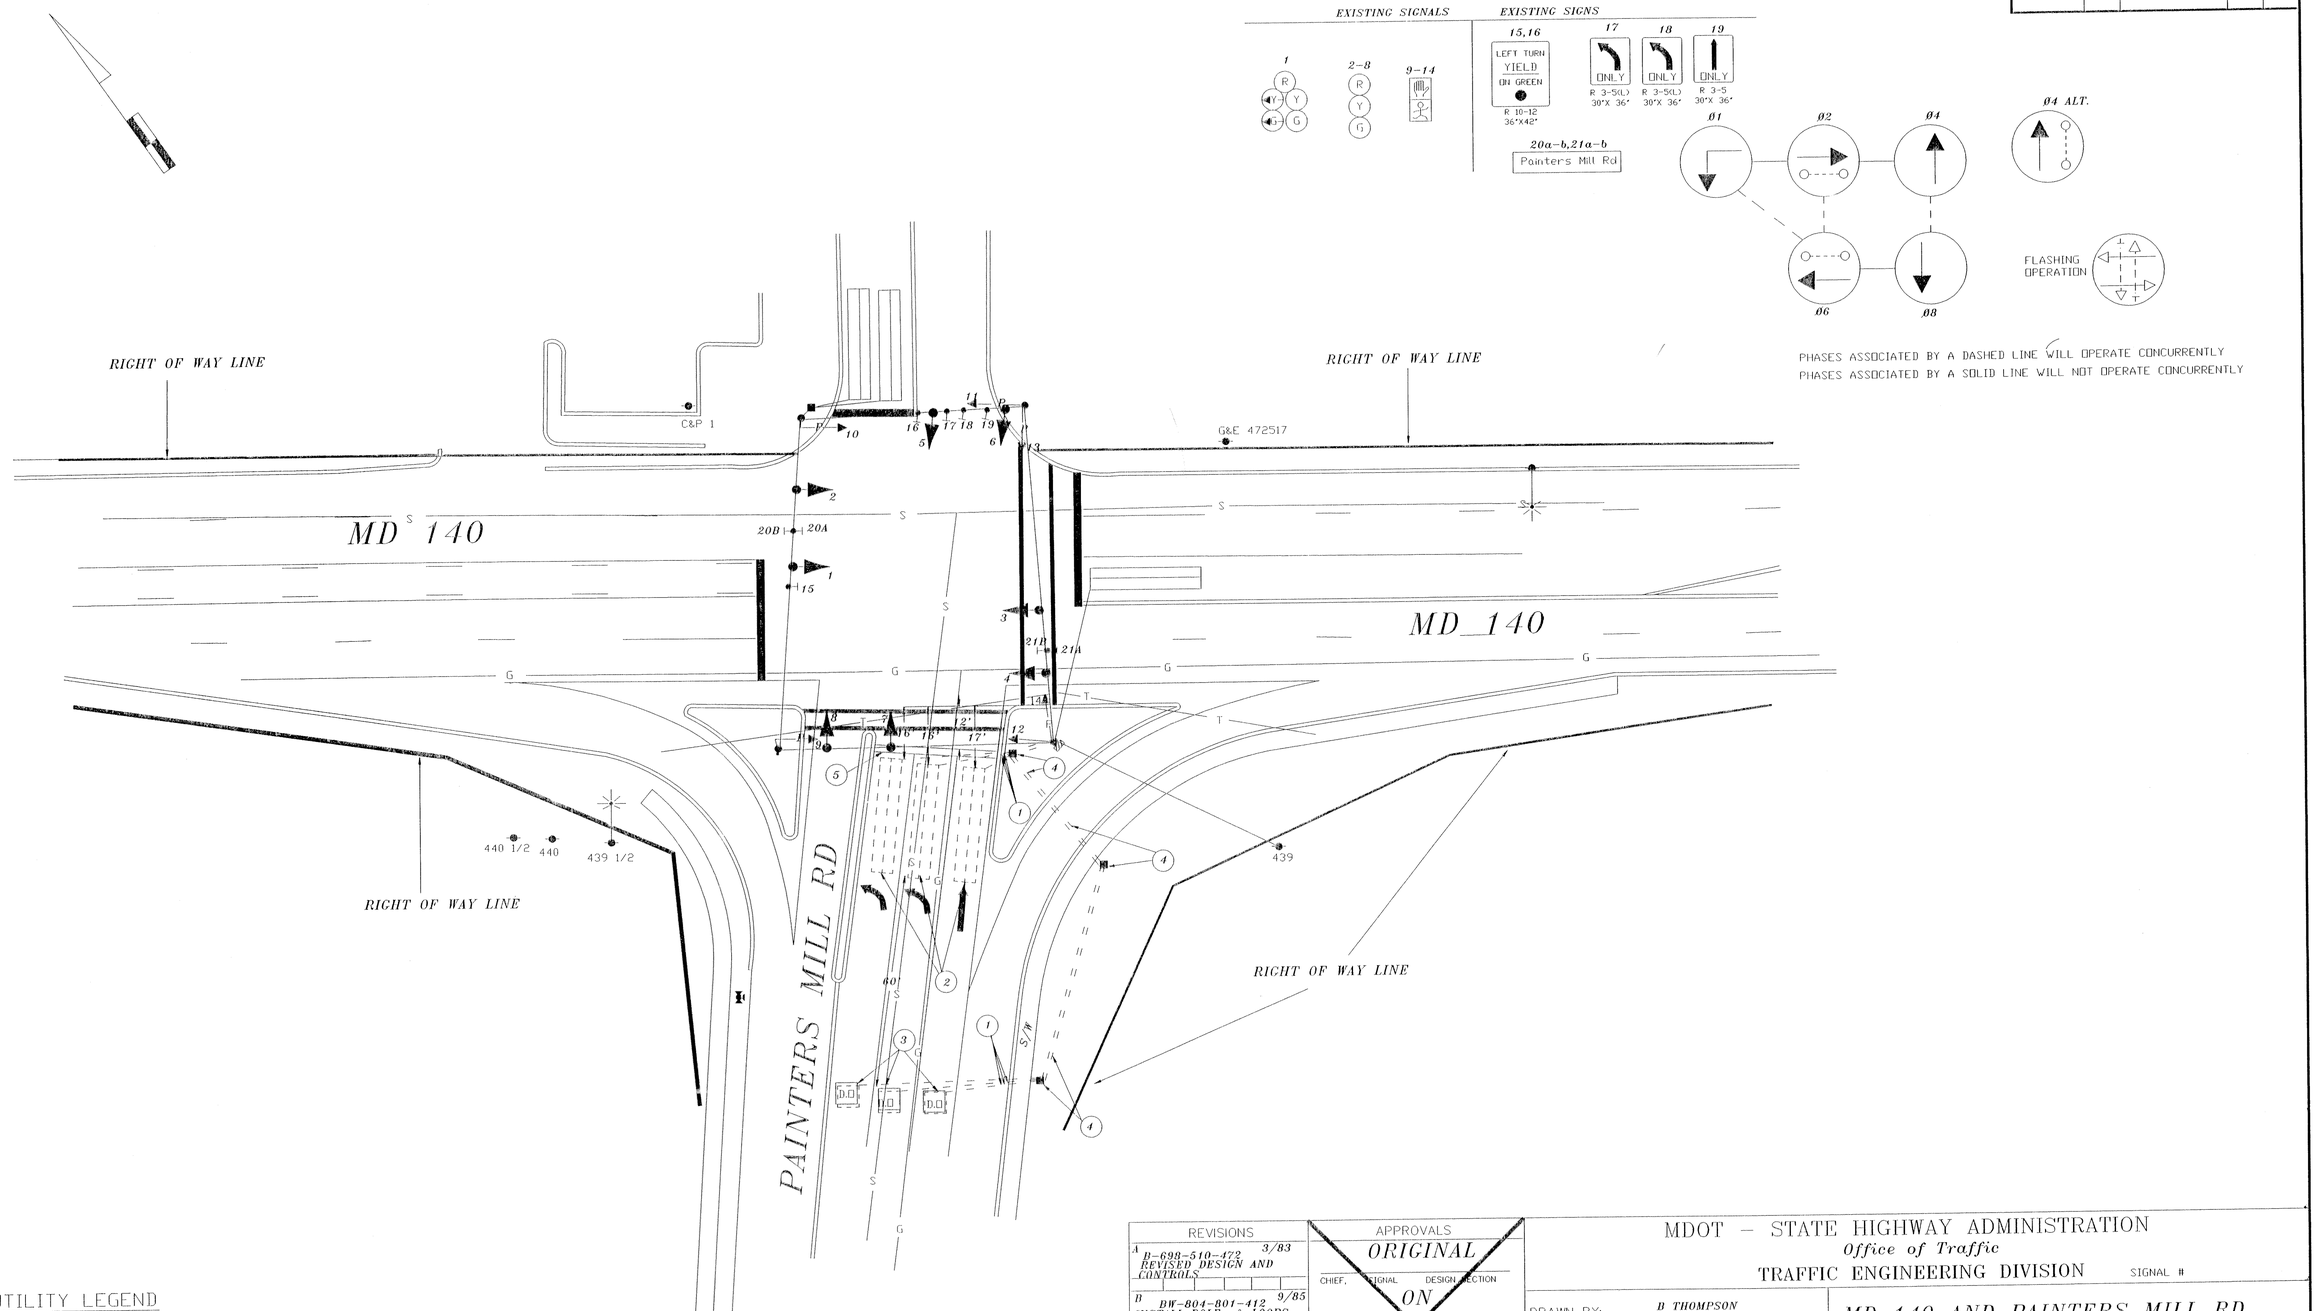

UTILITY LEGEND

G — G	GAS MAIN
W — W	WATER MAIN
S — S	SEWER MAIN
E — E	ELECTRIC CABLES
A — A	AERIAL CABLES
T — T	TELEPHONE CABLES

REVISIONS

A B-693-510-472 3/83
REVISED DESIGN AND CONTROLS

B DW-804-R01-412 9/85
INSTALL POLE & LOOPS DUE TO GEOMETRIC CHANGES

C REDRAWN 9/91
ASBUILT
REPLACE LOOP DETECTORS ON PAINTERMILL RD

APPROVALS

ORIGINAL

CHIEF, SIGNAL DESIGN SECTION

ON

ASST. DISTRICT ENGINEER, TRAFFIC

CHIEF, TRAFFIC ENGINEERING DIVISION

FILE

DEPUTY CHIEF ENGINEER, OFFICE OF TRAFFIC

MDOT – STATE HIGHWAY ADMINISTRATION
Office of Traffic
TRAFFIC ENGINEERING DIVISION SIGNAL #

DRAWN BY: B THOMPSON
DES. BY: B THOMPSON
CHK. BY:

MD 140 AND PAINTERS MILL RD

COUNTY: BALTIMORE

DATE: 6/13/73
SCALE: 1" = 20"
F.A.P. NO.
S.H.A. NO.

TS/STD. NO. 945 (C)

SHEET NO. ___ OF ___

F#15

03014004.95