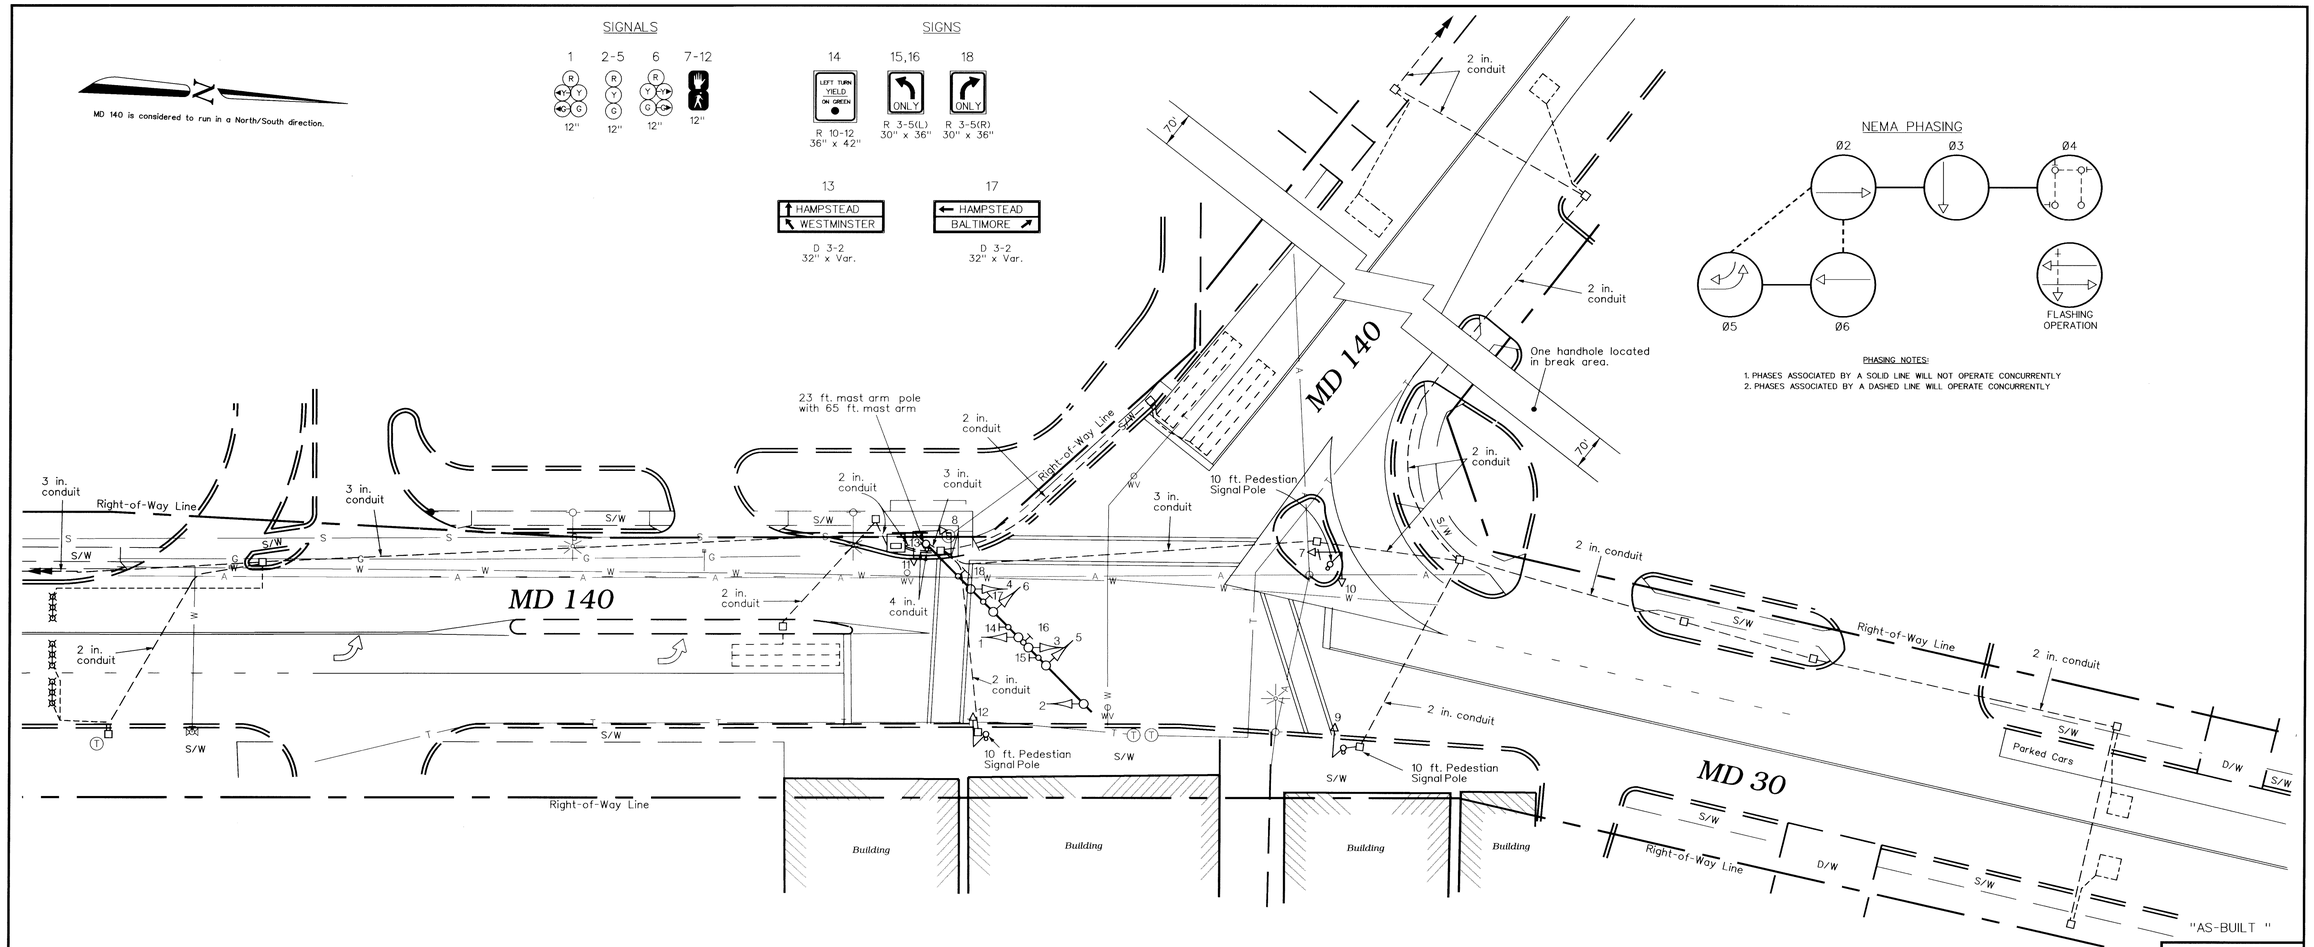

The Traffic Group

The Traffic Group, Inc.
Suite 600
40 W. Chesapeake Avenue
Towson, Maryland 21204
410-583-8405
1-800-583-8411
Fax 410-321-8458
Job No. 970830
ASBUILT.DGN

GEOMETRIC LEGEND

EXISTING GEOMETRICS

PROPOSED GEOMETRICS

UTILITY LEGEND

G	GAS MAIN
W	WATER MAIN
S	SEWER MAIN
E	ELECTRIC CABLES
D	STORM DRAIN
A	AERIAL CABLES
T	TELEPHONE CABLES

REVISIONS

© ASBUILT Febuary 22, 1999
S.H.A. No.:BW996MB2
FTH

APPROVALS

ASST. DIVISION CHIEF TRAFFIC ENGINEERING DESIGN DIVISION

CHIEF, TRAFFIC ENGINEERING DESIGN DIVISION

ASST. DISTRICT ENGINEER - TRAFFIC

DIRECTOR, OFFICE OF TRAFFIC & SAFETY

ORIGINAL ON FILE

MDOT – STATE HIGHWAY ADMINISTRATION
Office of Traffic & Safety
TRAFFIC ENGINEERING DESIGN DIVISION

DRAWN BY: W. Miller
DES. BY: R. Bitt
CHK. BY: A. Budnichuck

(Traffic Signal Plan)

MD 140 at MD 30

COUNTY: BALTIMORE
LOG MILE • 03003000.00

DATE: October 20, 1997
SCALE: 1" = 20'
F.A.P. NO. N/A
S.H.A. NO. B-333X-000-485
TS/STD. NO. 435E
SHEET NO. 1 of 1