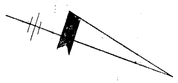

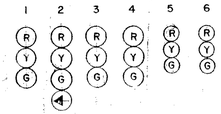

PHASE A	G	G	G	G	R	R	
A YELLOW	G	G	G	G	R	R	
A1 CLEAR	G	G	G	G	R	R	
A2 CLEAR	G	G	Y	Y	R	R	
PHASE B	G	G	R	R	R	R	
B YELLOW	Y	Y	R	R	R	R	
PHASE C1	R	R	R	R	G	G	
C1 YELLOW	R	R	R	R	G	G	
PHASE C	R	R	R	R	G	G	
C YELLOW	R	R	R	R	Y	Y	
FLASHING OPERATION	FL/Y	FL/Y	FL/Y	FL/Y	FL/R	FL/R	

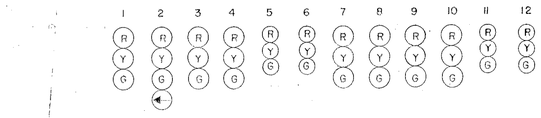

PHASE A	G	G	G	G	R	R	G	G	G	G	R	R
A YELLOW	G	G	G	G	R	R	Y	Y	G	G	R	R
A1 CLEAR	G	G	G	G	R	R	R	R	Y	Y	R	R
A2 CLEAR	G	G	Y	Y	R	R	R	R	R	R	R	R
PHASE B	G	G	R	R	R	R	R	R	R	R	G	G
B YELLOW	Y	Y	R	R	R	R	R	R	R	R	G	G
PHASE C1	R	R	R	R	G	G	R	R	R	R	G	G
C1 YELLOW	R	R	R	R	G	G	R	R	R	R	Y	Y
PHASE C	R	R	R	R	G	G	G	G	G	G	R	R
C YELLOW	R	R	R	R	Y	Y	G	G	G	G	R	R
FLASHING OPERATION	FL/Y	FL/Y	FL/Y	FL/Y	FL/R	FL/R	FL/Y	FL/Y	FL/Y	FL/Y	FL/R	FL/R

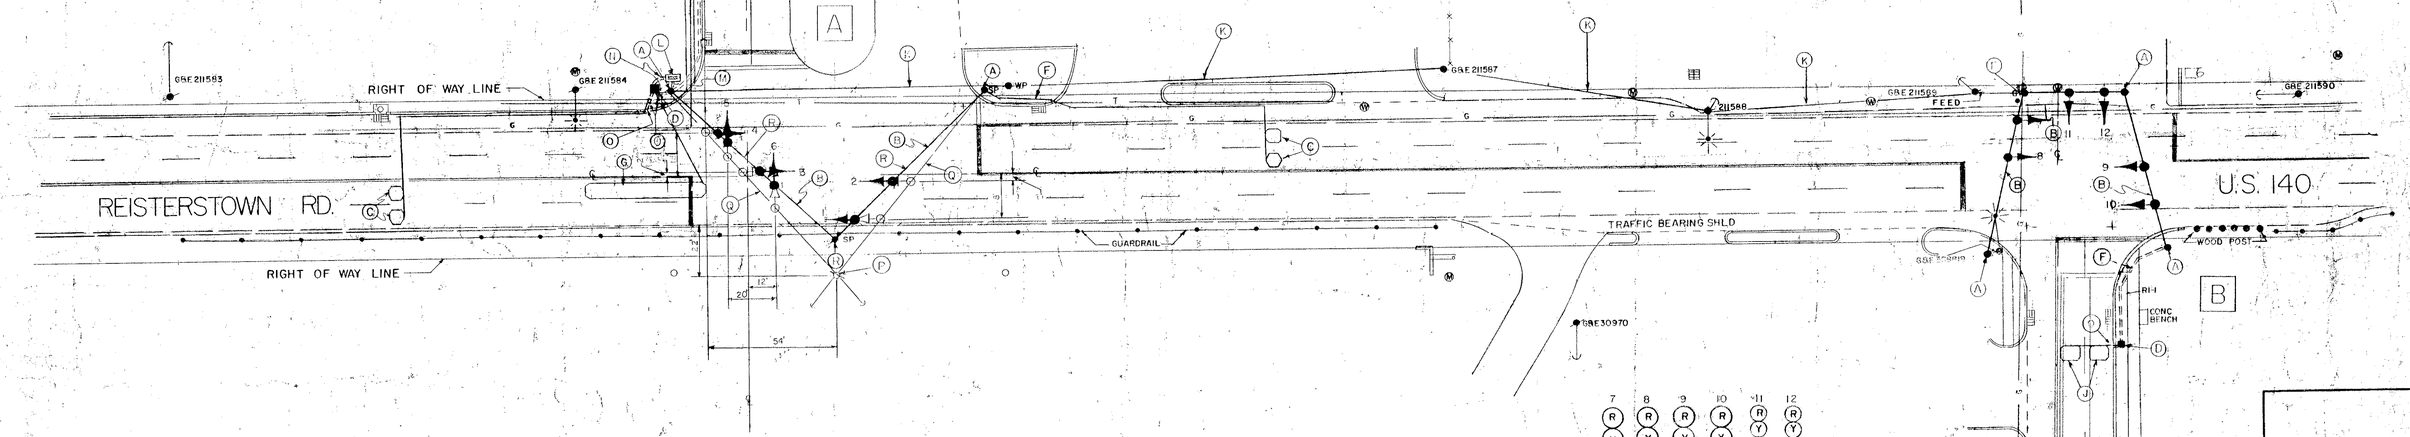

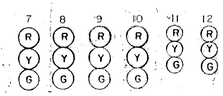

PHASE A	G	G	G	G	R	R	
A YELLOW	Y	Y	G	G	R	R	
A1 CLEAR	R	R	Y	Y	R	R	
A2 CLEAR	R	R	R	R	R	R	
PHASE B	R	R	R	R	G	G	
B YELLOW	R	R	R	R	G	G	
PHASE C1	R	R	R	R	G	G	
C1 YELLOW	R	R	R	R	Y	Y	
FLASHING OPERATION	FL/Y	FL/Y	FL/Y	FL/Y	FL/R	FL/R	

NOTE: SCALE 1" = 30'

LEGEND OF UNDERGROUND UTILITIES

G G	GAS MAIN
W W	WATER MAIN
S S	SEWER MAIN
E E	ELECTRIC CABLES
T T	TELEPHONE CABLES
A A	AERIAL CABLES

B	NOV. 14, 1972 AS BUILT
JG	
A	MAR 12, 1971 REVISED PHASE CHART'S AND LOOP DET. LOCATION

REVISIONS

APPROVAL: CHIEF - BUREAU OF TRAFFIC ENGINEERING

APPROVAL: ASS'T CHIEF ENGINEER TRAFFIC SAFETY

MARYLAND STATE ROADS COMMISSION
DIVISION OF TRAFFIC SAFETY
BUREAU OF TRAFFIC ENGINEERING

U.S. 140 - SOUTH TOLLGATE TO STRAWHAT RD.

SIGNAL NO'S A 03203 B 03237

DATE OCT 14, 1970 CONTRACT NO B-139X-475

SCALE 1" = 30' COUNTY BALTIMORE

DRAWN BY: W.F. fitch (JS) CHECKED BY: J. Spence

DRAWING NO. TS 148 B

TOLLGATE 03014005.68 STRAWHAT 03014005.68

DIETZGEN 10820