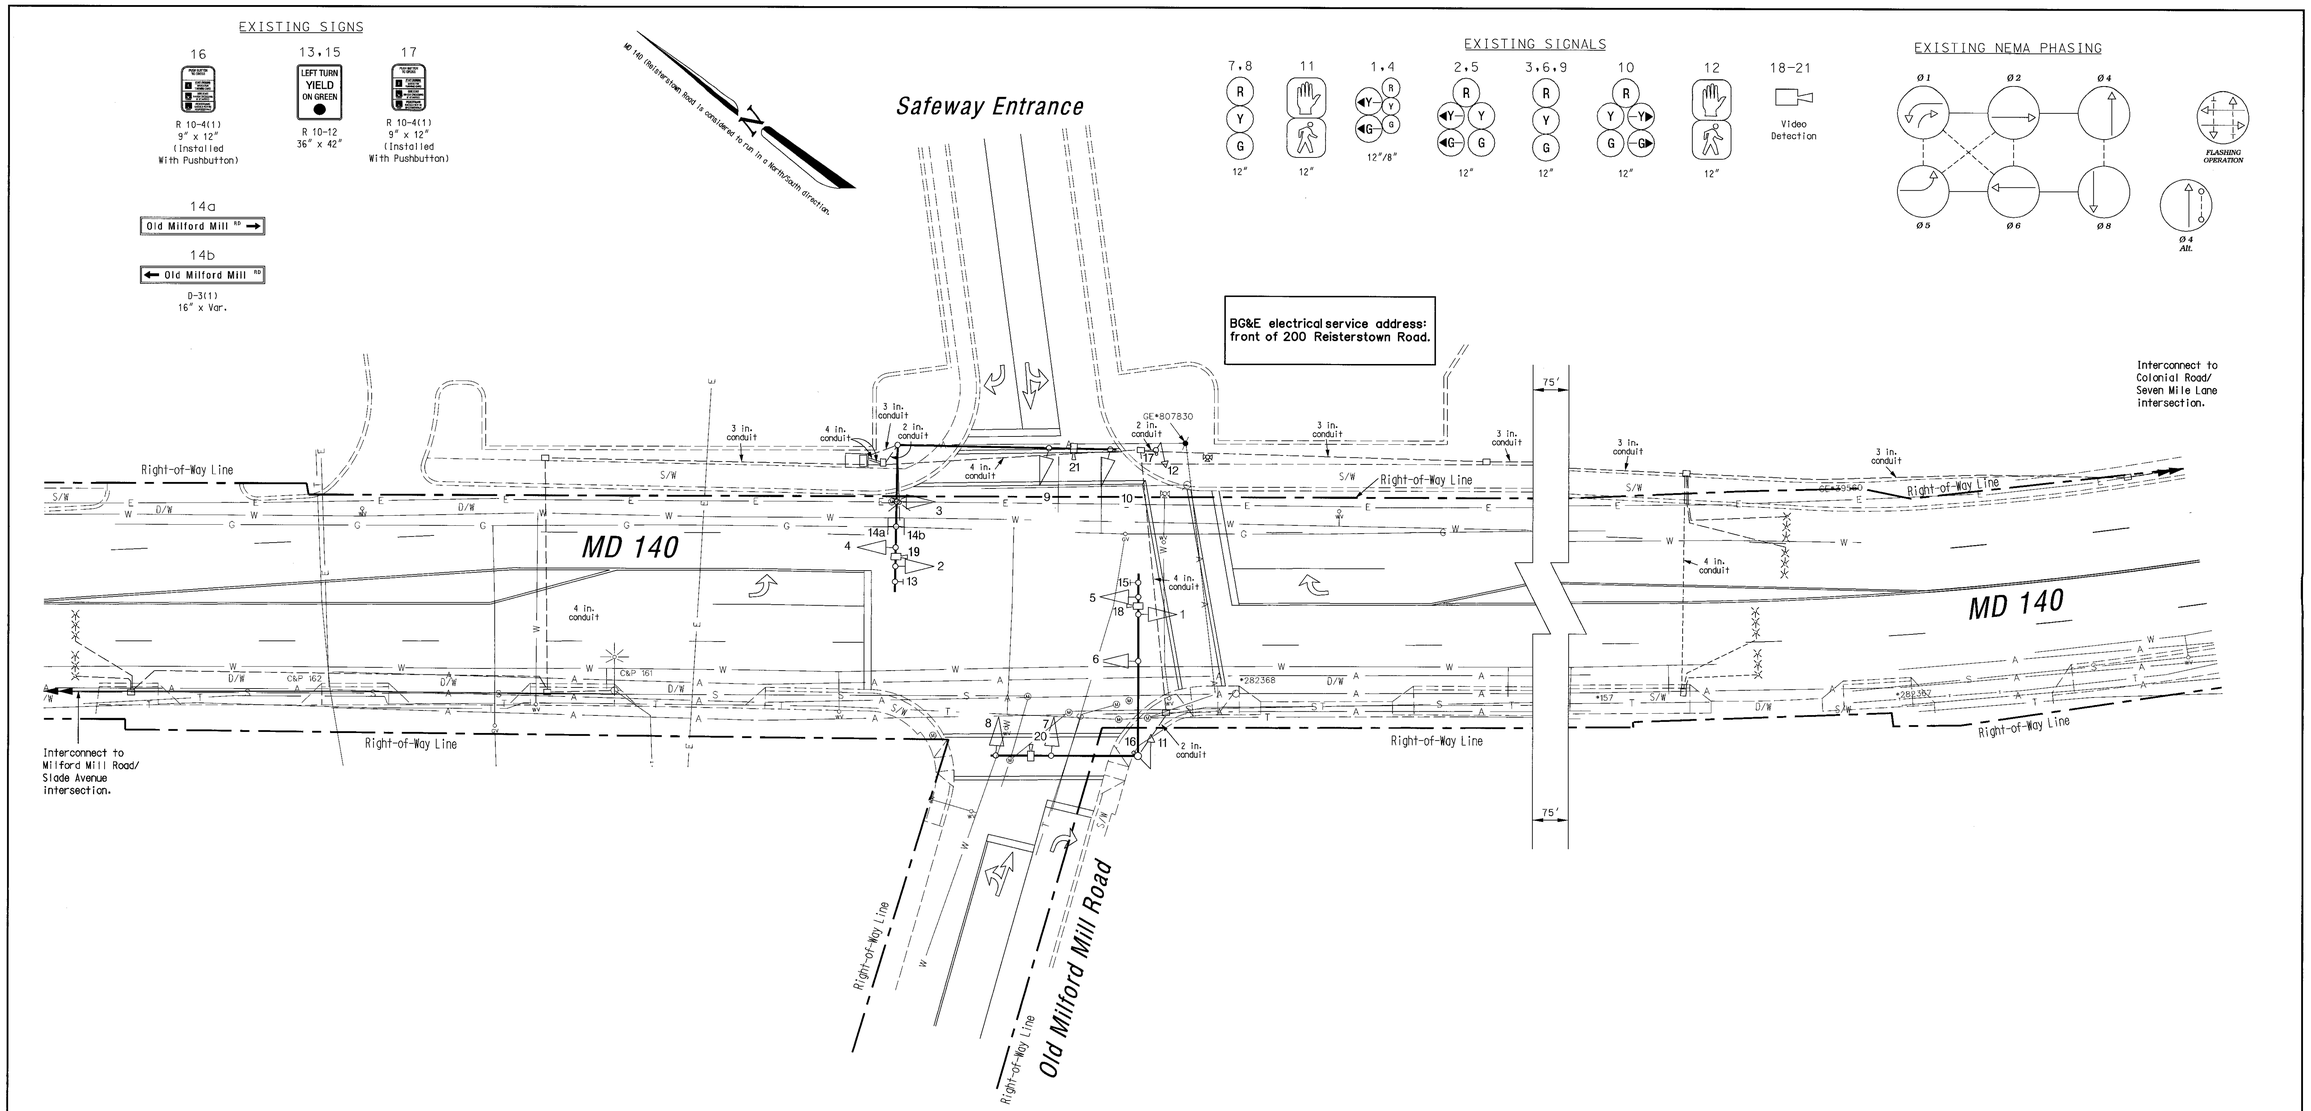

GEOMETRIC LEGEND

EXISTING GEOMETRICS

PROPOSED GEOMETRICS

UTILITY LEGEND

G	GAS MAIN
W	WATER MAIN
S	SEWER MAIN
E	ELECTRIC CABLES
D	STORM DRAIN
A	AERIAL CABLES
T	TELEPHONE CABLES

"As Built"

The Traffic Group

The Traffic Group, Inc.
410-931-6600
Fax 410-931-6601

REVISIONS

September 29, 2003
"As Built"
S.H.A. No.:BW996M82
rd

APPROVALS

ORIGINAL ON FILE

TEAM LEADER, TRAFFIC ENGINEERING DESIGN DIVISION

ASST. CHIEF TRAFFIC ENGINEERING DESIGN DIVISION

CHIEF, TRAFFIC ENGINEERING DESIGN DIVISION

DIRECTOR, TRAFFIC & SAFETY

MARYLAND DOT - STATE HIGHWAY ADMINISTRATION
Office of Traffic & Safety
TRAFFIC ENGINEERING DESIGN DIVISION
(Traffic Signal Plan)

MD 140 at Old Milford Mill Road/Safeway Entr.

DRAWN BY:	JES/FJH	F.A.P. NO.	N/A	TS NO. 3956-A	SHEET NO.
CHECKED BY:	M. Rucker	S.H.A. NO.	BA3035183		
SCALE:	1" = 20'	COUNTY:	Baltimore	T.I.M.S. NO. F169	1 OF 2
DATE:	December 2, 1999	LOG MILE:	03014000.19		

f:\2001\2001-1808\SES\ma-sub.dgn 10/13/2003