PHASING DIAGRAM

PHASING NOTES:

- PHASES ASSOCIATED BY A SOLID LINE WILL NOT OPERATE CONCURRENTLY.
- PHASES ASSOCIATED BY A DASHED LINE MAY/WILL OPERATE CONCURRENTLY.

GENERAL NOTES:

1. MARKING TO BE INSTALLED AS SHOWN ON DRAWING NO. TCP-7.
2. SIGNAL HEAD LOCATIONS SHALL BE ADJUSTED AS NECESSARY DURING CONSTRUCTION.
3. SEE DRAWING NO. SS-12 FOR WIRING DIAGRAM, PHASE CHART ADDITIONAL NOTES.
4. SIGNAL HEADS FOR RAMP C AND NORTHBOUND MD 140 SHALL BE FITTED WITH LOUVERS

SEE HOOKS LANE SIGNAL PLANS FOR INTERCONNECT INFORMATION

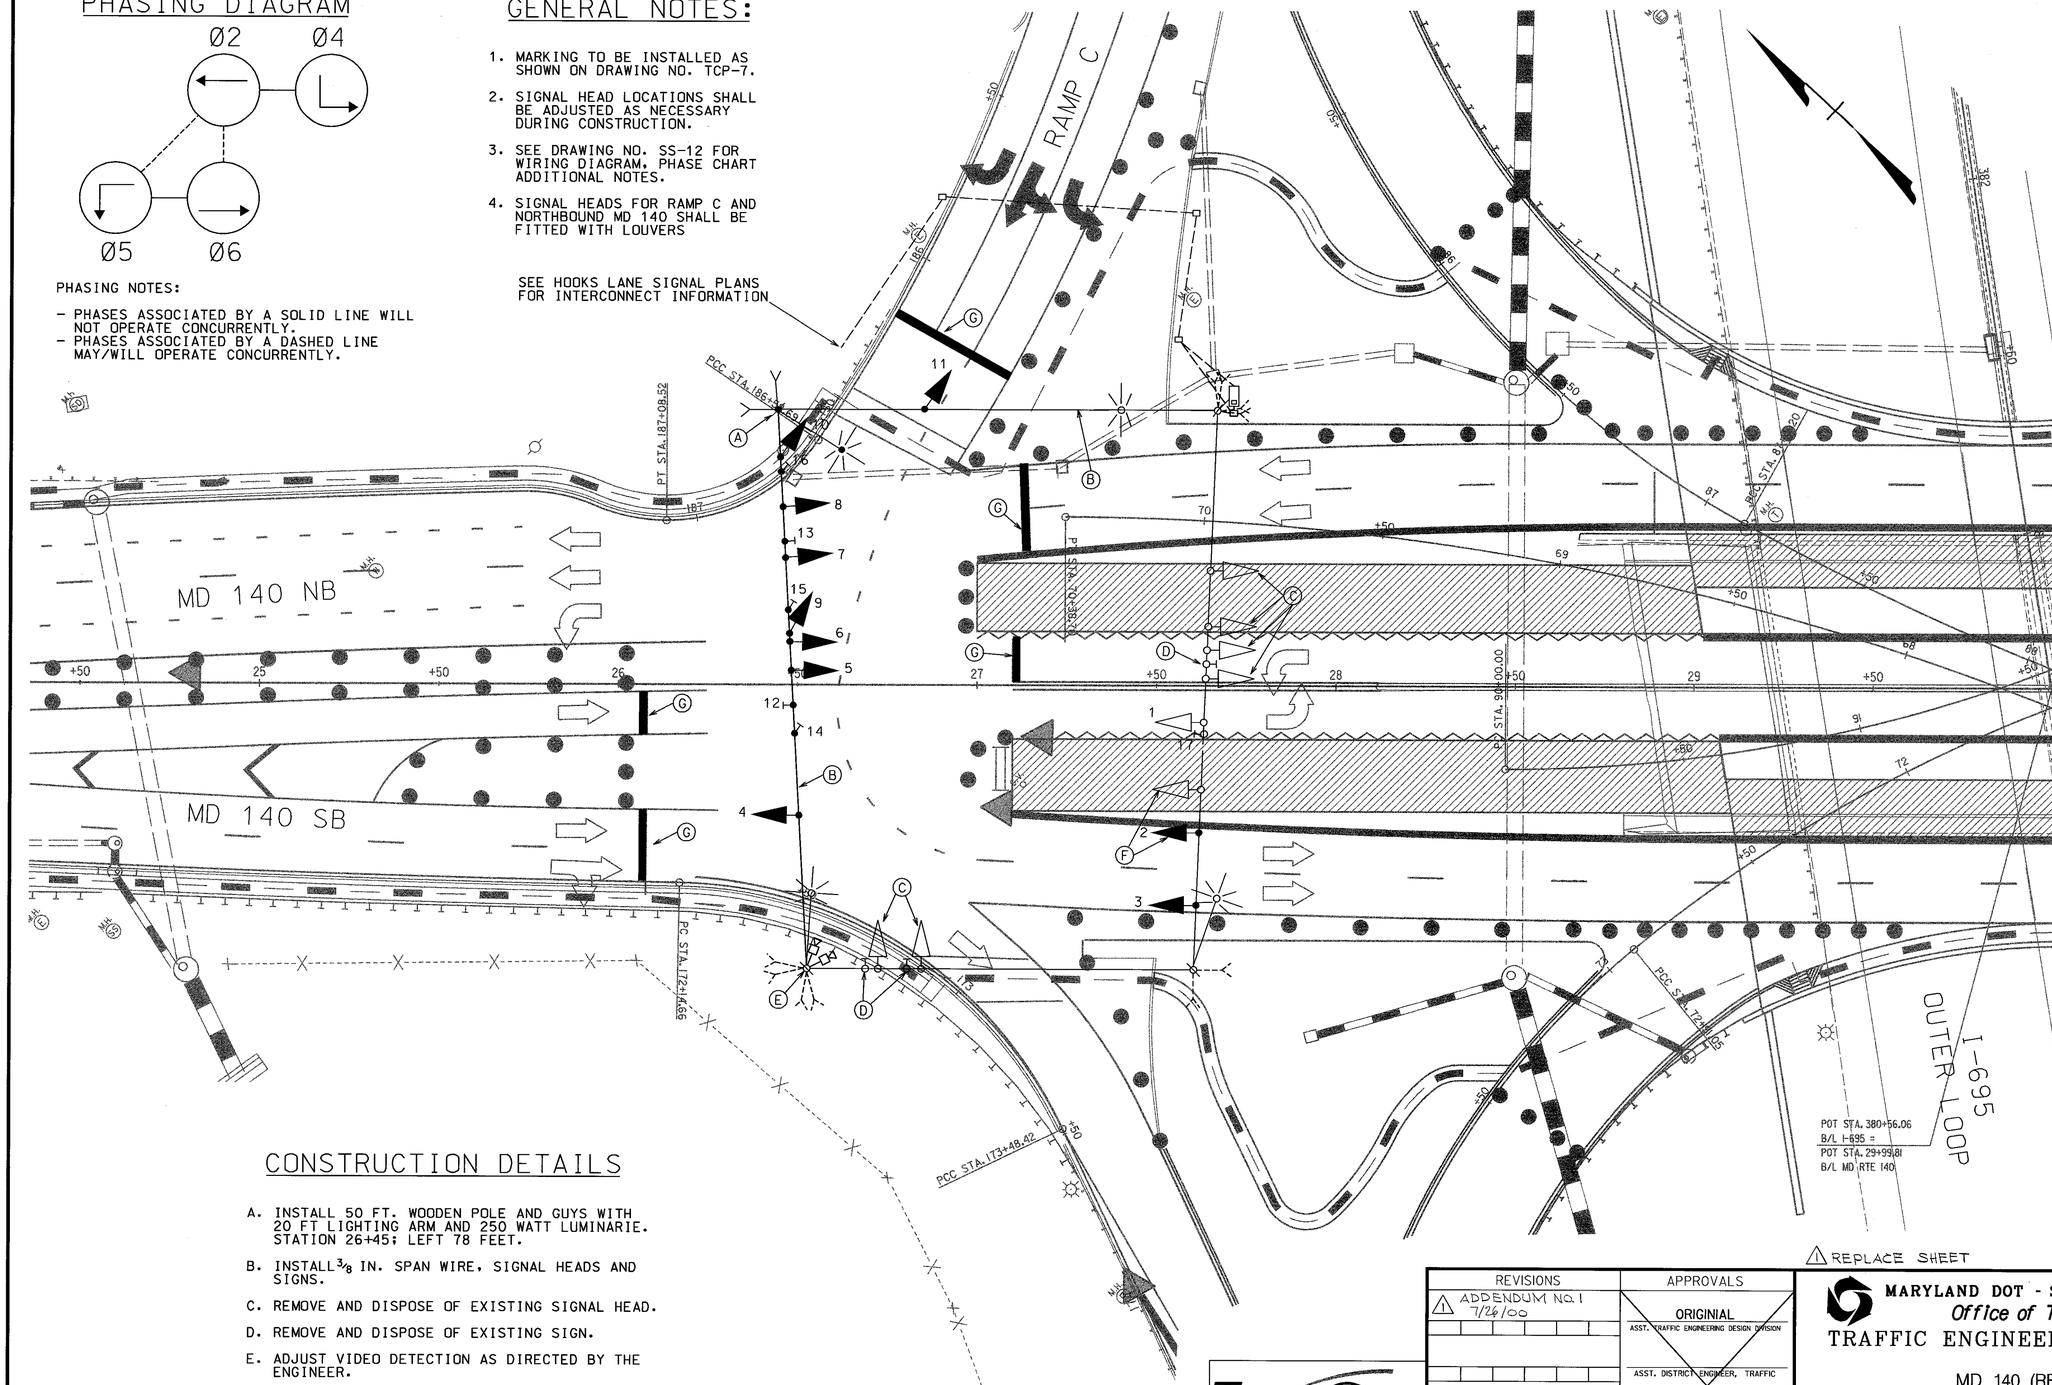

CONSTRUCTION DETAILS

A. INSTALL 50 FT. WOODEN POLE AND GUYS WITH 20 FT LIGHTING ARM AND 250 WATT LUMINARIE. STATION 26+45; LEFT 78 FEET.

B. INSTALL 3/8 IN. SPAN WIRE, SIGNAL HEADS AND SIGNS.

C. REMOVE AND DISPOSE OF EXISTING SIGNAL HEAD.

D. REMOVE AND DISPOSE OF EXISTING SIGN.

E. ADJUST VIDEO DETECTION AS DIRECTED BY THE ENGINEER.

F. RELOCATE SIGNAL HEAD.

G. INSTALL 24 IN. WHITE MARKING.

PROPOSED SIGNALS

12" R Y G — 3,4,7,8, 9,10,11

12" R Y G — 5,6

PROPOSED SIGNS

17 — NO TURNS — R3-3 24" x 24"

12 — ONLY — R3-5T 30" x 36"

14 — ONLY — R3-5 30" x 36"

15 — R3-6 30" x 36"

16 — NO TURN ON RED — R10-11B 24" x 24"

EXISTING SIGNALS

12" R Y G — 1,2

STAGE 4

TO BE USED FOR TRAFFIC CONTROL PLAN PHASE 3

SCALE 1" : 20'

0 10 20 30 40

⚠ REPLACE SHEET

DWG NO. SS-10

TRANSCORE
6850 Versar Center, Suite 350
Springfield Virginia 22151
Phone: 703-658-4088

REVISIONS					
⚠ ADDENDUM NO. 1 7/26/00					
Ⓑ 5-2000 CONSTRUCT TEMP. SIGNAL FOR BRIDGE RECONSTRUCTION					
	6-10-92				
Ⓐ REBUILD SIGNAL AND ADD I/C SHA NO: B-965-501-485					
RR2	EMM		DA2	ETP	TH

APPROVALS

ORIGINAL — ASST. TRAFFIC ENGINEERING DESIGN DIVISION

ASST. DISTRICT ENGINEER, TRAFFIC

ON FILE — CHIEF, TRAFFIC ENGINEERING DESIGN DIVISION

DIRECTOR, TRAFFIC & SAFETY

MARYLAND DOT - STATE HIGHWAY ADMINISTRATION
Office of Traffic & Safety
TRAFFIC ENGINEERING DESIGN DIVISION

MD 140 (REISTERSTOWN ROAD) AND I-695 (OUTER LOOP)

DRAWN BY: RICHARDSON	F.A.P. NO.	TS NO. 936 B - X4	SHEET NO.
CHECKED BY:	S.H.A. NO.		
SCALE: 1"=20'	COUNTY:	T.I.M.S. NO. D-115	202 OF 256
DATE: 6-6-73	LOG MILE: 03014001.90		