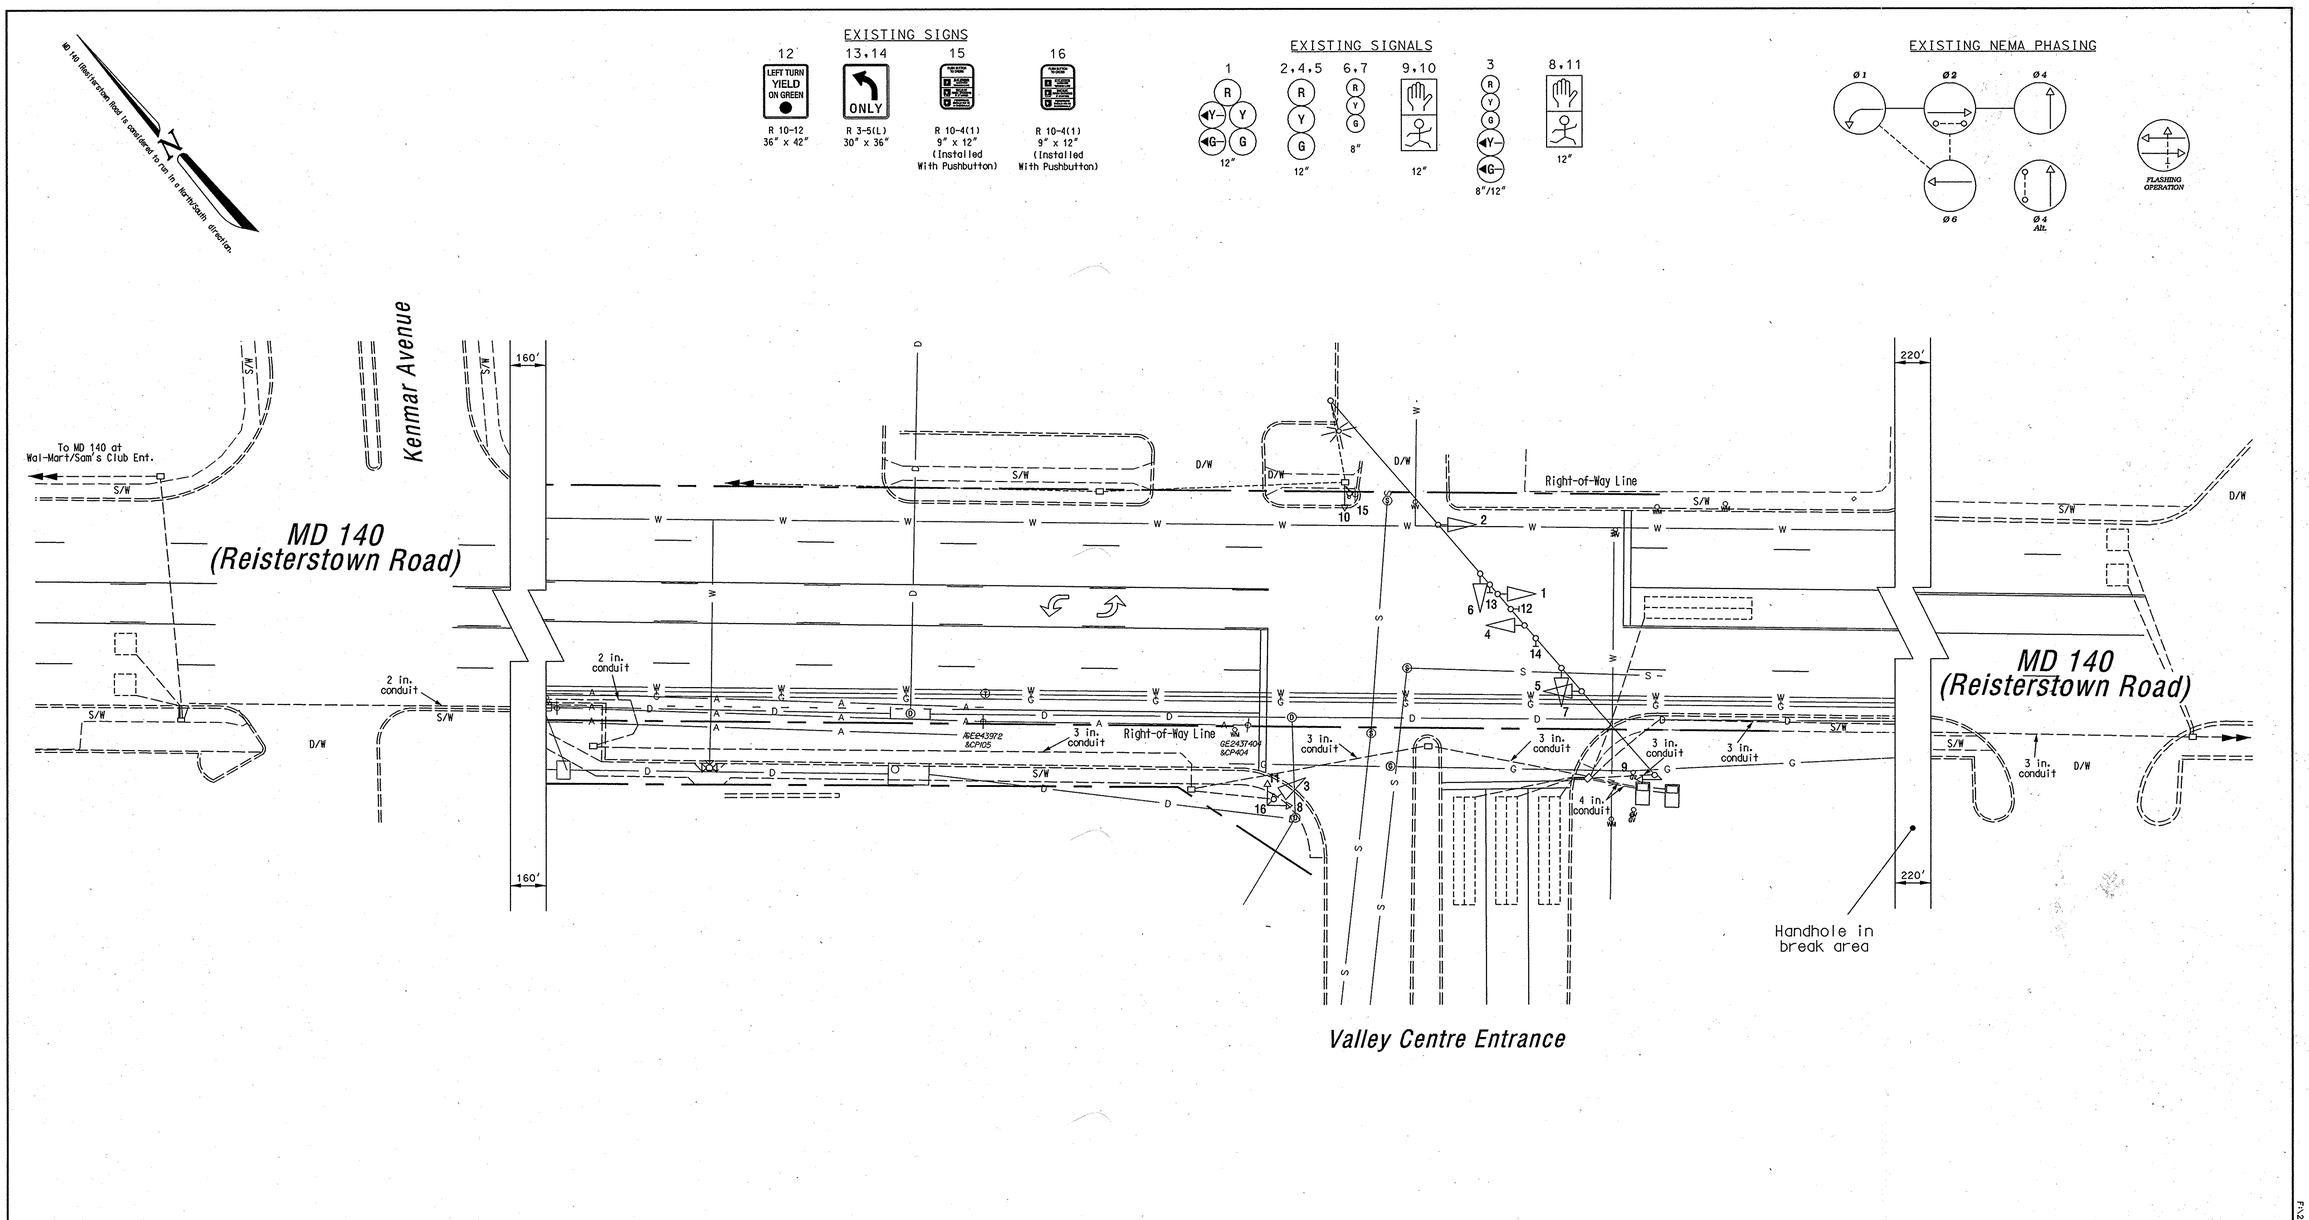

GEOMETRIC LEGEND

EXISTING GEOMETRICS

PROPOSED GEOMETRICS

UTILITY LEGEND

G	GAS MAIN
W	WATER MAIN
S	SEWER MAIN
E	ELECTRIC CABLES
D	STORM DRAIN
A	AERIAL CABLES
T	TELEPHONE CABLES

"As Built"

The Traffic Group

The Traffic Group, Inc.
410-931-6600
Fax 410-931-6601

REVISIONS

May 22, 2003

"As Built"
S.H.A. No.:BW996M82

APPROVALS

TEAM LEADER, TRAFFIC ENGINEERING DESIGN DIVISION

ASST. CHIEF TRAFFIC ENGINEERING DESIGN DIVISION

CHIEF, TRAFFIC ENGINEERING DESIGN DIVISION

DIRECTOR, TRAFFIC & SAFETY

ORIGINAL ON FILE

MARYLAND DOT - STATE HIGHWAY ADMINISTRATION

Office of Traffic & Safety

TRAFFIC ENGINEERING DESIGN DIVISION

(Traffic Signal Plan)

MD 140 (Reisterstown Rd.) at Valley Centre Entr.

DRAWN BY:	JWG	F.A.P. NO.	N/A	TS NO. 2103-B	SHEET NO.
CHECKED BY:	DJD	S.H.A. NO.	BW-855-801-412		
SCALE:	1" = 20'	COUNTY:	Baltimore	T.I.M.S. NO. E-779	1 OF 1
DATE:	August 6, 1986	LOG MILE:			

F:\2000\2000-0925a\Des\asbuilt2.dgn 5/28/2003