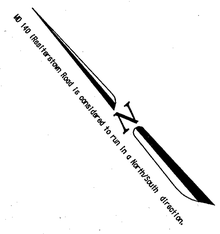

EXISTING SIGNS

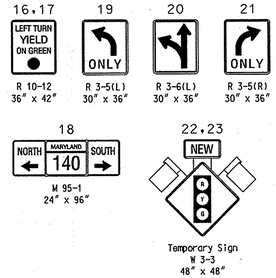

EXISTING SIGNALS

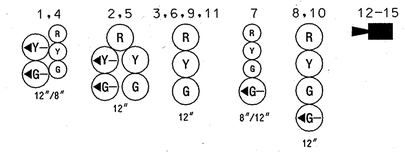

EXISTING NEMA PHASING

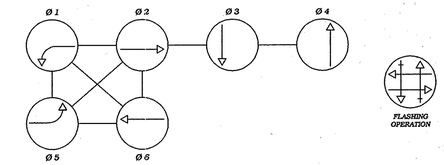

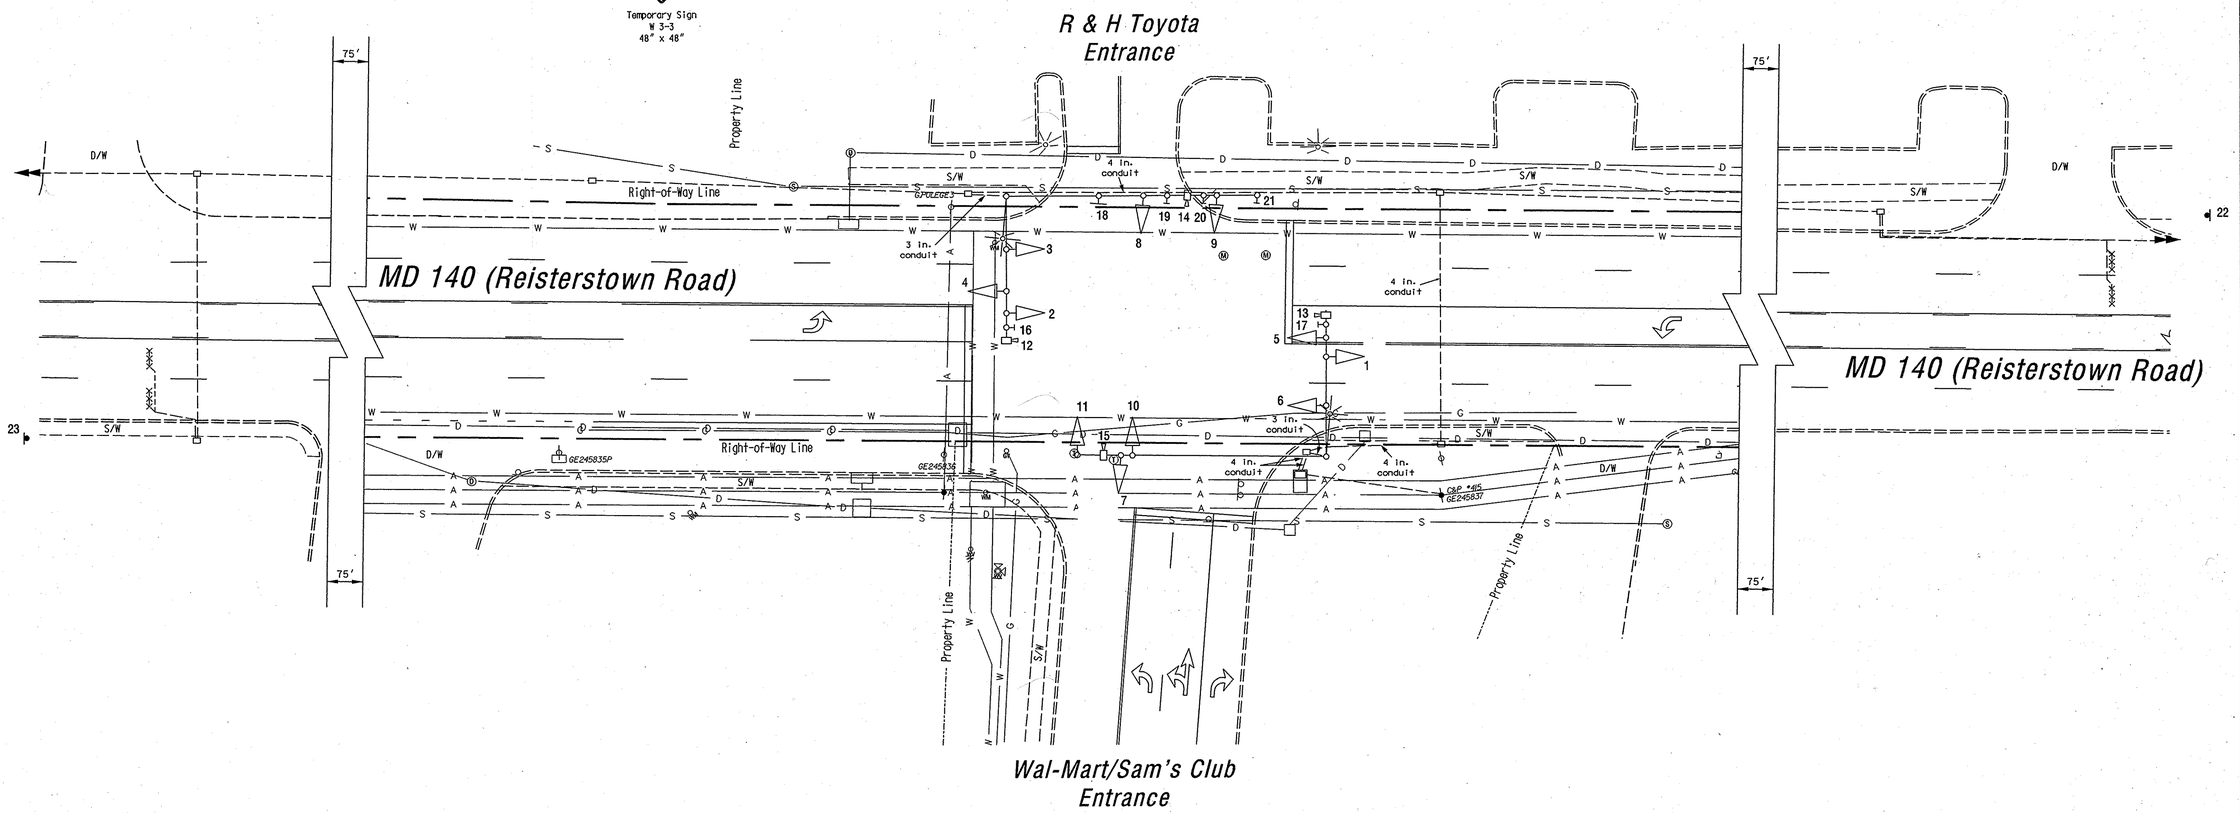

GEOMETRIC LEGEND

EXISTING GEOMETRICS
PROPOSED GEOMETRICS

UTILITY LEGEND

G	GAS MAIN
W	WATER MAIN
S	SEWER MAIN
E	ELECTRIC CABLES
D	STORM DRAIN
A	AERIAL CABLES
T	TELEPHONE CABLES

"As Built"

The Traffic Group

The Traffic Group, Inc.
410-931-6600
Fax 410-931-6601

REVISIONS

"As Built"
S.H.A. No. BW996M82
May 22, 2003
rmd

APPROVALS

TEAM LEADER, TRAFFIC ENGINEERING DESIGN DIVISION
ASST. CHIEF TRAFFIC ENGINEERING DESIGN DIVISION
CHIEF, TRAFFIC ENGINEERING DESIGN DIVISION
DIRECTOR, TRAFFIC & SAFETY

ORIGINAL ON FILE

MARYLAND DOT - STATE HIGHWAY ADMINISTRATION
Office of Traffic & Safety
TRAFFIC ENGINEERING DESIGN DIVISION
(Traffic Signal Plan)

MD 140 (Reisterstown Rd.) at Wal-Mart/Sam's Club Entr.

DRAWN BY:	F. Brownley	F.A.P. NO.	N/A	TS NO. 4149	SHEET NO.
CHECKED BY:		S.H.A. NO.	BW996M82		
SCALE:	1" = 20'	COUNTY:	Baltimore	T.I.M.S. NO. E-779	1 OF 1
DATE:	January 7, 2002	LOG MILE:			

F:\2000\2000-09250\Das\asbuilt.dgn 6/26/2003