F H WA REGION NO	STATE	FED. AID PROJ. NO	SHEET NO.	TOTAL SHEETS
3	MD.			

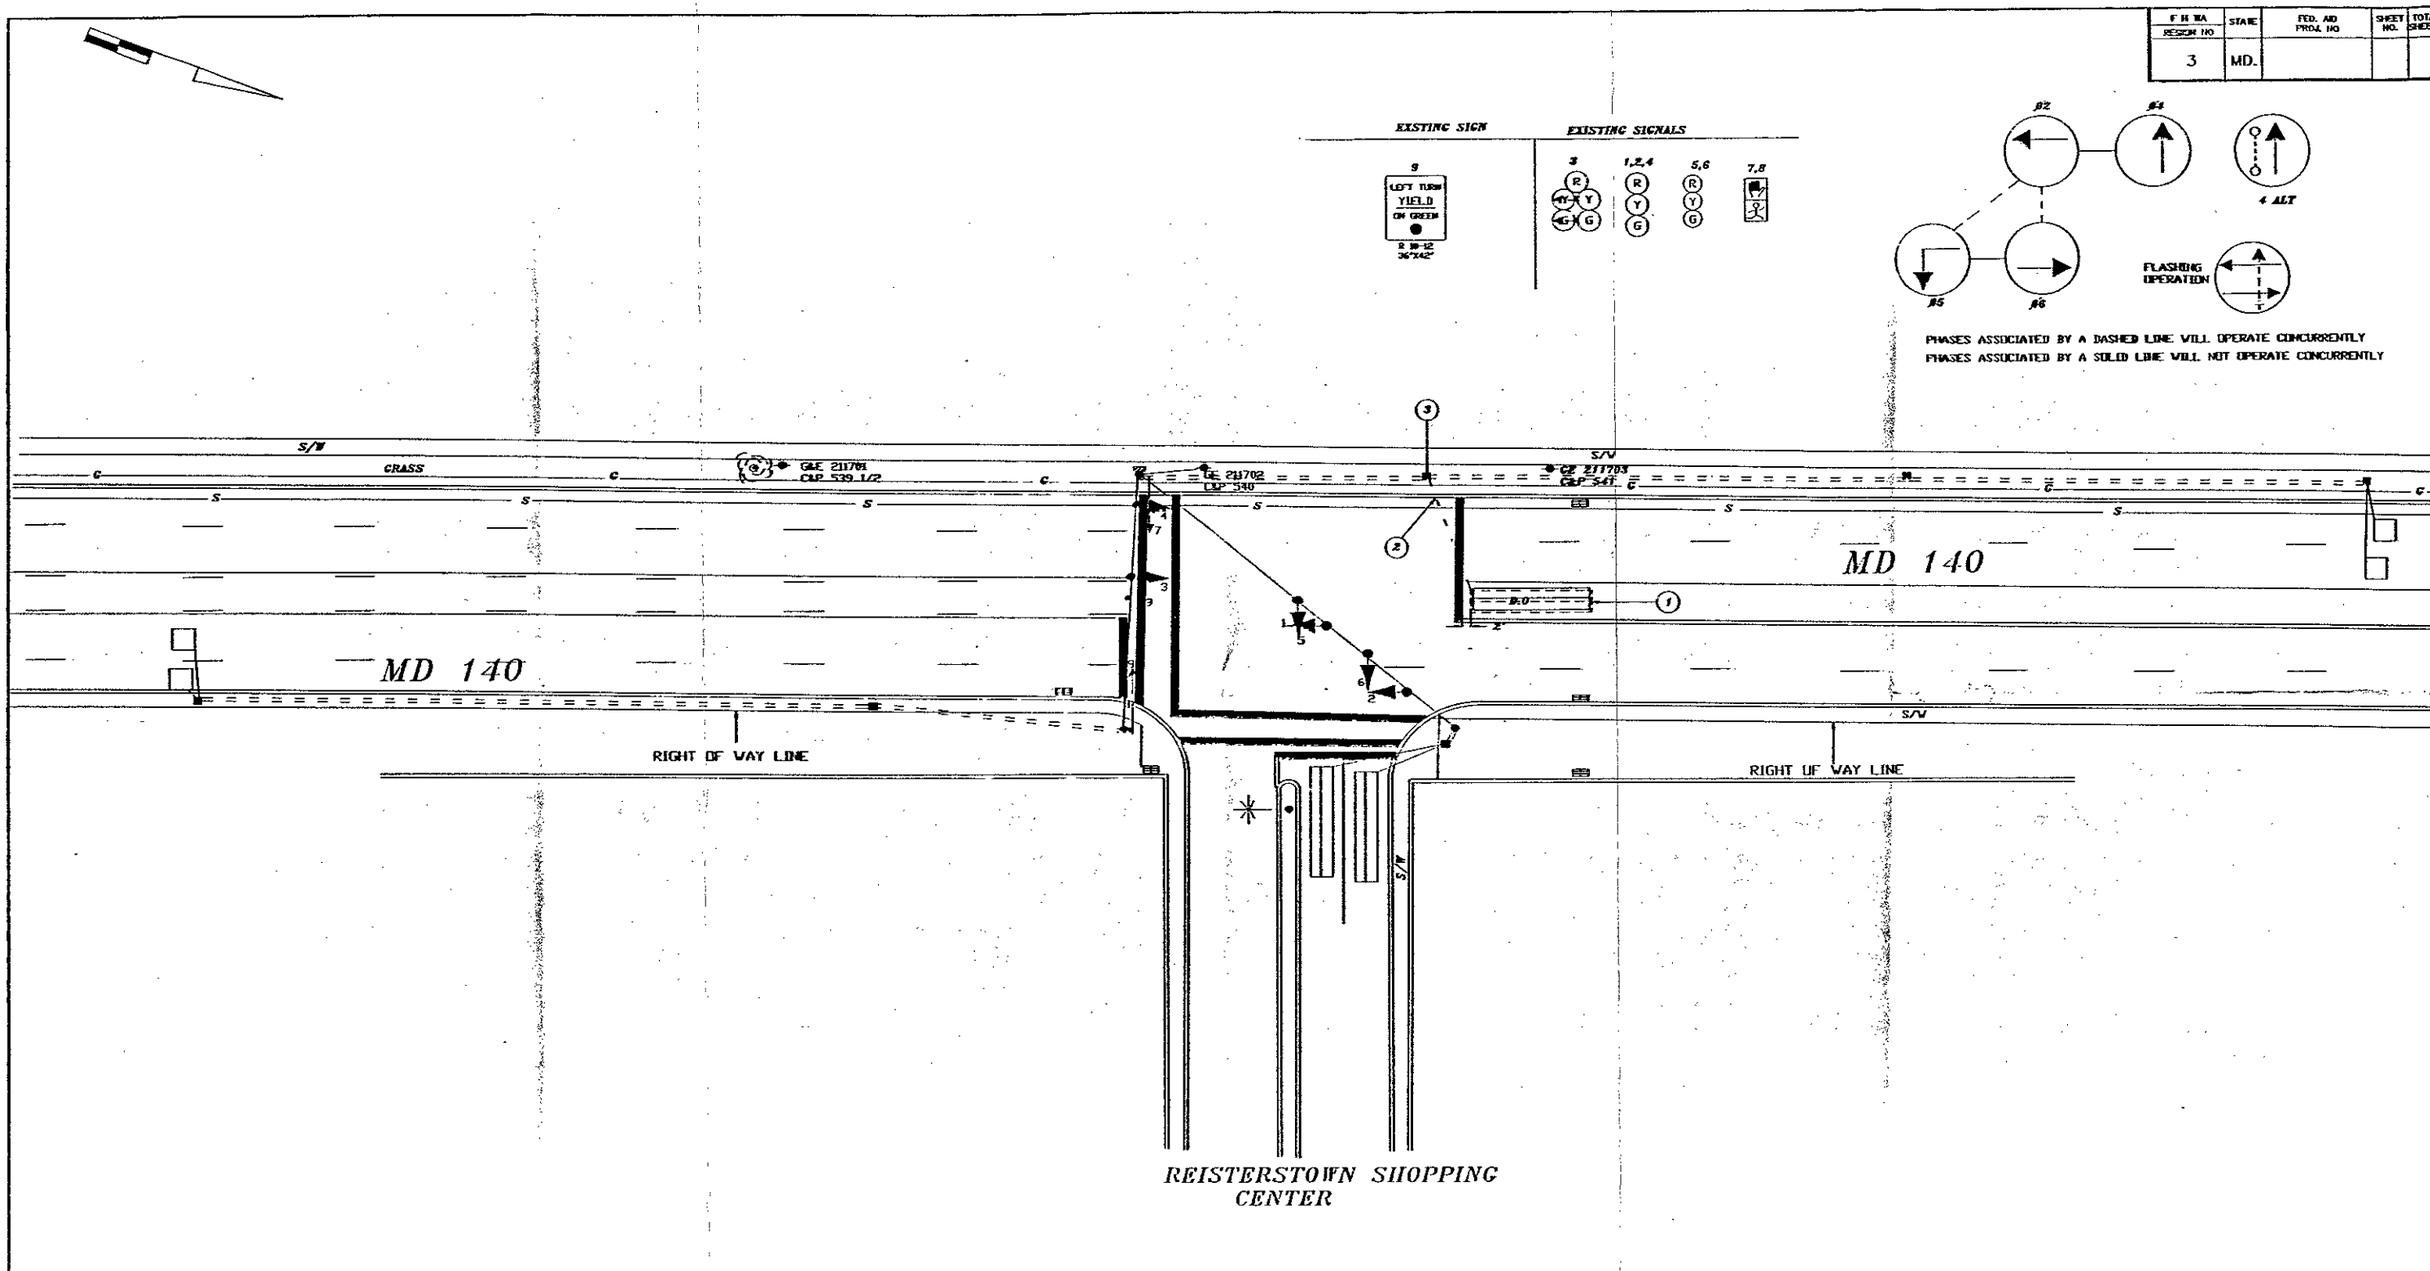

UTILITY LEGEND

G — G	GAS MAIN
W — W	WATER MAIN
S — S	SEWER MAIN
E — E	ELECTRIC CABLES
A — A	AERIAL CABLES
T — T	TELEPHONE CABLES

REVISIONS	APPROVALS
	ORIGINAL
	CHIEF, SIGNAL DESIGN SECTION ON
	ASST. DISTRICT ENGINEER, TRAFFIC
	CHIEF, TRAFFIC ENGINEERING DIVISION FILE
	DEPUTY CHIEF ENGINEER, OFFICE OF TRAFFIC

REDRAWN 3/31 REPLACE LEFT TURN LOOP DETECTOR FOR SB MD 140 TS-2347

9/19/85 REBUILD TRAFFIC SIGNAL SHA NO. B-812-501-485 WJR

MDOT – STATE HIGHWAY ADMINISTRATION
Office of Traffic
TRAFFIC ENGINEERING DIVISION SIGNAL #

DRAWN BY: J GORDON
DES. BY:
CHK. BY:

MD 140 AND ENT. TO REISTERSTOWN SHOPPING CENTER

COUNTY: BALTIMORE

DATE: 6/11/73 F.A.P. NO.
SCALE: 1" = 20" S.H.A. NO.

TS/STD. NO. TS-943 (B)

SHEET NO. ___ OF ___