F H WA REGION NO	STATE	FED. AID PROJ. NO	SHEET NO.	TOTAL SHEETS
3				

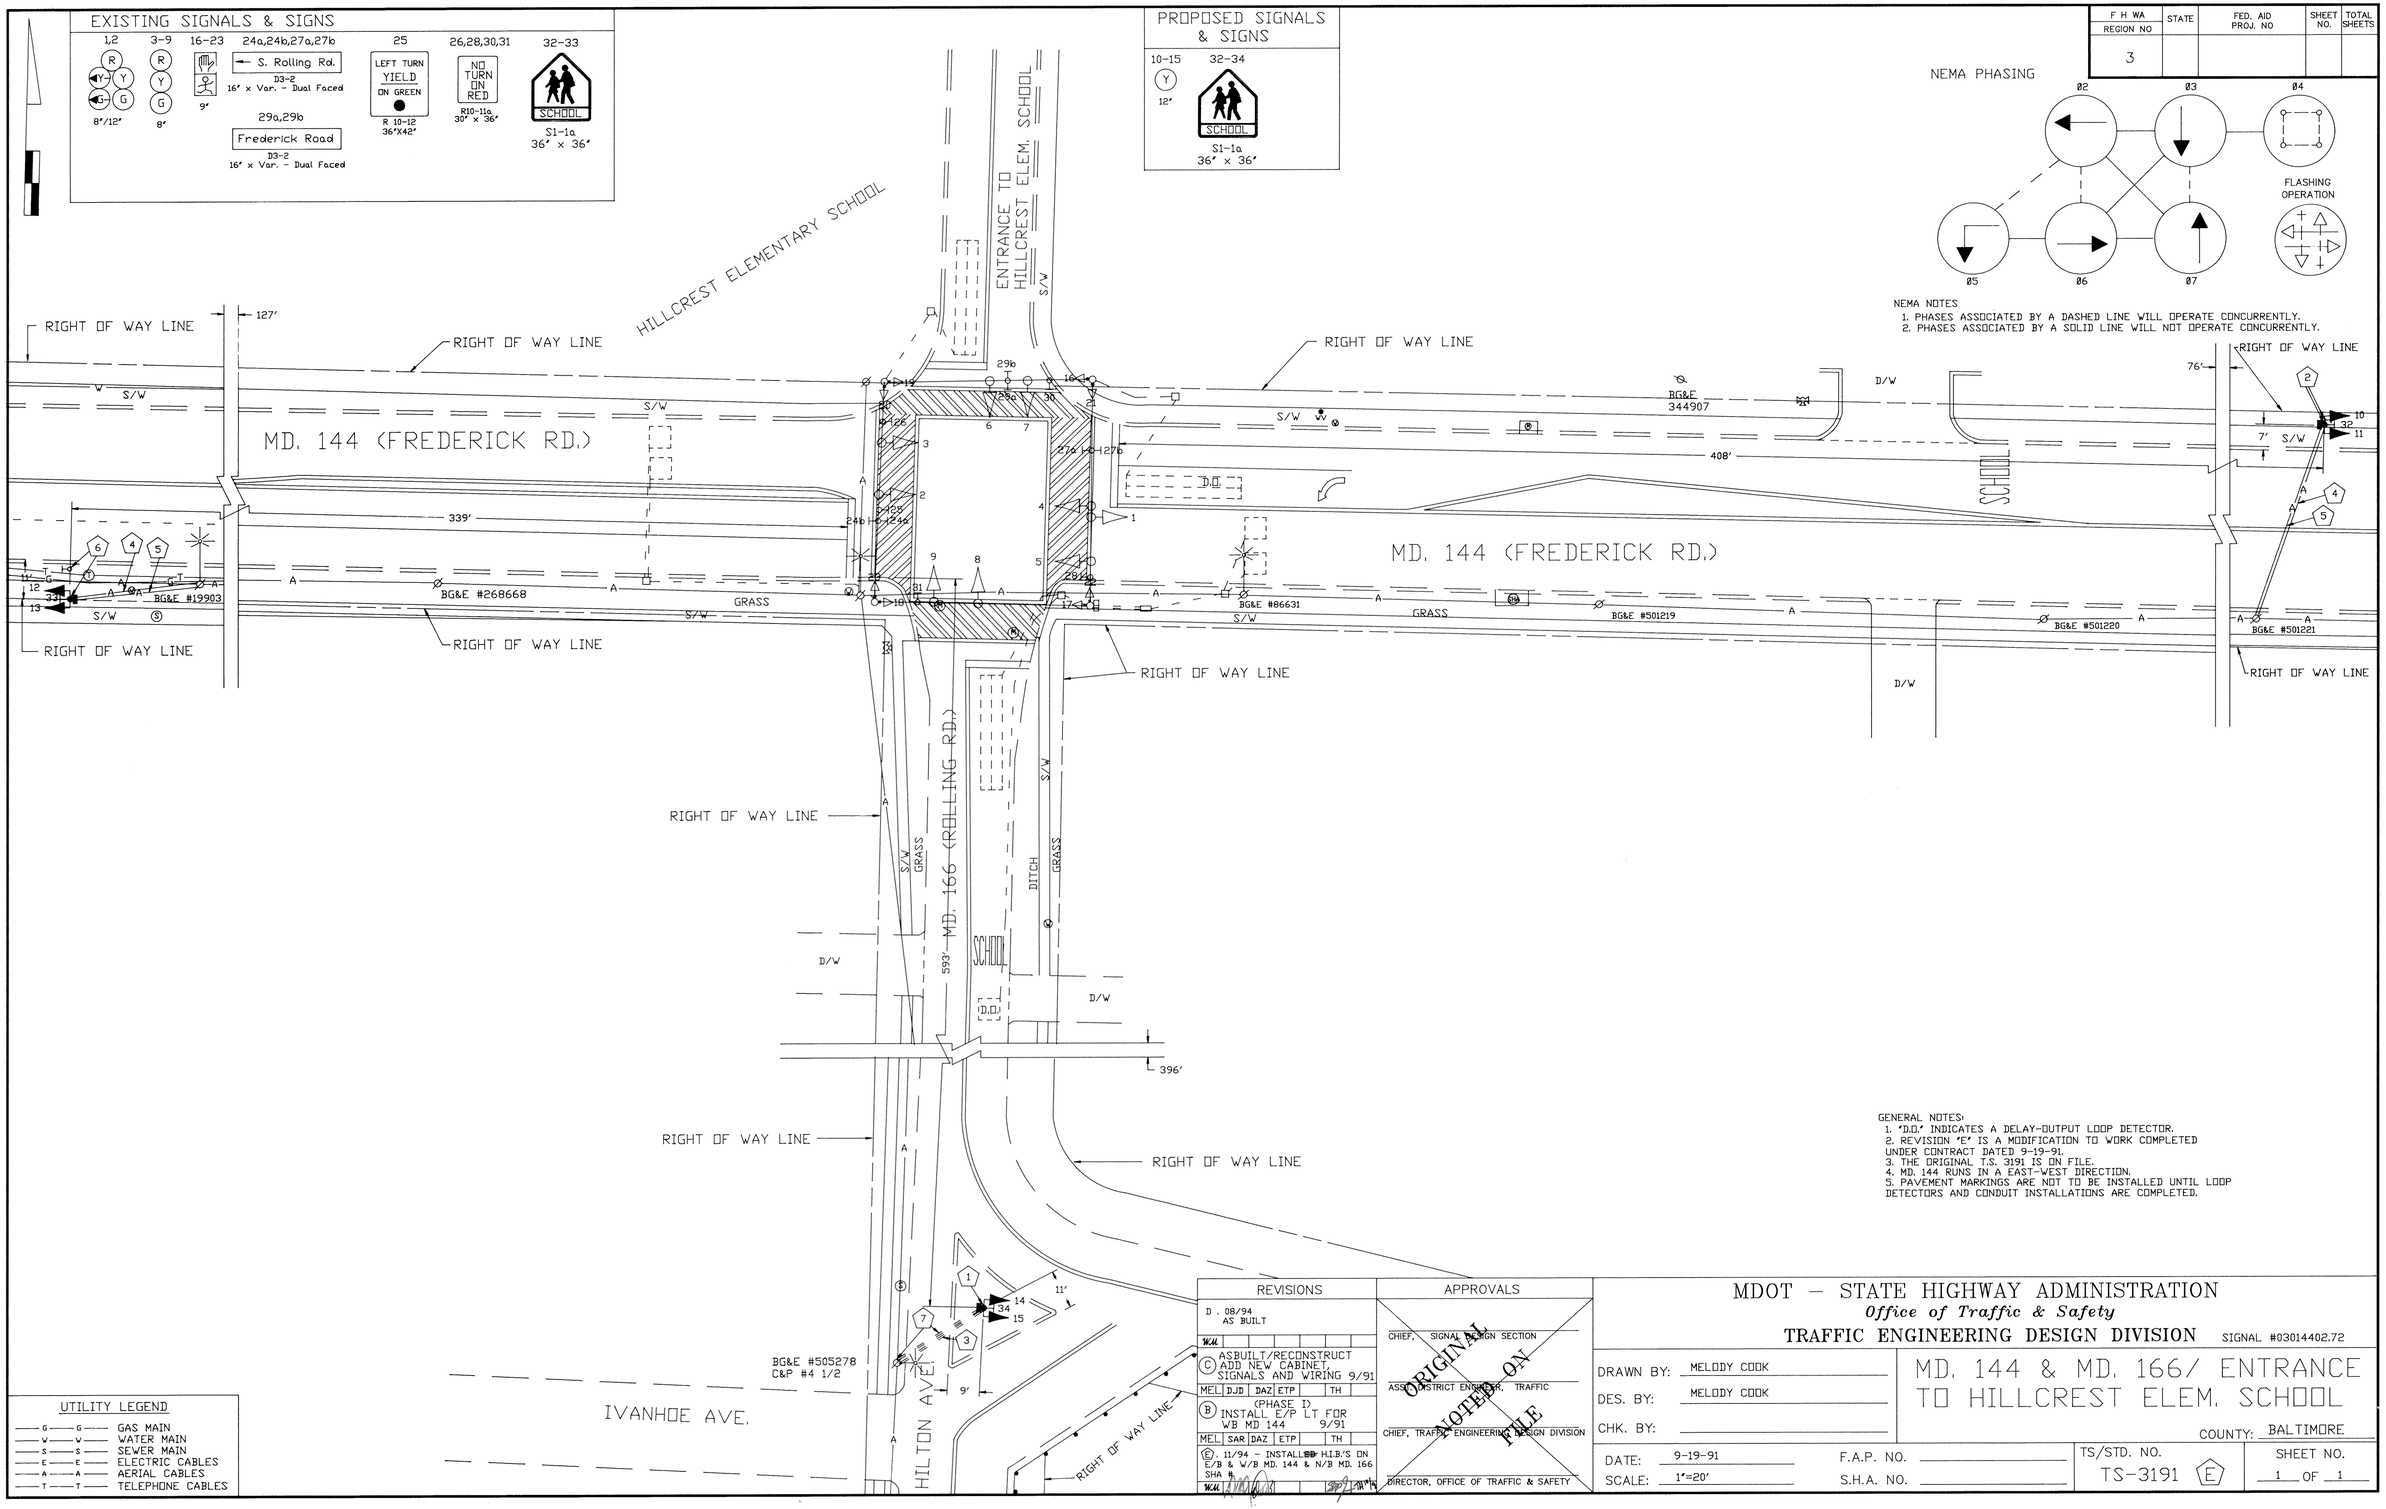

MDOT – STATE HIGHWAY ADMINISTRATION
Office of Traffic & Safety
TRAFFIC ENGINEERING DESIGN DIVISION SIGNAL #03014402.72

DRAWN BY: MELODY COOK
DES. BY: MELODY COOK
CHK. BY:

MD. 144 & MD. 166/ ENTRANCE TO HILLCREST ELEM. SCHOOL

COUNTY: BALTIMORE

DATE: 9-19-91
SCALE: 1"=20'
F.A.P. NO.
S.H.A. NO.
TS/STD. NO. TS-3191 (E)
SHEET NO. 1 OF 1

F#16

03014402.72