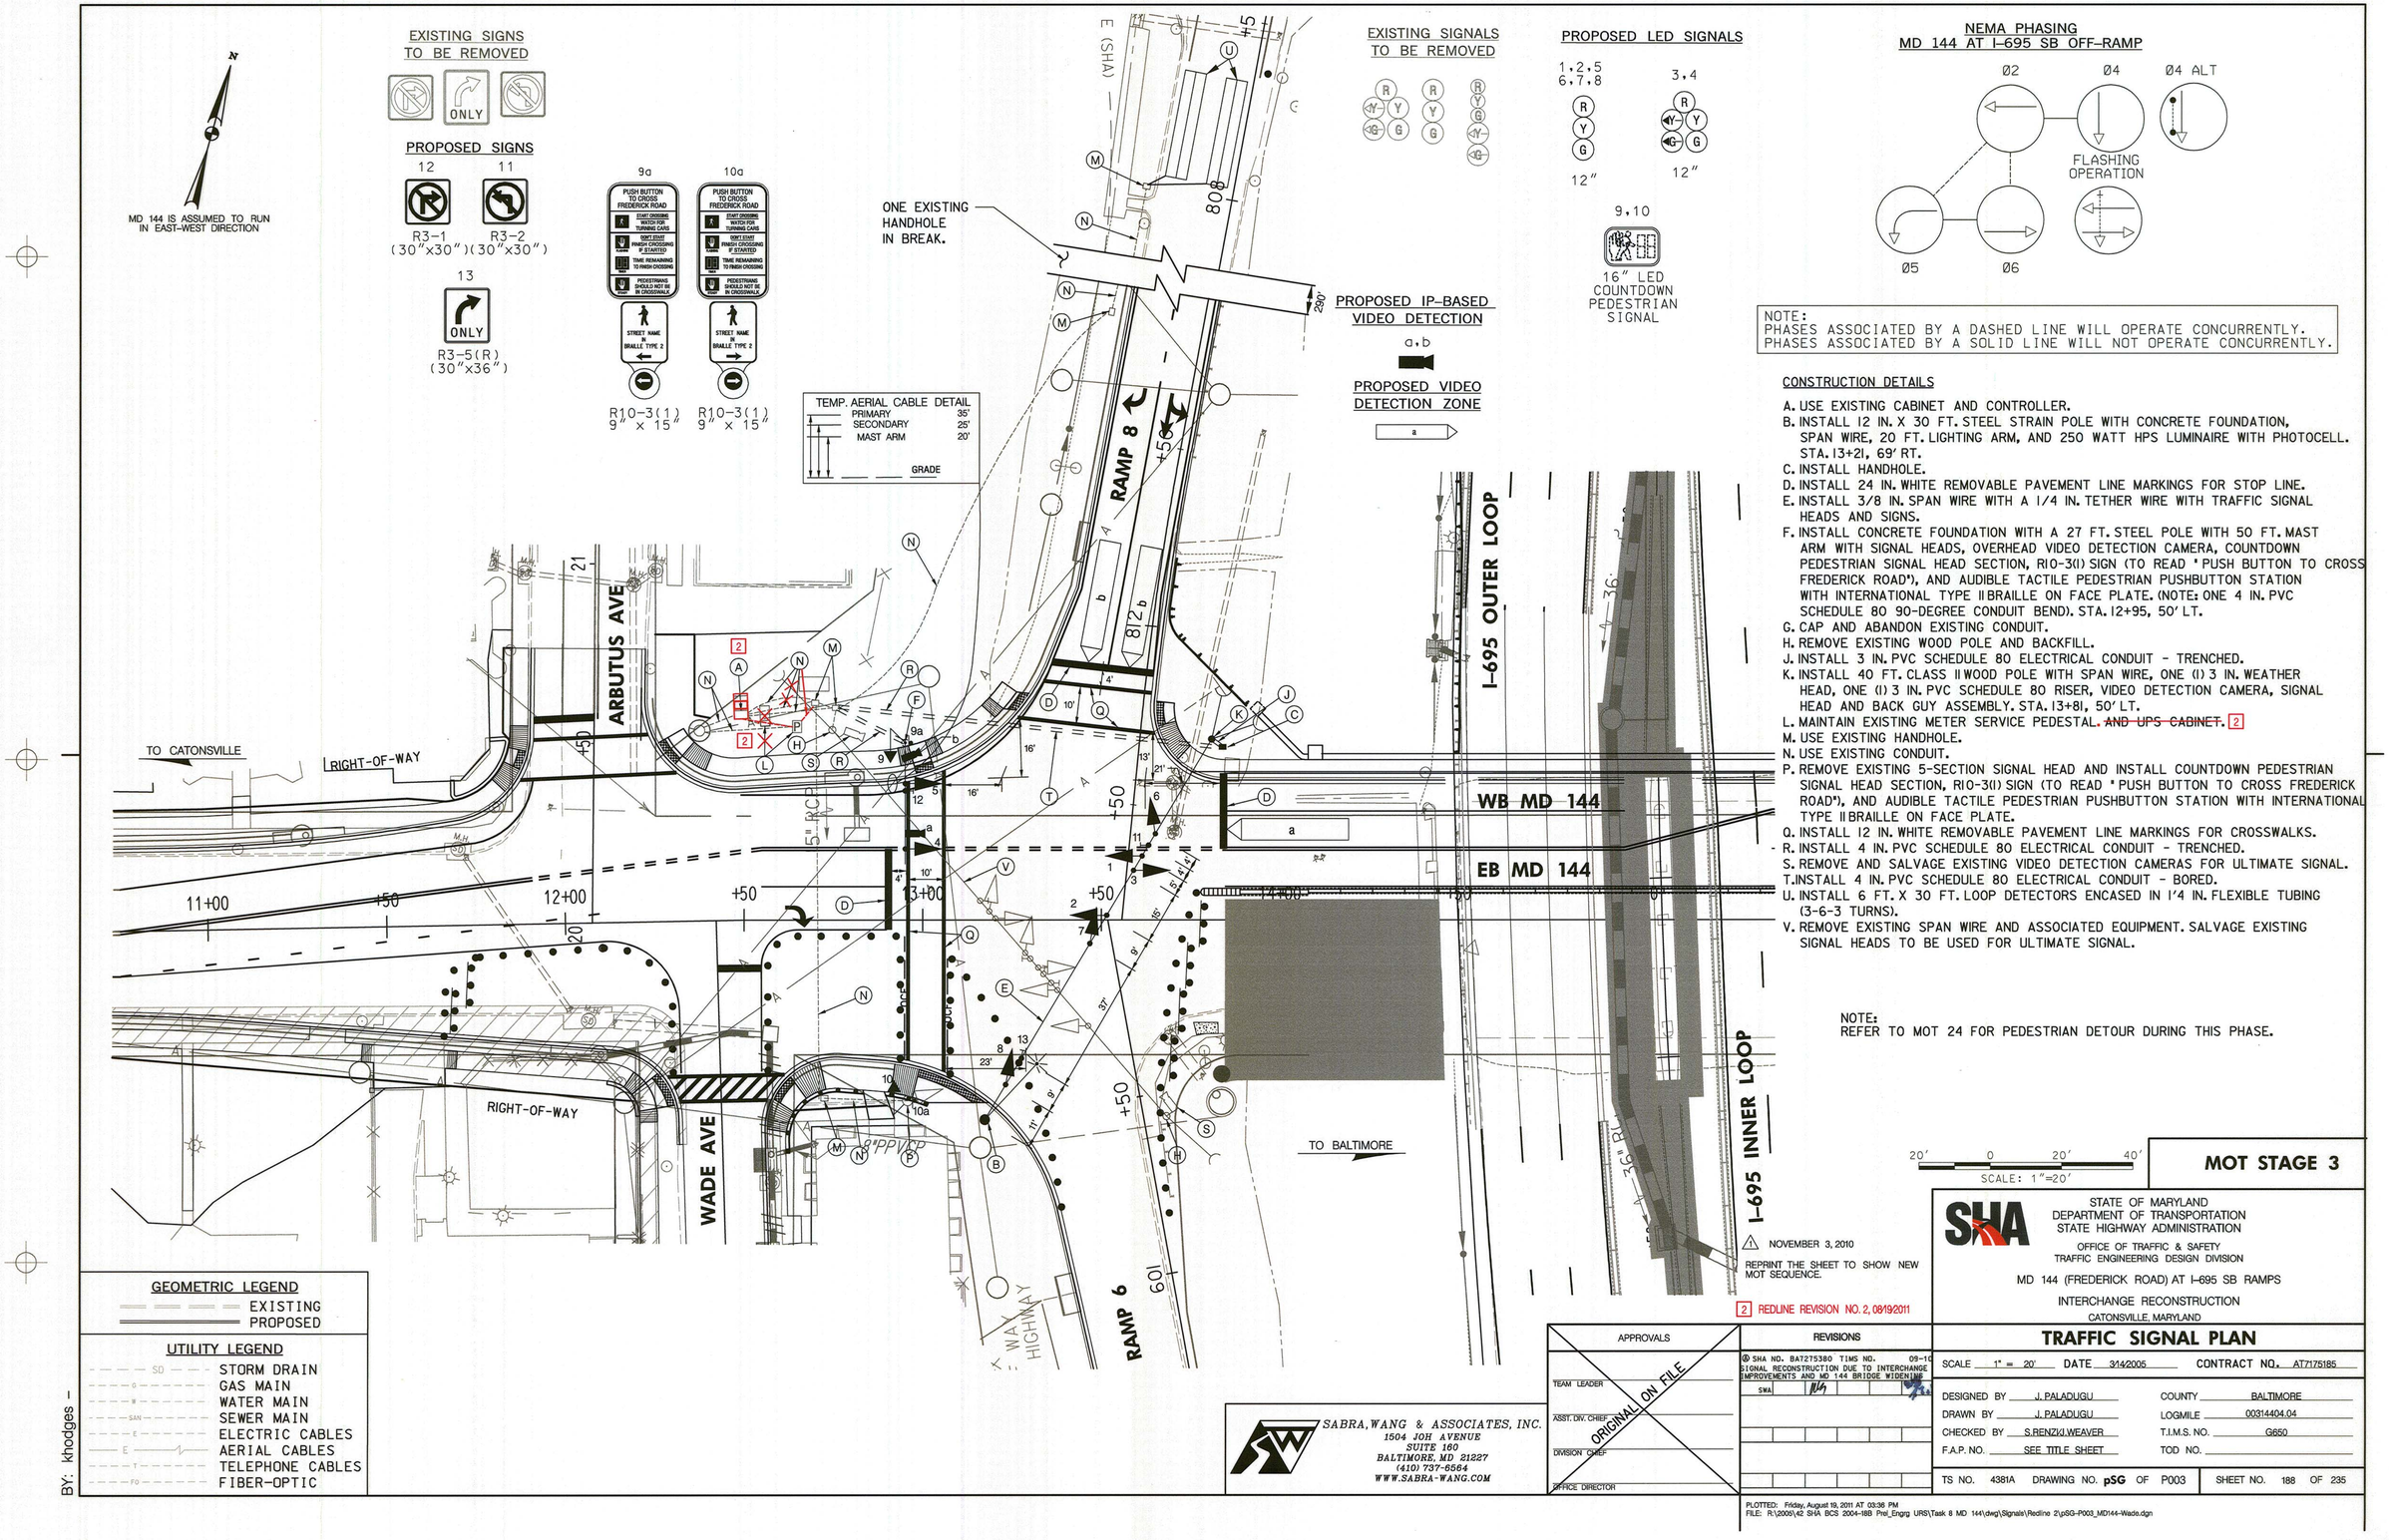
N
MD 144 IS ASSUMED TO RUN IN EAST-WEST DIRECTION
EXISTING SIGNS TO BE REMOVED
ONLY
PROPOSED SIGNS
12
R3-1 (30"x30")
11
R3-2 (30"x30")
13
ONLY
R3-5(R) (30"x36")
9a
PUSH BUTTON TO CROSS FREDERICK ROAD
START CROSSING WATCH FOR TURNING CARS
DON'T START FINISH CROSSING IF STARTED
TIME REMAINING TO FINISH CROSSING
PEDESTRIANS SHOULD NOT BE IN CROSSWALK
STREET NAME IN BRAILLE TYPE 2
R10-3(1) 9" x 15"
10a
PUSH BUTTON TO CROSS FREDERICK ROAD
START CROSSING WATCH FOR TURNING CARS
DON'T START FINISH CROSSING IF STARTED
TIME REMAINING TO FINISH CROSSING
PEDESTRIANS SHOULD NOT BE IN CROSSWALK
STREET NAME IN BRAILLE TYPE 2
R10-3(1) 9" x 15"
ONE EXISTING HANDHOLE IN BREAK.
TEMP. AERIAL CABLE DETAIL
PRIMARY 35'
SECONDARY 25'
MAST ARM 20'
GRADE
EXISTING SIGNALS TO BE REMOVED
PROPOSED LED SIGNALS
1,2,5 6,7,8
12"
3,4
12"
9,10
16" LED COUNTDOWN PEDESTRIAN SIGNAL
PROPOSED IP-BASED VIDEO DETECTION
a,b
PROPOSED VIDEO DETECTION ZONE
a
RAMP 8
RAMP 6
I-695 OUTER LOOP
I-695 INNER LOOP
WB MD 144
EB MD 144
ARBUTUS AVE
WADE AVE
TO CATONSVILLE
TO BALTIMORE
RIGHT-OF-WAY
RIGHT-OF-WAY
E (SHA)
11+00
12+00
13+00
12+00
+50
+50
+50