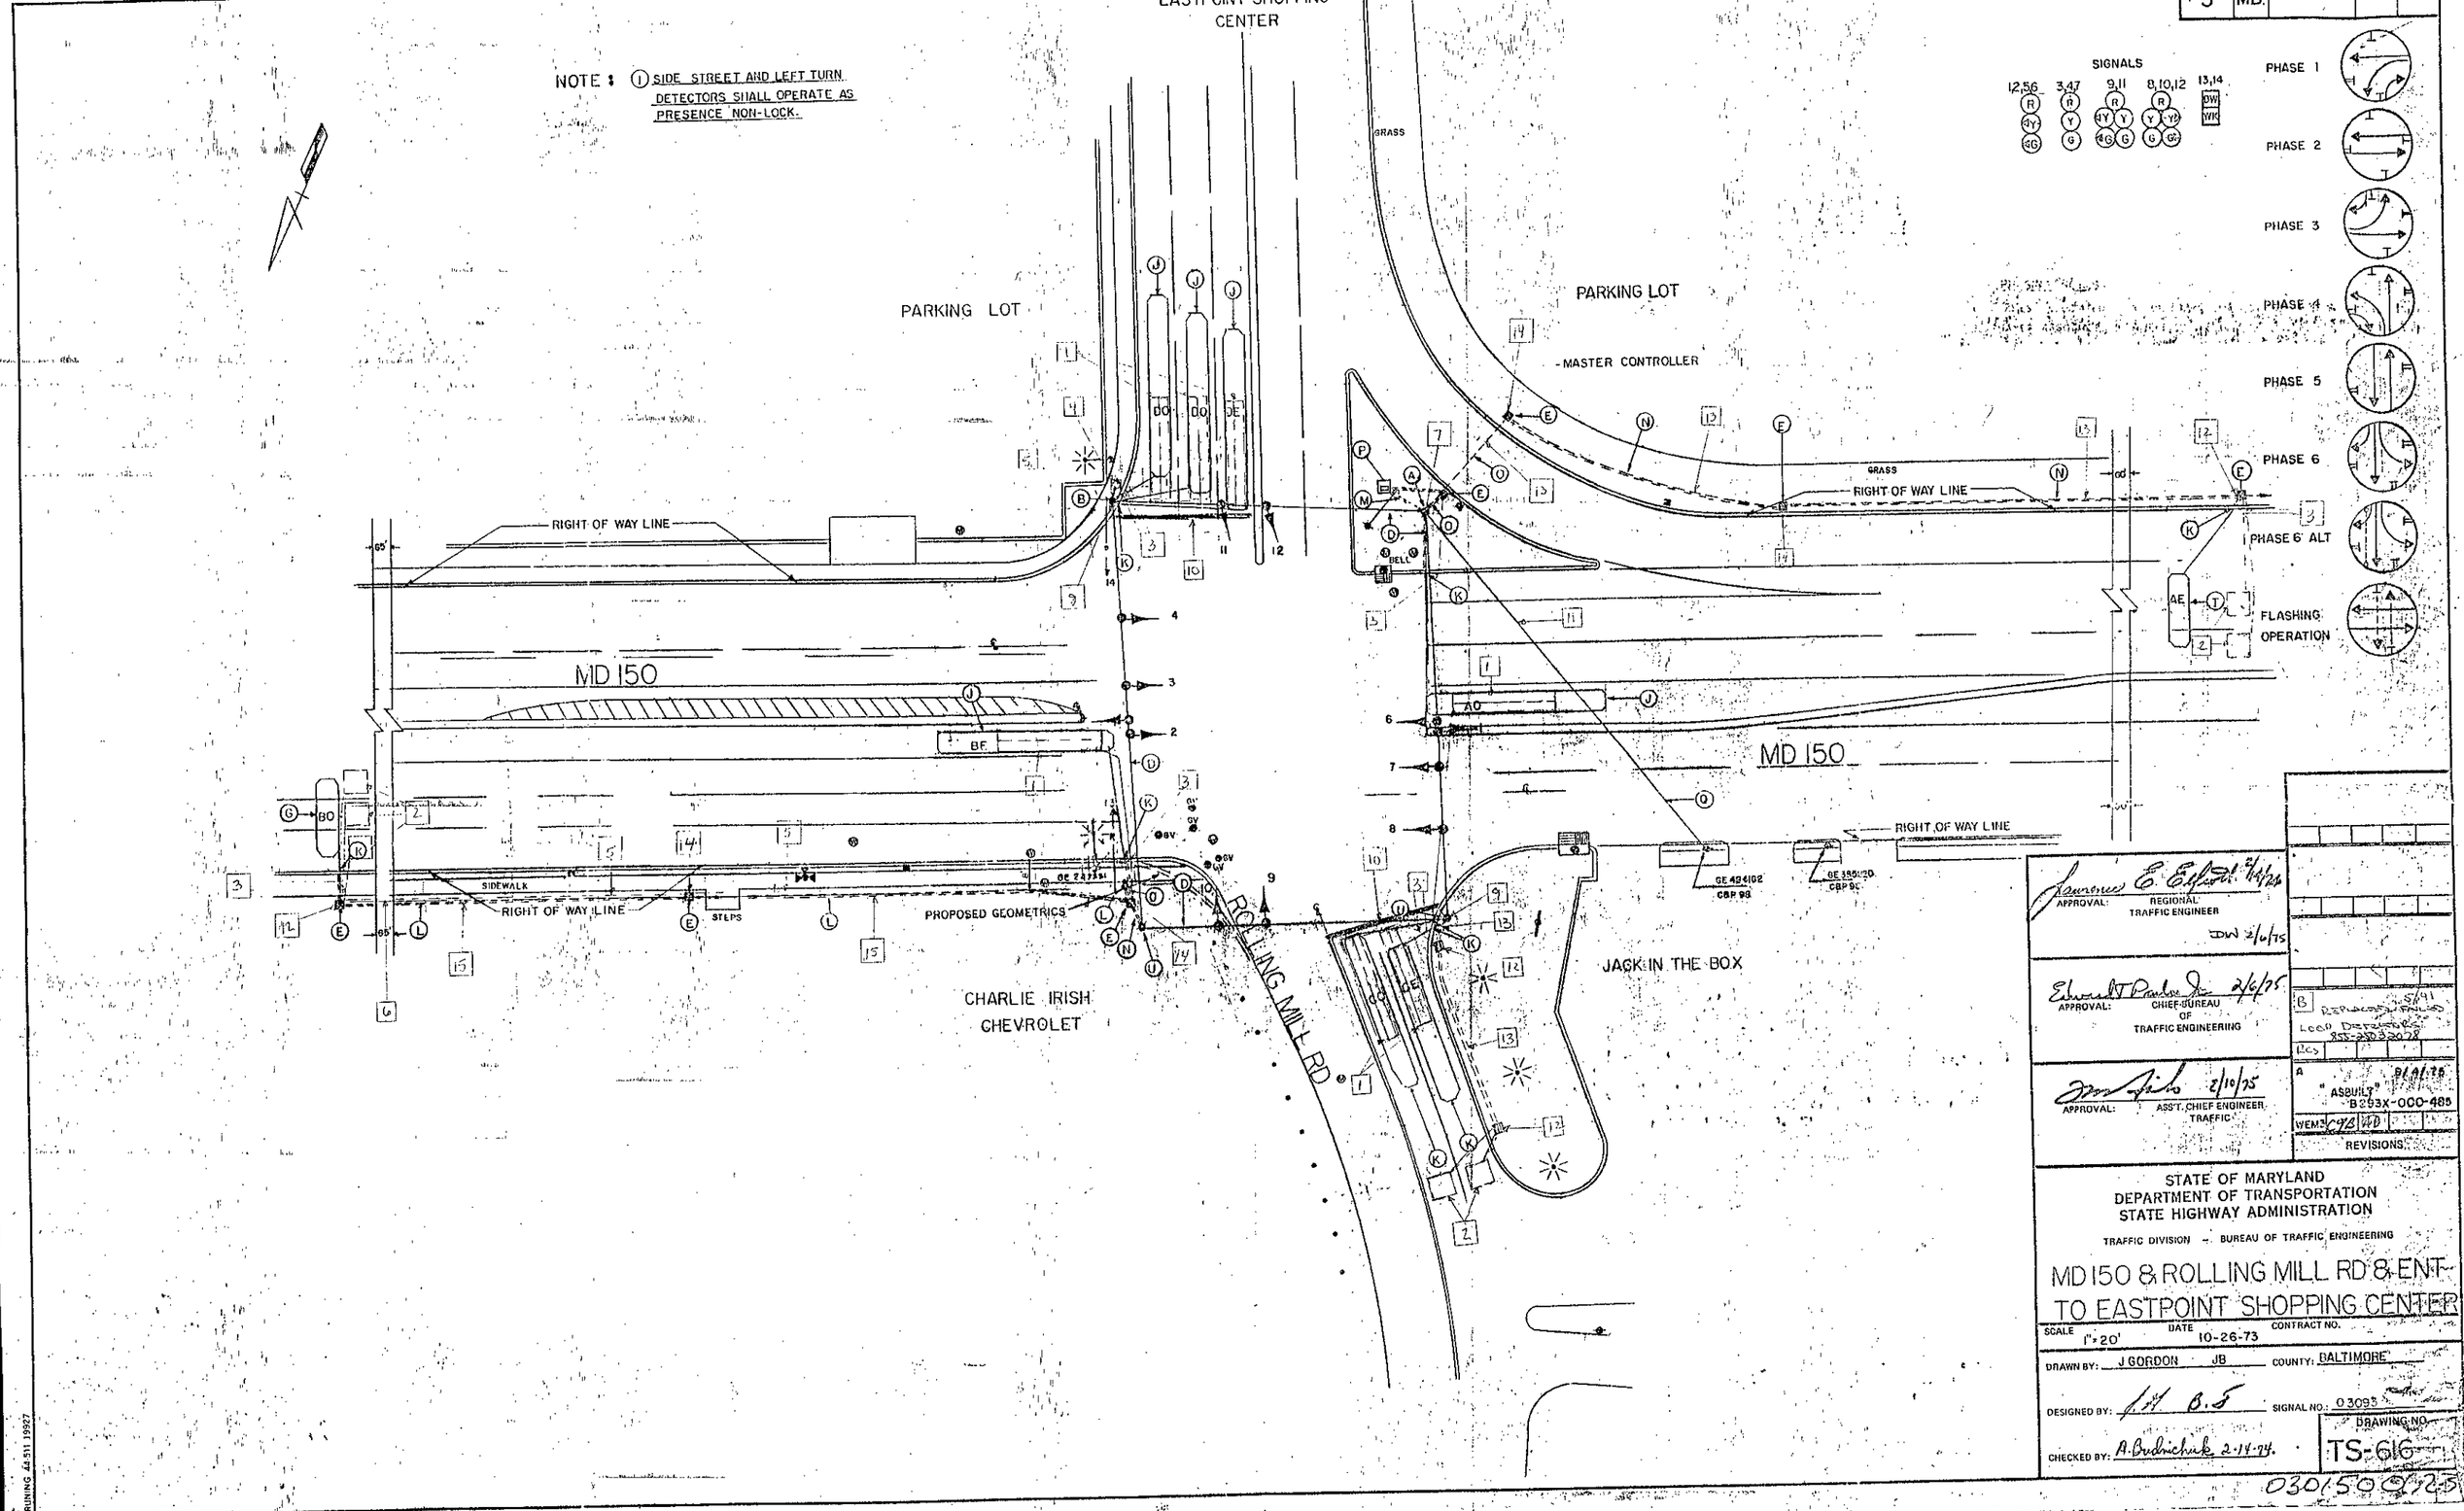

APPROVAL: REGIONAL TRAFFIC ENGINEER 2/4/75

DW 2/6/75

APPROVAL: CHIEF BUREAU OF TRAFFIC ENGINEERING 2/6/75

APPROVAL: ASS'T. CHIEF ENGINEER TRAFFIC 2/10/75

B 5/91 REPLACED FAILED LOAD DETECTORS 855-2503 2078

A 9/9/75 "ASBUILT" B293X-000-485

WEM3 CYB AD

REVISIONS

STATE OF MARYLAND
DEPARTMENT OF TRANSPORTATION
STATE HIGHWAY ADMINISTRATION

TRAFFIC DIVISION – BUREAU OF TRAFFIC ENGINEERING

MD 150 & ROLLING MILL RD & ENT TO EASTPOINT SHOPPING CENTER

SCALE 1"=20' DATE 10-26-73 CONTRACT NO.

DRAWN BY: J GORDON JB COUNTY: BALTIMORE

DESIGNED BY: [signature] B.S. SIGNAL NO.: 03093

CHECKED BY: A. Budnichuk 2-14-74.

DRAWING NO. TS-616

030150 0925

BRUNING 44 511 19927

THOMPSON ELECTRIC INC.
P. O. BOX 125
CHURCHVILLE MD. 21028