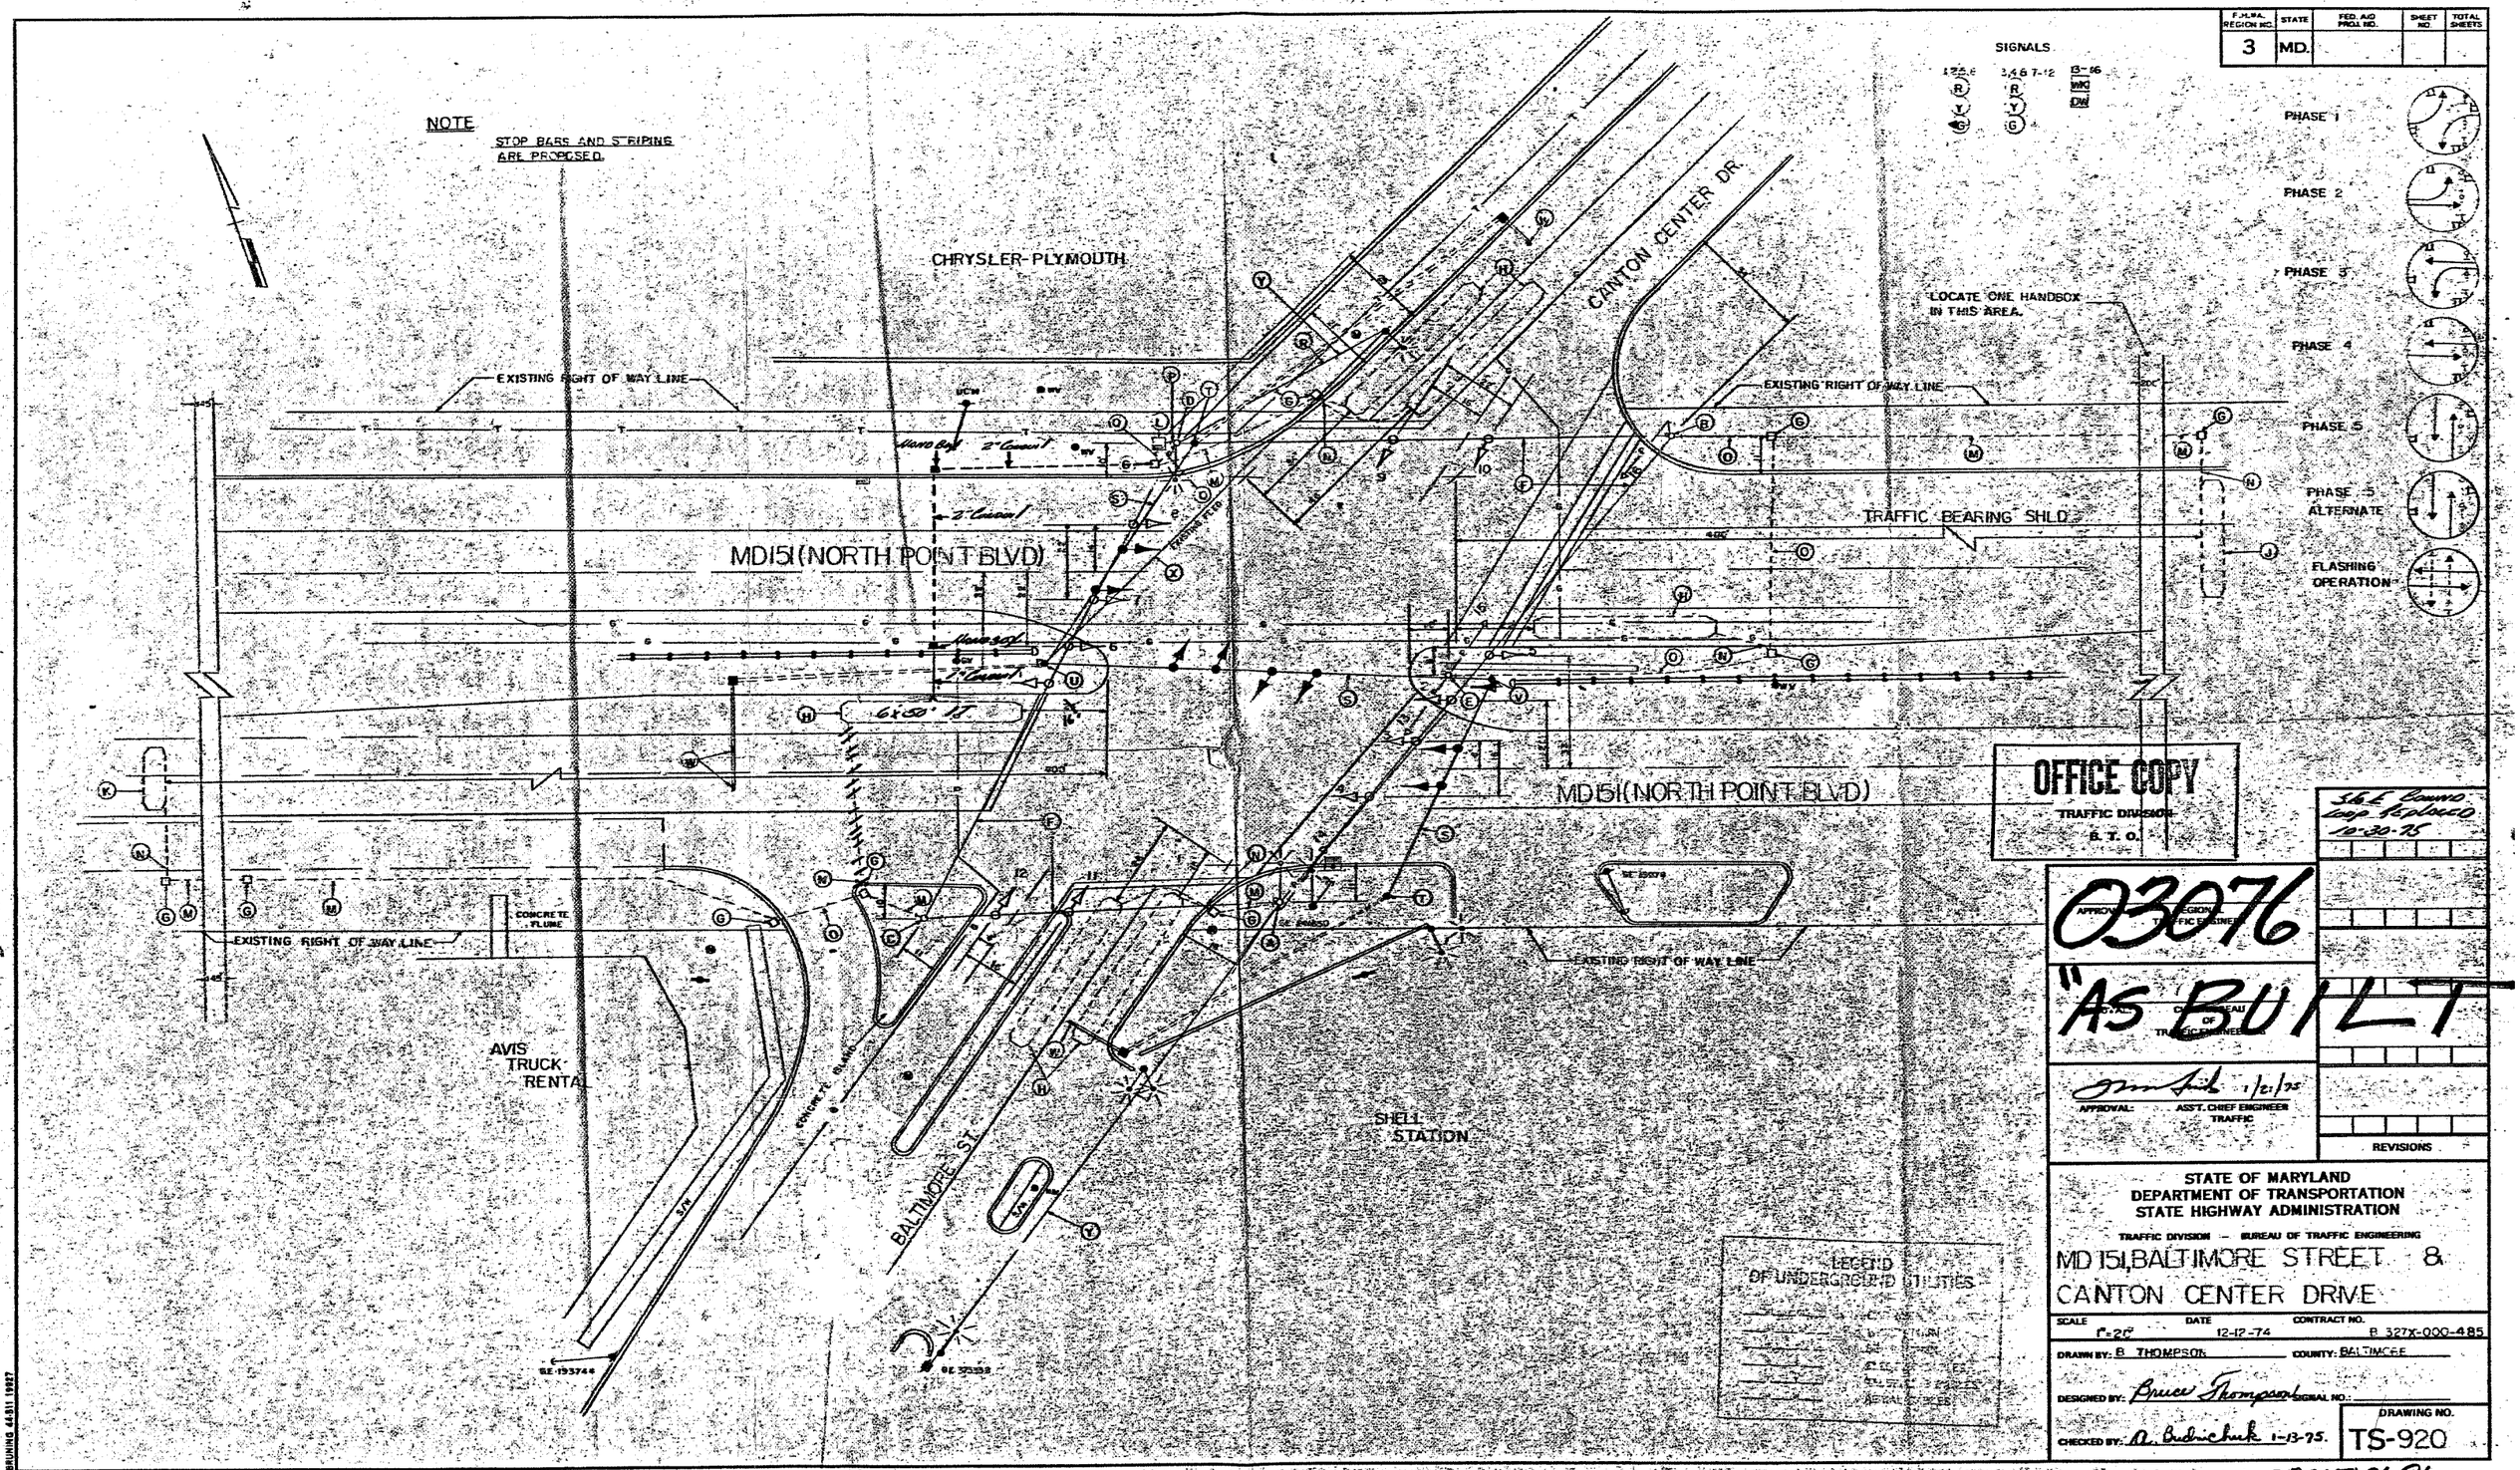

F.H.W.A. REGION NO. 3
STATE MD.
FED. AID PROJ. NO.
SHEET NO.
TOTAL SHEETS
SIGNALS
NOTE
STOP BARS AND STRIPING ARE PROPOSED.
CHRYSLER-PLYMOUTH
CANTON CENTER DR.
LOCATE ONE HANDBOX IN THIS AREA.
EXISTING RIGHT OF WAY LINE
TRAFFIC BEARING SHLD.
MD151 (NORTH POINT BLVD)
6x50' LT.
CONCRETE FLUME
AVIS TRUCK RENTAL
BALTIMORE ST.
SHELL STATION
PHASE 1
PHASE 2
PHASE 3
PHASE 4
PHASE 5
PHASE 5 ALTERNATE
FLASHING OPERATION
OFFICE COPY
TRAFFIC DIVISION
B. T. O.
03076
"AS BUILT
1/21/75
APPROVAL: ASS'T. CHIEF ENGINEER TRAFFIC
REVISIONS
LEGEND OF UNDERGROUND UTILITIES
STATE OF MARYLAND
DEPARTMENT OF TRANSPORTATION
STATE HIGHWAY ADMINISTRATION
TRAFFIC DIVISION — BUREAU OF TRAFFIC ENGINEERING
MD 151, BALTIMORE STREET &
CANTON CENTER DRIVE
SCALE 1"=20'
DATE 12-12-74
CONTRACT NO. B 327X-000-485
DRAWN BY: B. THOMPSON
COUNTY: BALTIMORE
DESIGNED BY: Bruce Thompson
SIGNAL NO.:
CHECKED BY: A. Budnichuk 1-13-75.
DRAWING NO. TS-920
0301510696