F.H.W.A. REGION NO.	STATE	FED. AID PROJ. NO.	SHEET NO.	TOTAL SHEETS
3	MD.		1	1

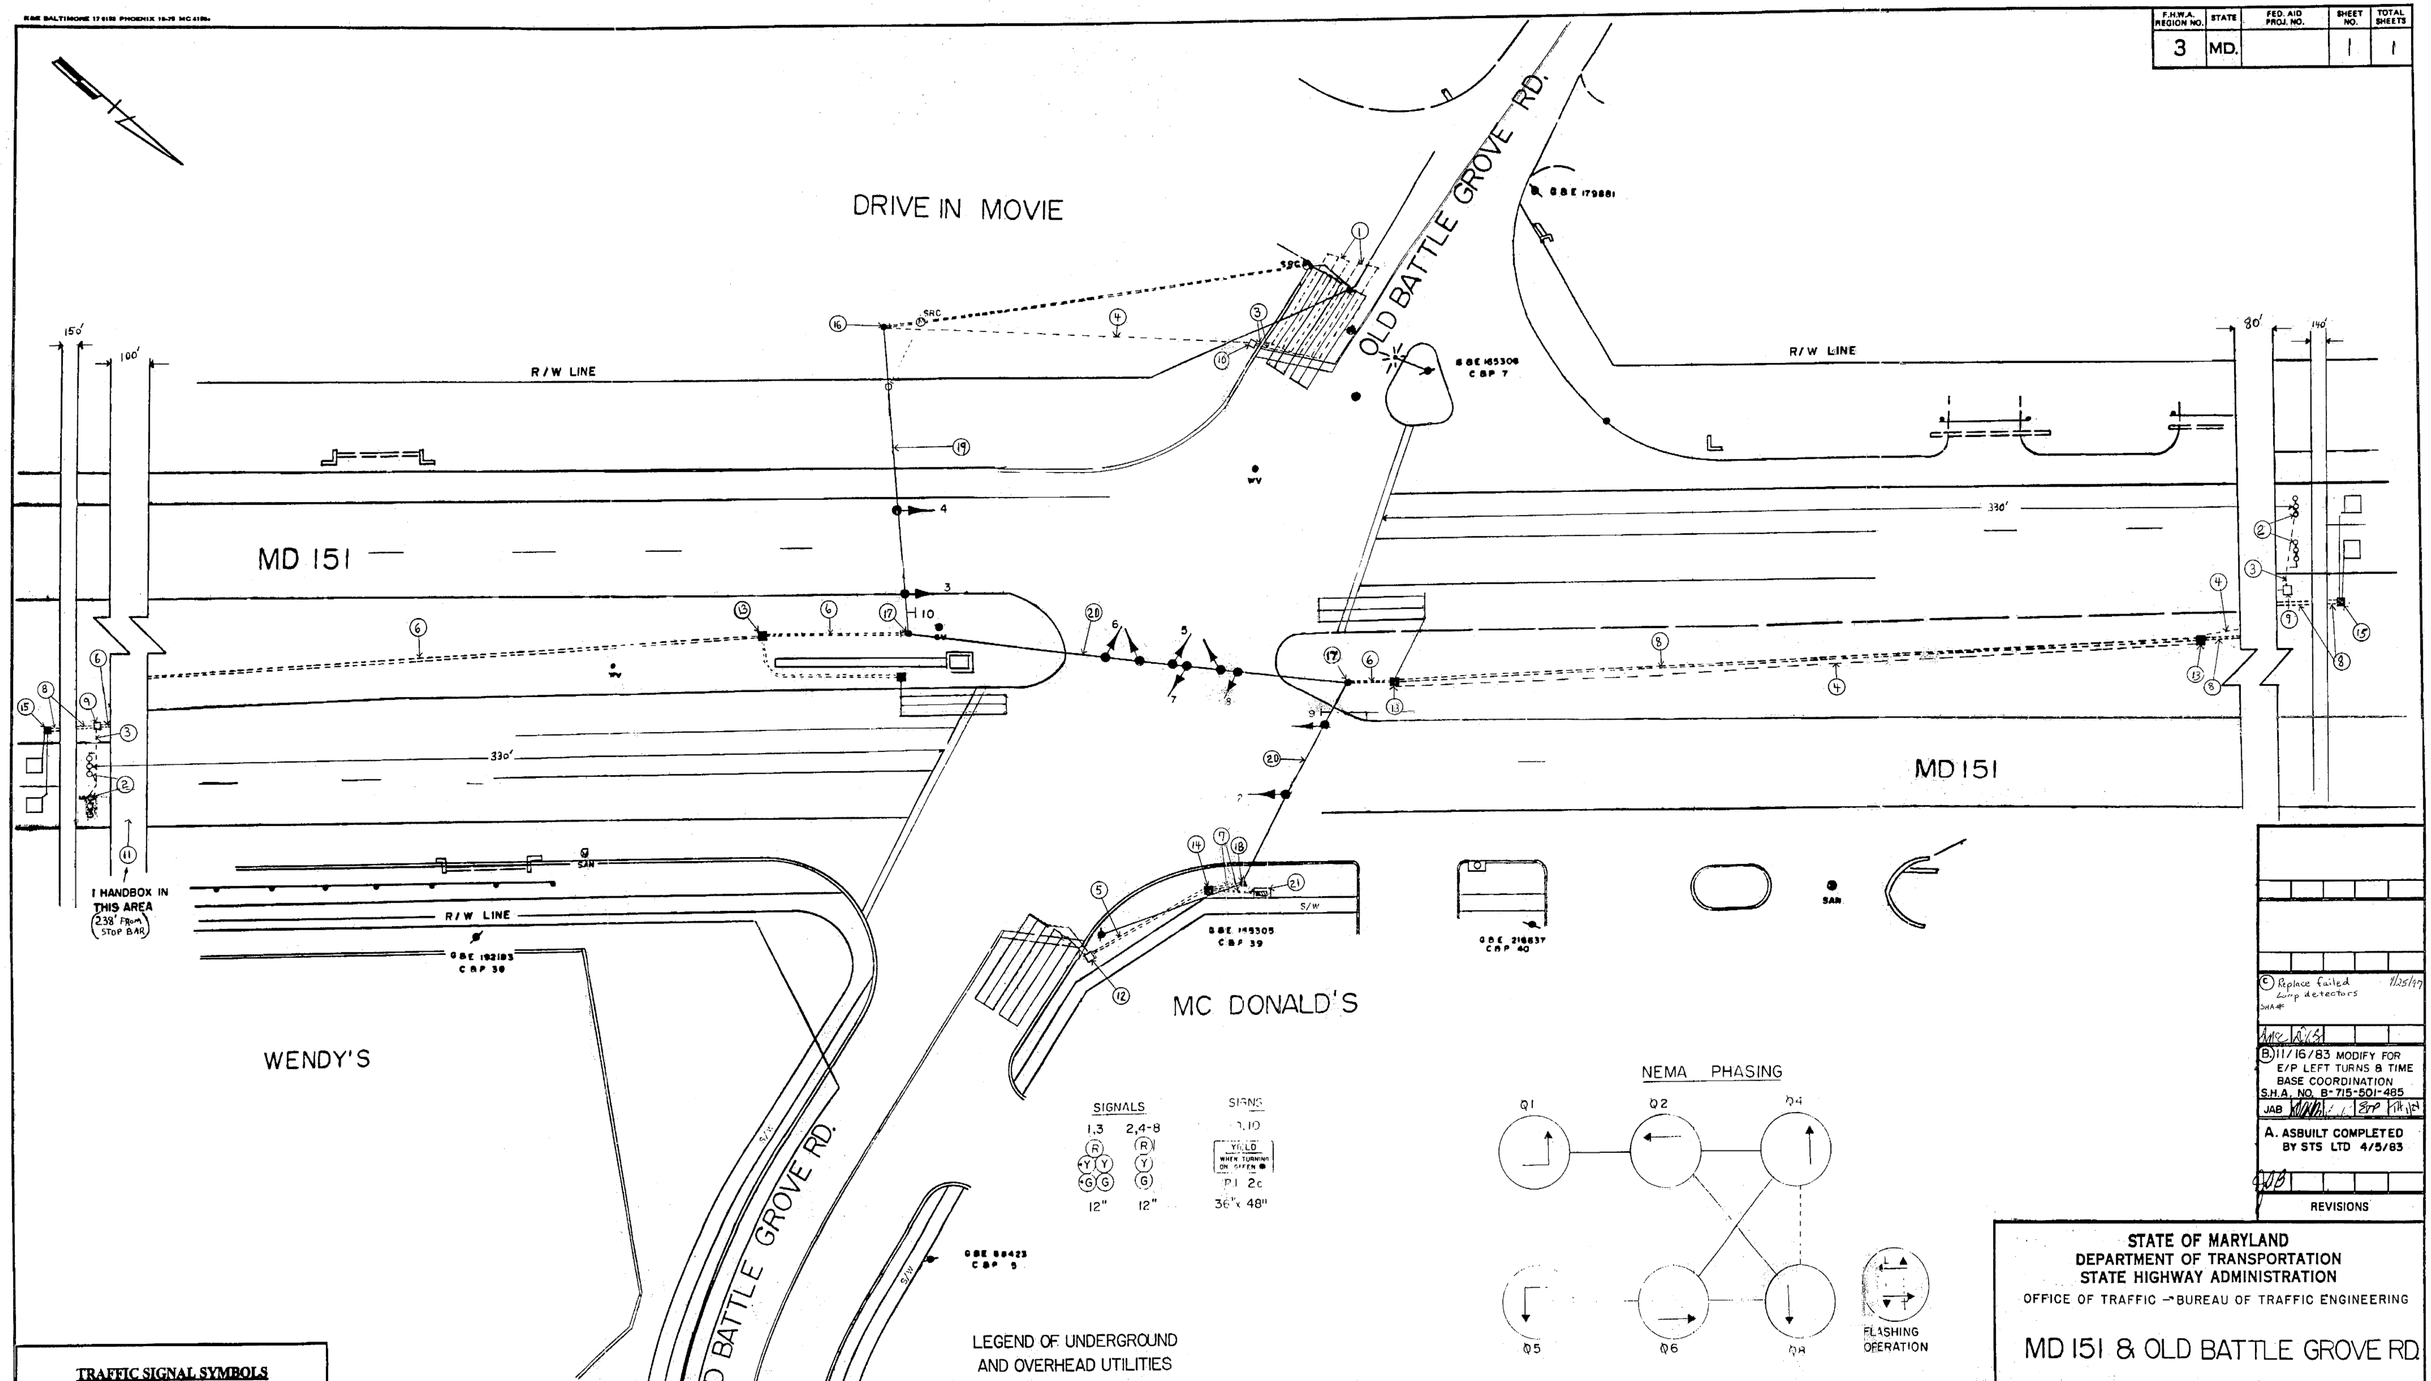

C. Replace failed loop detectors 11/25/97

B. 11/16/83 MODIFY FOR E/P LEFT TURNS & TIME BASE COORDINATION S.H.A. NO. B-715-501-485

A. ASBUILT COMPLETED BY STS LTD 4/5/83

REVISIONS

STATE OF MARYLAND
DEPARTMENT OF TRANSPORTATION
STATE HIGHWAY ADMINISTRATION
OFFICE OF TRAFFIC — BUREAU OF TRAFFIC ENGINEERING

MD 151 & OLD BATTLE GROVE RD.

SCALE 1" = 20'-0" DATE 4-15-78 CONTRACT NO. AW 764 A5A/B5A

DRAWN BY: J SPENCE COUNTY: BALTIMORE

DESIGNED BY: N/A SIGNAL NO.: 03084

CHECKED BY: N/A

DRAWING NO. TS-637B

STREET TRAFFIC STUDIES, LTD.
16628 S. Westland Drive
Gaithersburg, Maryland 20760

SURVEY BOOK 19851