F.H.W.A. REGION NO.	STATE	FED. AID PROJ. NO.	SHEET NO.	TOTAL SHEETS
3	MD.		2	13

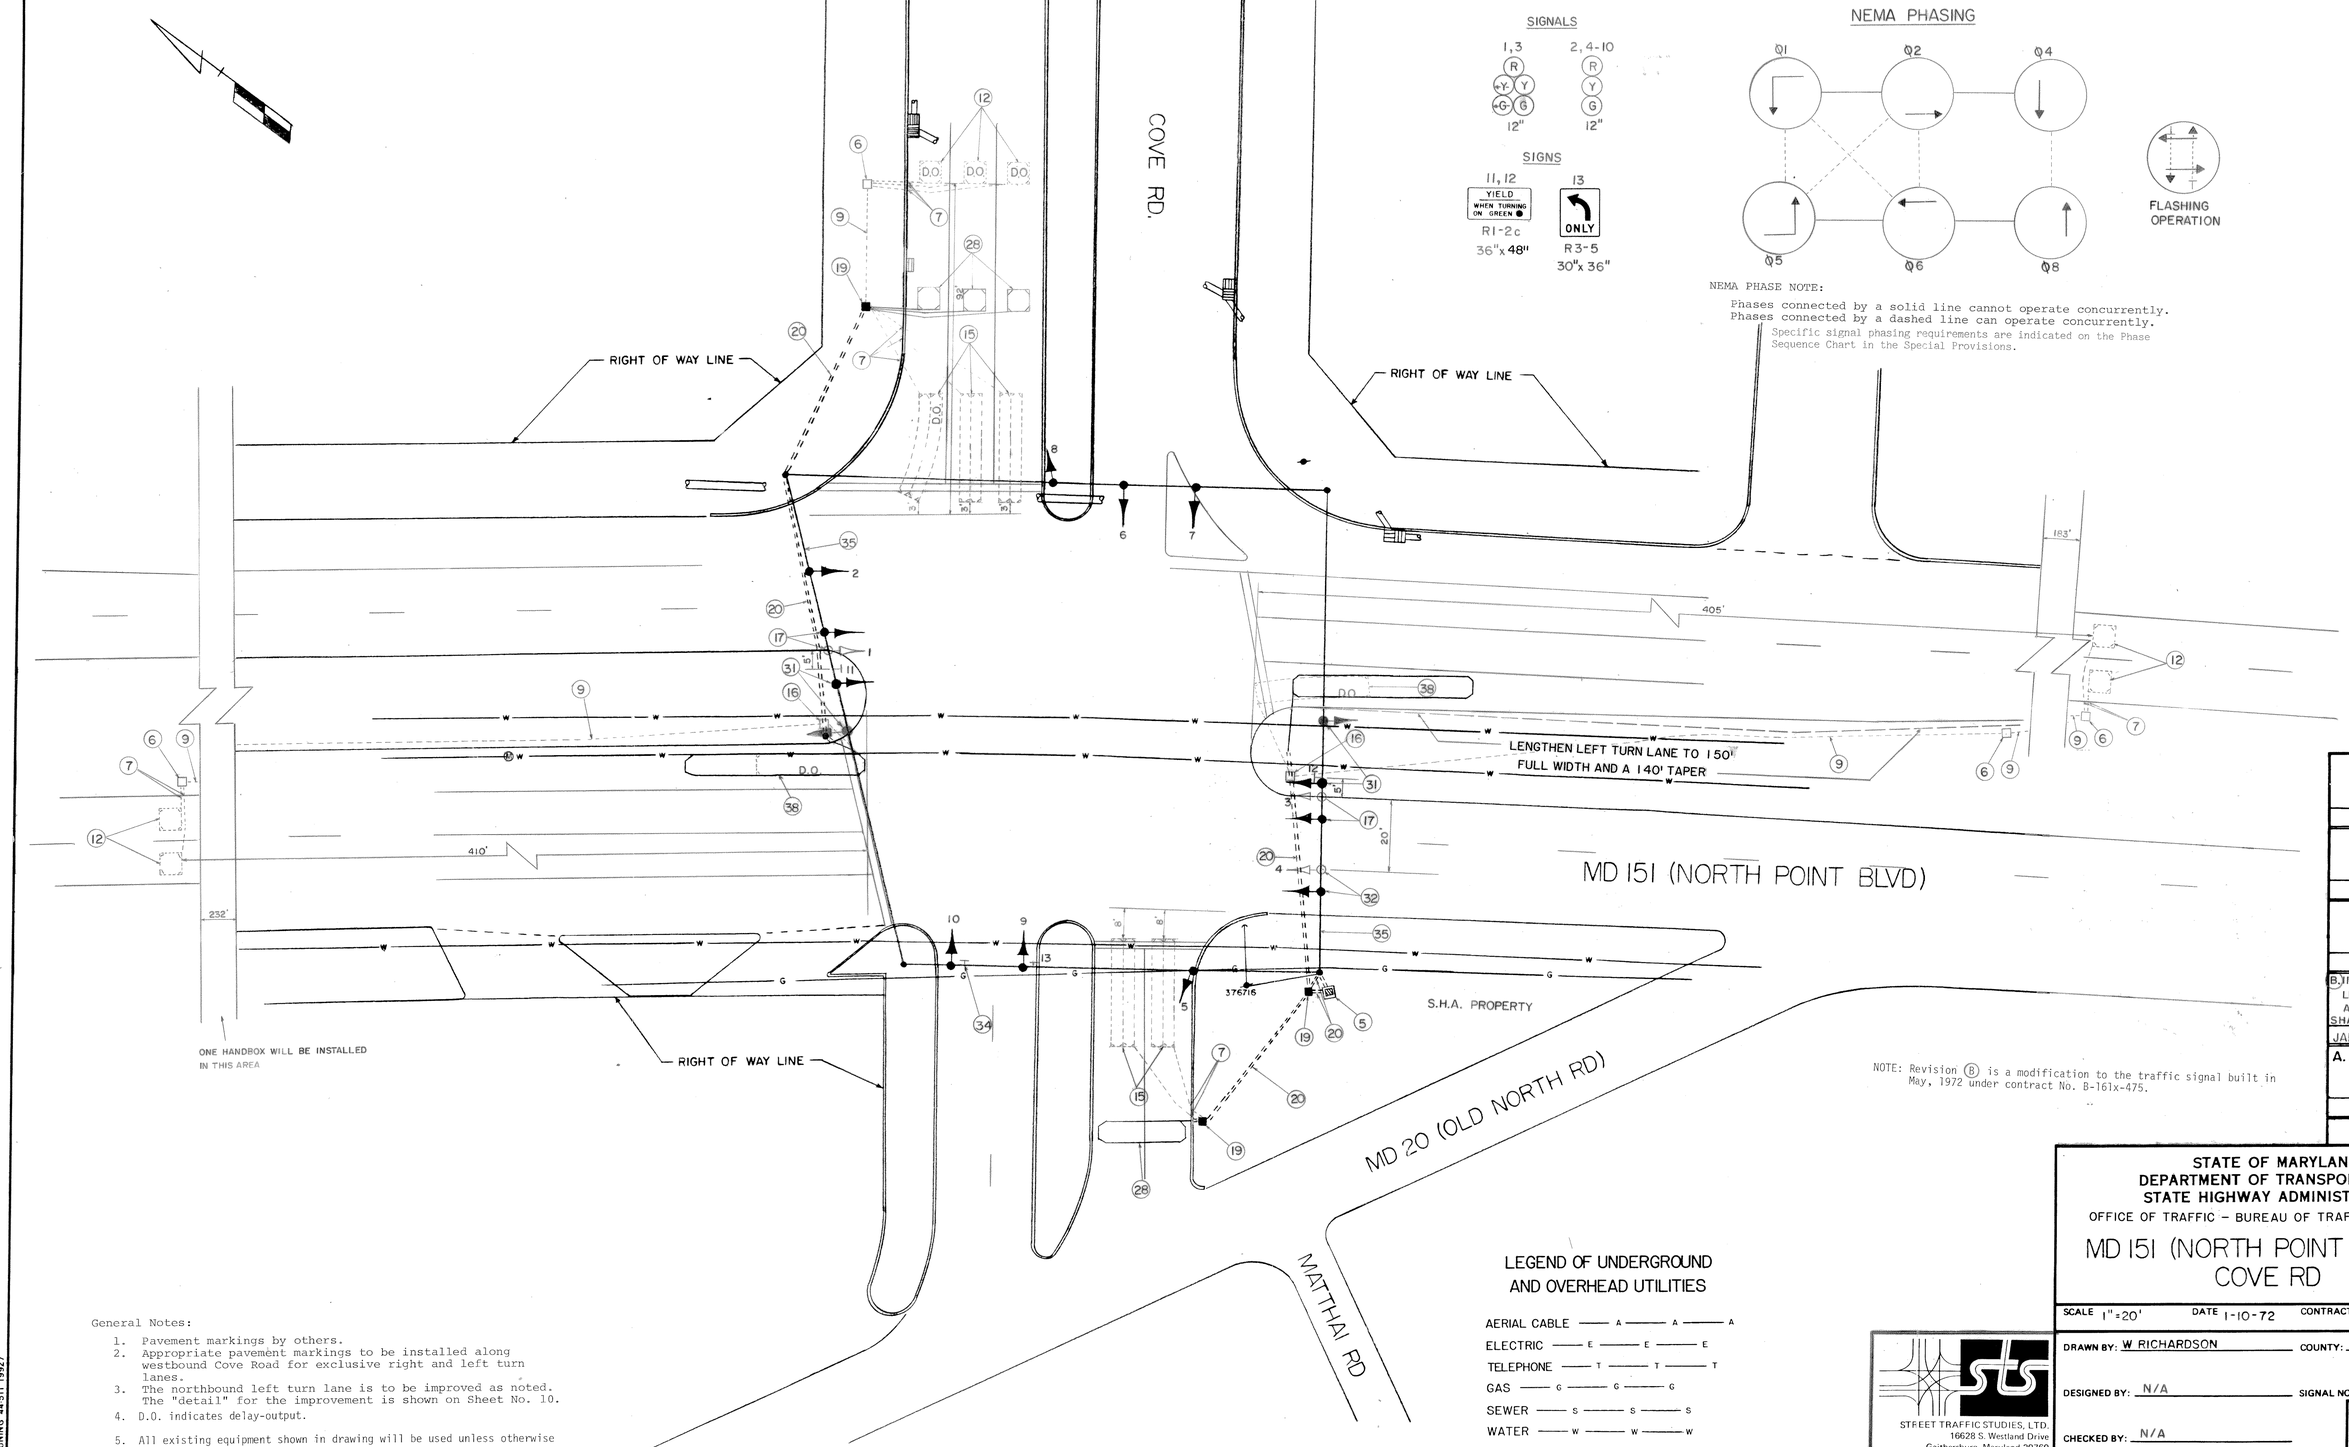

NOTE: Revision (B) is a modification to the traffic signal built in May, 1972 under contract No. B-161x-475.

General Notes:

1. Pavement markings by others.
2. Appropriate pavement markings to be installed along westbound Cove Road for exclusive right and left turn lanes.
3. The northbound left turn lane is to be improved as noted. The "detail" for the improvement is shown on Sheet No. 10.
4. D.O. indicates delay-output.
5. All existing equipment shown in drawing will be used unless otherwise specified.

LEGEND OF UNDERGROUND AND OVERHEAD UTILITIES

AERIAL CABLE — A — A — A
ELECTRIC — E — E — E
TELEPHONE — T — T — T
GAS — G — G — G
SEWER — S — S — S
WATER — W — W — W

STREET TRAFFIC STUDIES, LTD.
16628 S. Westland Drive
Gaithersburg, Maryland 20760

REVISIONS
(B) 11-16-83 MODIFY FOR E/P LEFT TURNS, TIME BASE COOR. AND GEOMETRIC IMPRO. SHA NO. B-715-501-485 JAB
A. ASBUILT 10-6-83

STATE OF MARYLAND
DEPARTMENT OF TRANSPORTATION
STATE HIGHWAY ADMINISTRATION
OFFICE OF TRAFFIC – BUREAU OF TRAFFIC ENGINEERING

MD 151 (NORTH POINT BLVD) & COVE RD

SCALE 1"=20' DATE 1-10-72 CONTRACT NO.

DRAWN BY: W RICHARDSON COUNTY: BALTIMORE

DESIGNED BY: N/A SIGNAL NO.: 03246

CHECKED BY: N/A

DRAWING NO. TS-387B

BRUNING 44511 19927