F.H.W.A. REGION NO.	STATE	FED. AID PROJ. NO.	SHEET NO.	TOTAL SHEETS
3	MD			

SIGNS

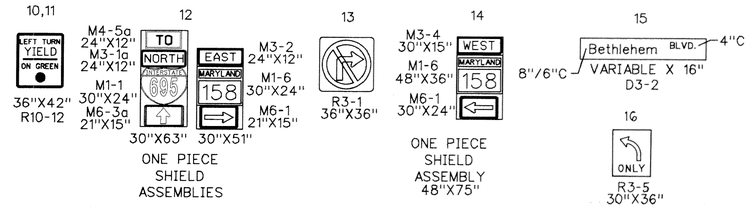

SIGNALS

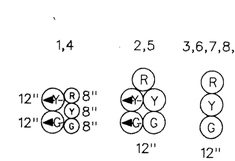

NEMA PHASING

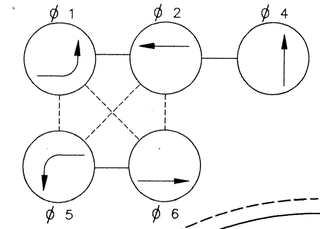

PHASING NOTES:
1. Phases associated by a solid line will not operate concurrently.
2. Phases associated by a dashed line will operate concurrently.

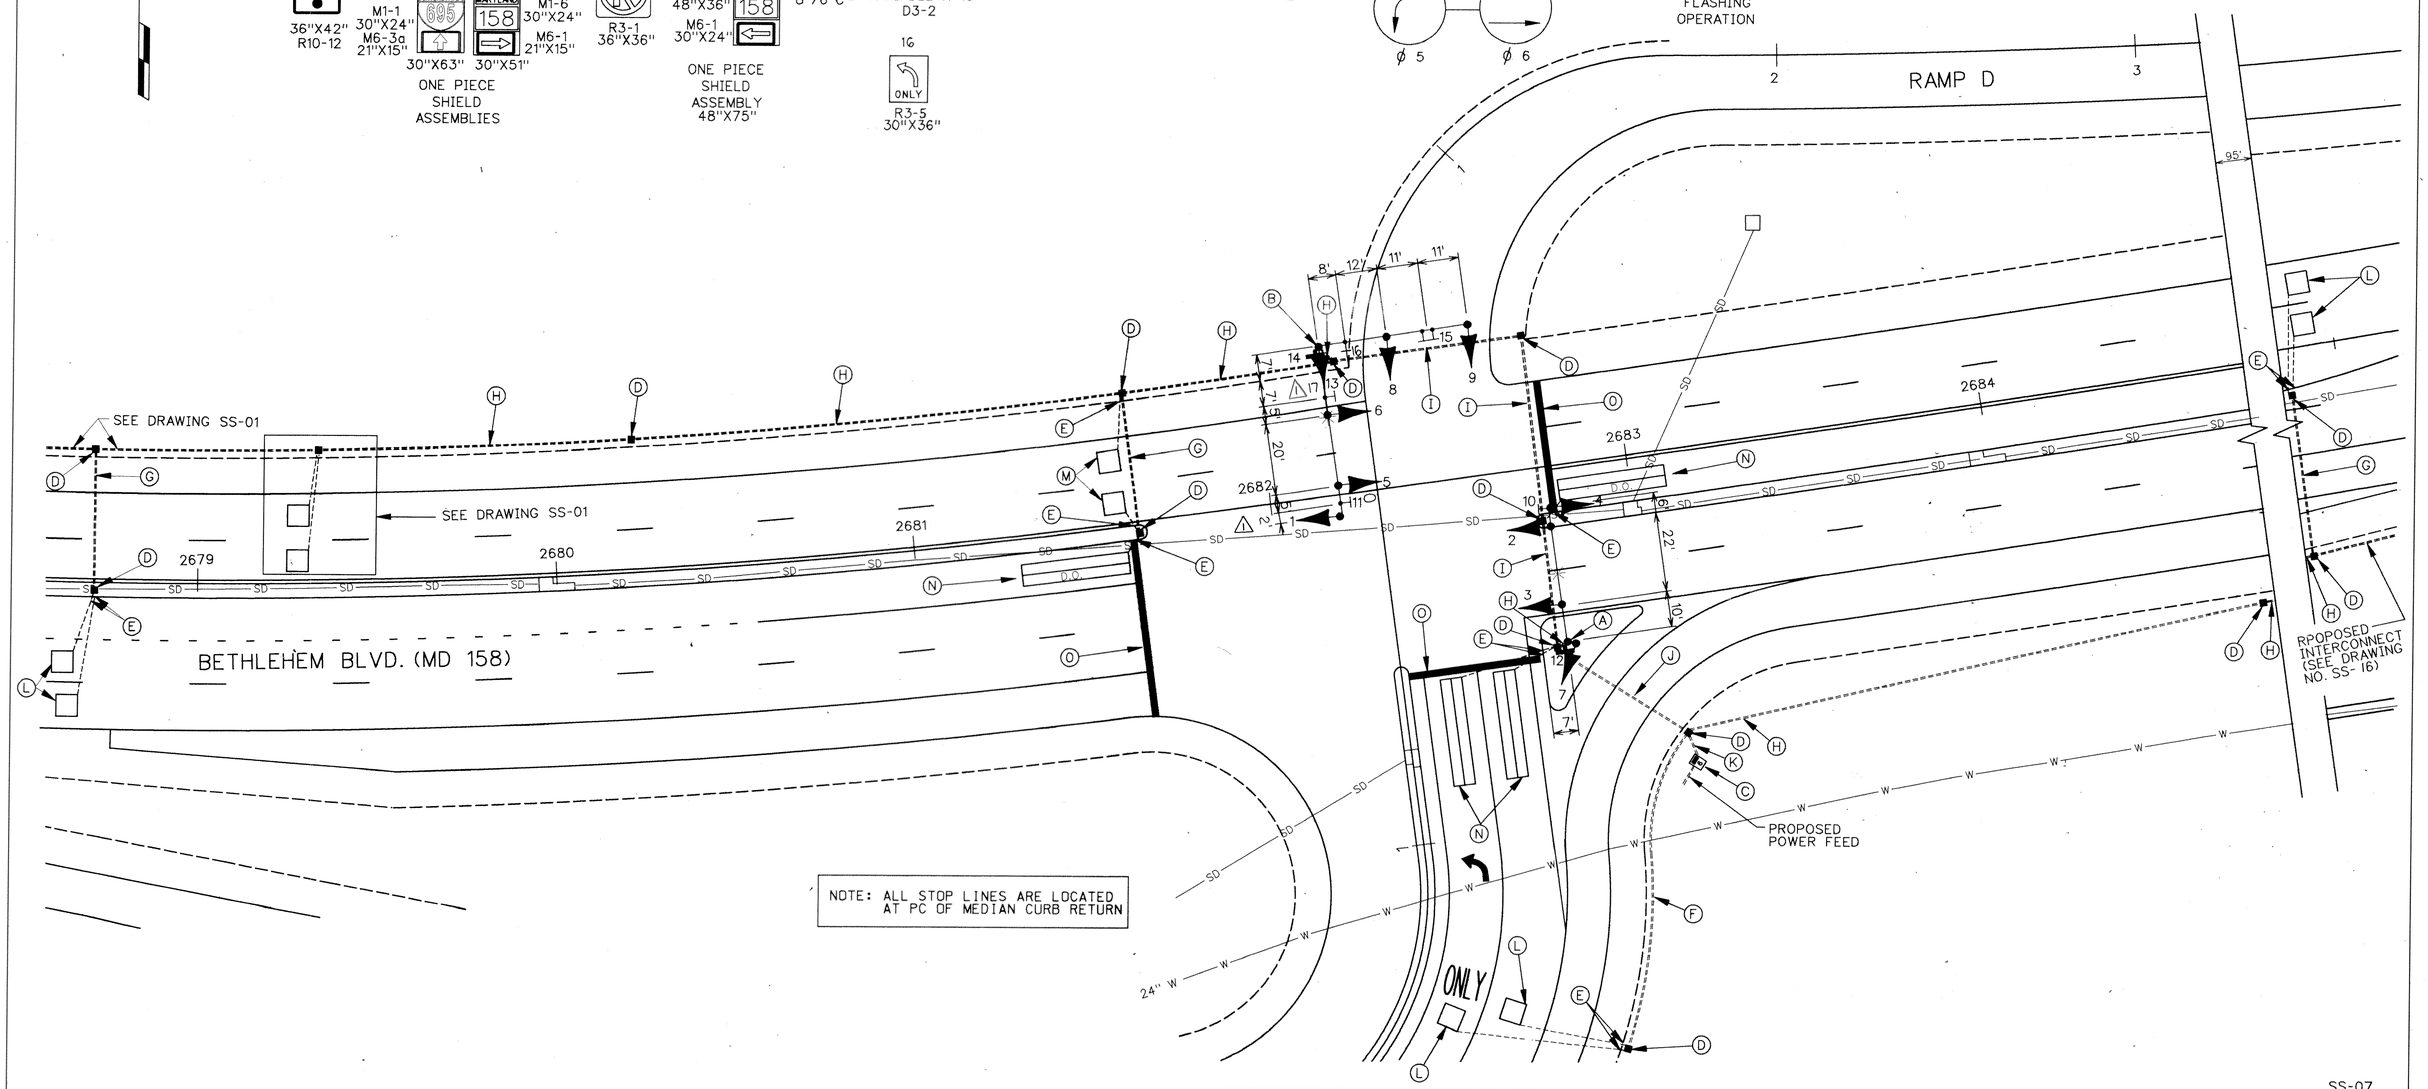

SS-07

UTILITIES LEGEND

—A—	AERIAL CABLES
—G—	GAS MAIN
—E—	ELECTRIC CABLES (UNDERGROUND)
—T—	TELEPHONE CABLES
—W—	WATER MAIN
—S—	SEWER MAIN
—SD—	STORM DRAIN

ROADWAY LEGEND

- - - - - - EXISTING
——— PROPOSED

RUMMEL, KLEPPER & KAHL
CONSULTING ENGINEERS
81 MOSHER STREET
BALTIMORE, MD 21217
TEL. (410) 728-2900

REVISIONS:
1 ADDENDUM NO. 1 4-24-95

APPROVALS:
CHIEF SIGNAL DESIGN SECTION — 3/23/95
ASST. DISTRICT ENGINEER TRAFFIC — 3/24/95
CHIEF TRAFFIC ENGINEERING DESIGN DIVISION — 3/30
DIRECTOR OFFICE OF TRAFFIC & SAFETY

MDOT - STATE HIGHWAY ADMINISTRATION
Office of Traffic & Safety
TRAFFIC ENGINEERING DESIGN DIVISION LOG MILE # 030158

DRAWN BY: ZAJ
DES. BY: ZAJ
CHK. BY: 3/23/95

MD 158 (BETHLEHEM BOULEVARD)
@ RAMP D
SIGNAL PLAN
COUNTY: BALTIMORE

DATE: MARCH, 1995
SCALE: 1"=20'
F.A.P. NO.
S.H.A. NO. KB-421-000-006
TS/STD. NO.: TS-3503P