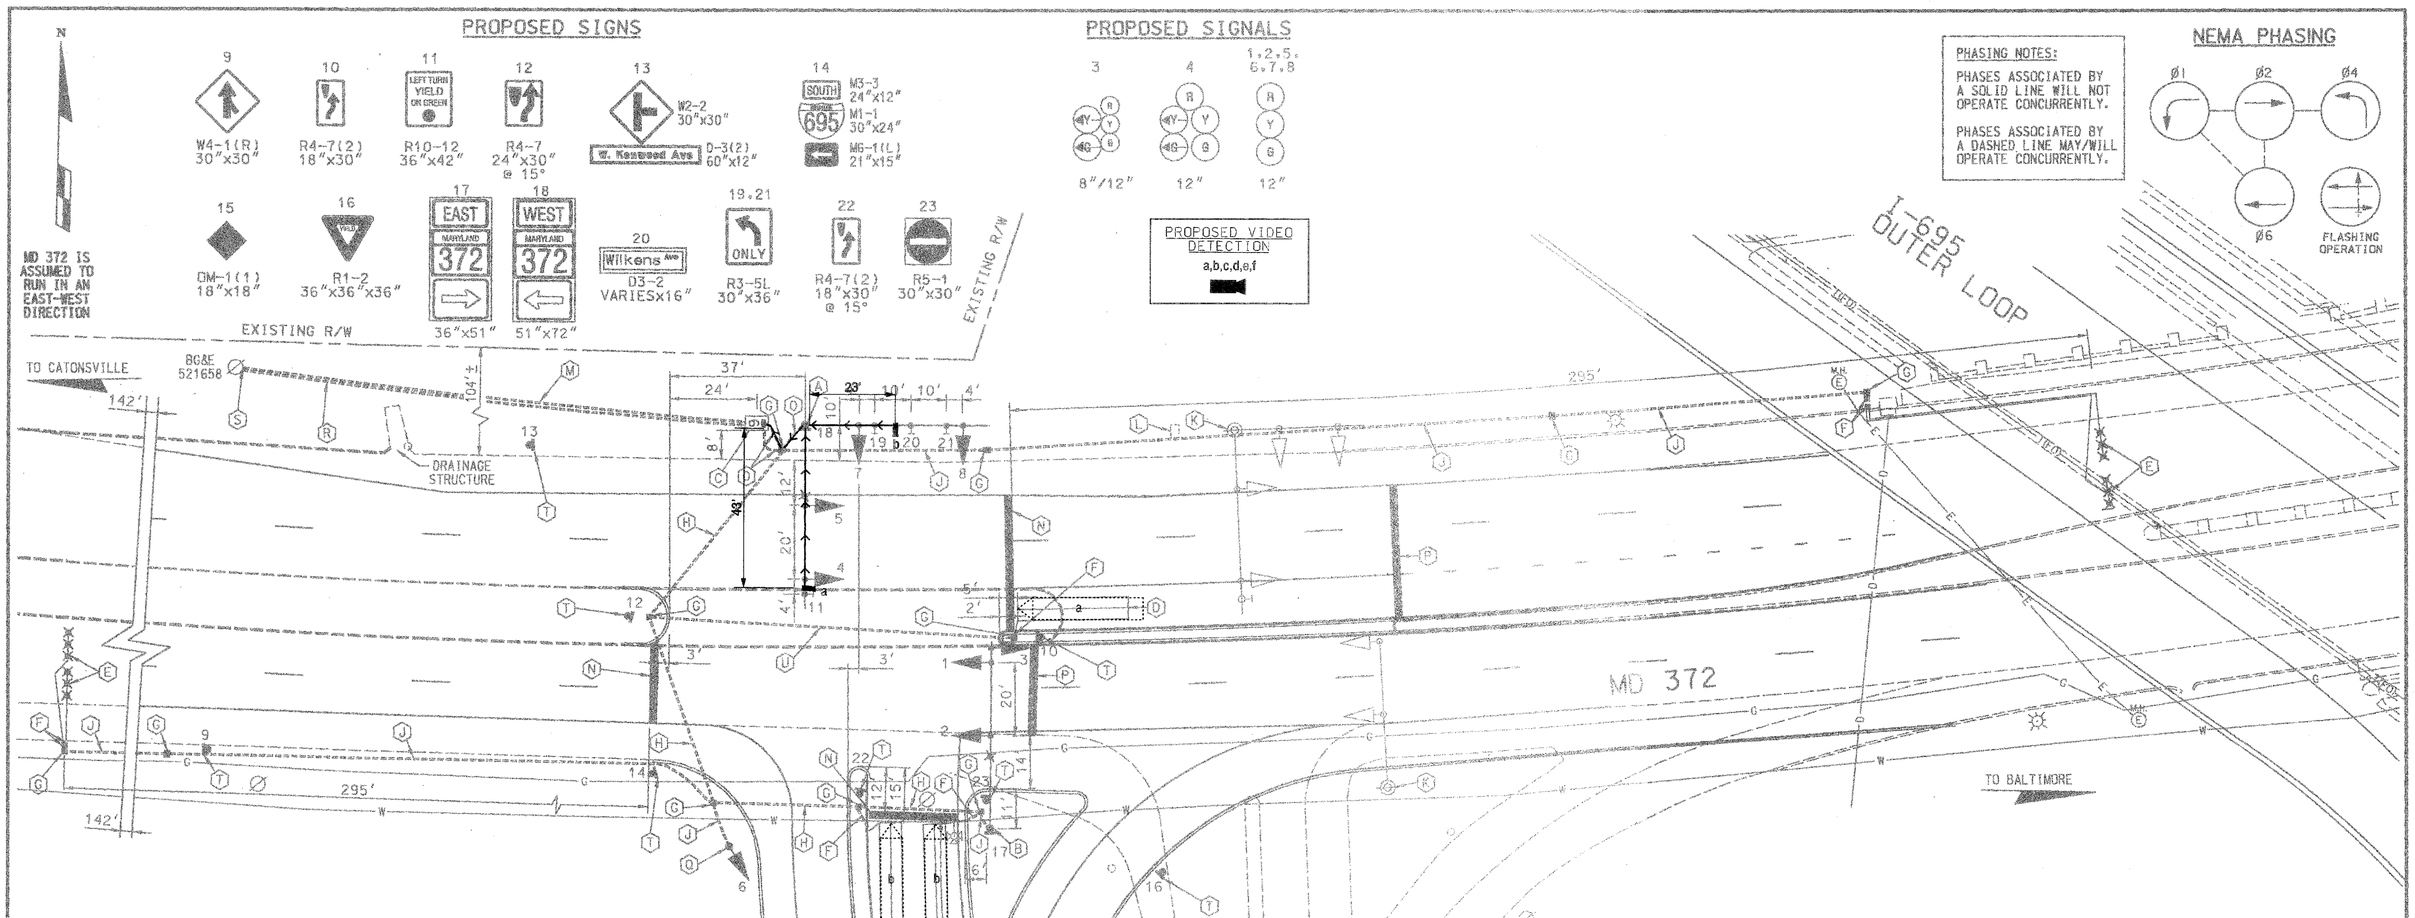

A. EQUIPMENT TO BE SUPPLIED BY THE ADMINISTRATION.

ITEM NO.	DESCRIPTION	UNITS	QUANTITY
9001	VIDEO DETECTION INTERFACE EQUIPMENT 1-4 CAMERAS	EA	1

B. EQUIPMENT TO BE FURNISHED AND/OR INSTALLED BY THE CONTRACTOR.

ITEM NO.	DESCRIPTION	UNITS	QUANTITY
8019	VIDEO DETECTION CAMERA	EA	2
8020	CONTROL CABLE, 250 FOOT VIDEO DETECTION CAMERA TO CONTROLLER	EA	2

VIDEO CAMERA LEGEND

= VIDEO CABLE (PATH TO CONTROLLER)

GEOMETRIC LEGEND

EXISTING GEOMETRICS
PROPOSED GEOMETRICS

LEGEND

—C——C— GAS MAIN
—W——W— WATER MAIN
—S——S— SEWER MAIN
—D——D— STORM DRAIN
—E——E— ELECTRIC CABLES
—A——A— AERIAL CABLES
—T(FO)——T(FO)— TELEPHONE FIBER OPTIC
—C——C— CABLE TELEVISION

GENERAL NOTES

1. VIDEO CAMERA LOCATION / ALIGNING SHALL BE COORDINATED WITH THE SHA ENGINEER.
2. THE CONTRACTOR SHALL CONTACT SHA TO SCHEDULE RETROFITTING OF THE CONTROLLER EQUIPMENT IN ORDER TO OPERATE VIDEO DETECTION EQUIPMENT.
3. THE CONTRACTOR SHALL BE RESPONSIBLE FOR TERMINATING ALL VIDEO DETECTION CAMERA CABLES TO THE APPROPRIATE TERMINALS AND PROPERLY LABEL EACH CABLE SO THAT SHA FORCES CAN MAKE THE FINAL CONNECTIONS.
4. THE INSTALLATION OF PROPOSED VIDEO DETECTION EQUIPMENT SHALL NECESSITATE THE REMOVAL OF EXISTING CABLES ASSOCIATED WITH THE PRESENCE LOOP DETECTORS BEING REPLACED BY VIDEO DETECTION.
5. ALL EXISTING TRAFFIC SIGNAL EQUIPMENT REMOVED SHALL BECOME THE PROPERTY OF THE SIGNAL CONTRACTOR UPON COMPLETION OF THE SIGNAL MODIFICATIONS.
6. ALL UNUSED SIGNAL CABLES SHALL BE REMOVED AND DISPOSED.

SABRA, WANG & ASSOCIATES, INC.
1504 10TH AVENUE
SUITE 160
BALTIMORE, MD 21227
(410) 737-6564
WWW.SABRA-WANG.COM

REVISIONS

©	INSTALL VIDEO DETECTION SHA No. A-3365A95	8/25/04
SWA		
(2)	REPAIR AND RECONSTRUCT TRAFFIC SIGNAL DUE TO BA3395172 CONSTRUCTION ADDENDUM NO. REPLACEMENT SHEET	12-12-2000
A	AS BUILT	3-30-81

APPROVALS

ASST. TRAFFIC ENGINEERING DESIGN DIVISION
ASST. DISTRICT ENGINEER, TRAFFIC
CHIEF, TRAFFIC ENGINEERING DESIGN DIVISION
DIRECTOR, OFFICE OF TRAFFIC & SAFETY
ORIGINAL ON FILE

SHA MARYLAND DOT - STATE HIGHWAY ADMINISTRATION
Office of Traffic & Safety
TRAFFIC ENGINEERING DESIGN DIVISION

MD 372 (WILKENS AVE) and I-695 SB RAMPS SIGNALIZATION PLAN

DRAWN BY:	J. SCHROLL	F.A.P. NO.	SEE TITLE SHEET	T.S. No.	SHEET NO.
CHECKED BY:	D. MONGAN	S.H.A. NO.	B548-501-485	1595X C	
SCALE:	1" = 20'	COUNTY:	BALTIMORE	T.I.M.S. NO.	
DATE:	01-05-79	LOG MILE:	0303720I.40	D493	1 OF

JBG