


MD 372 (WILKENS AVENUE) IS ASSUMED TO RUN IN AN EAST / WEST DIRECTION

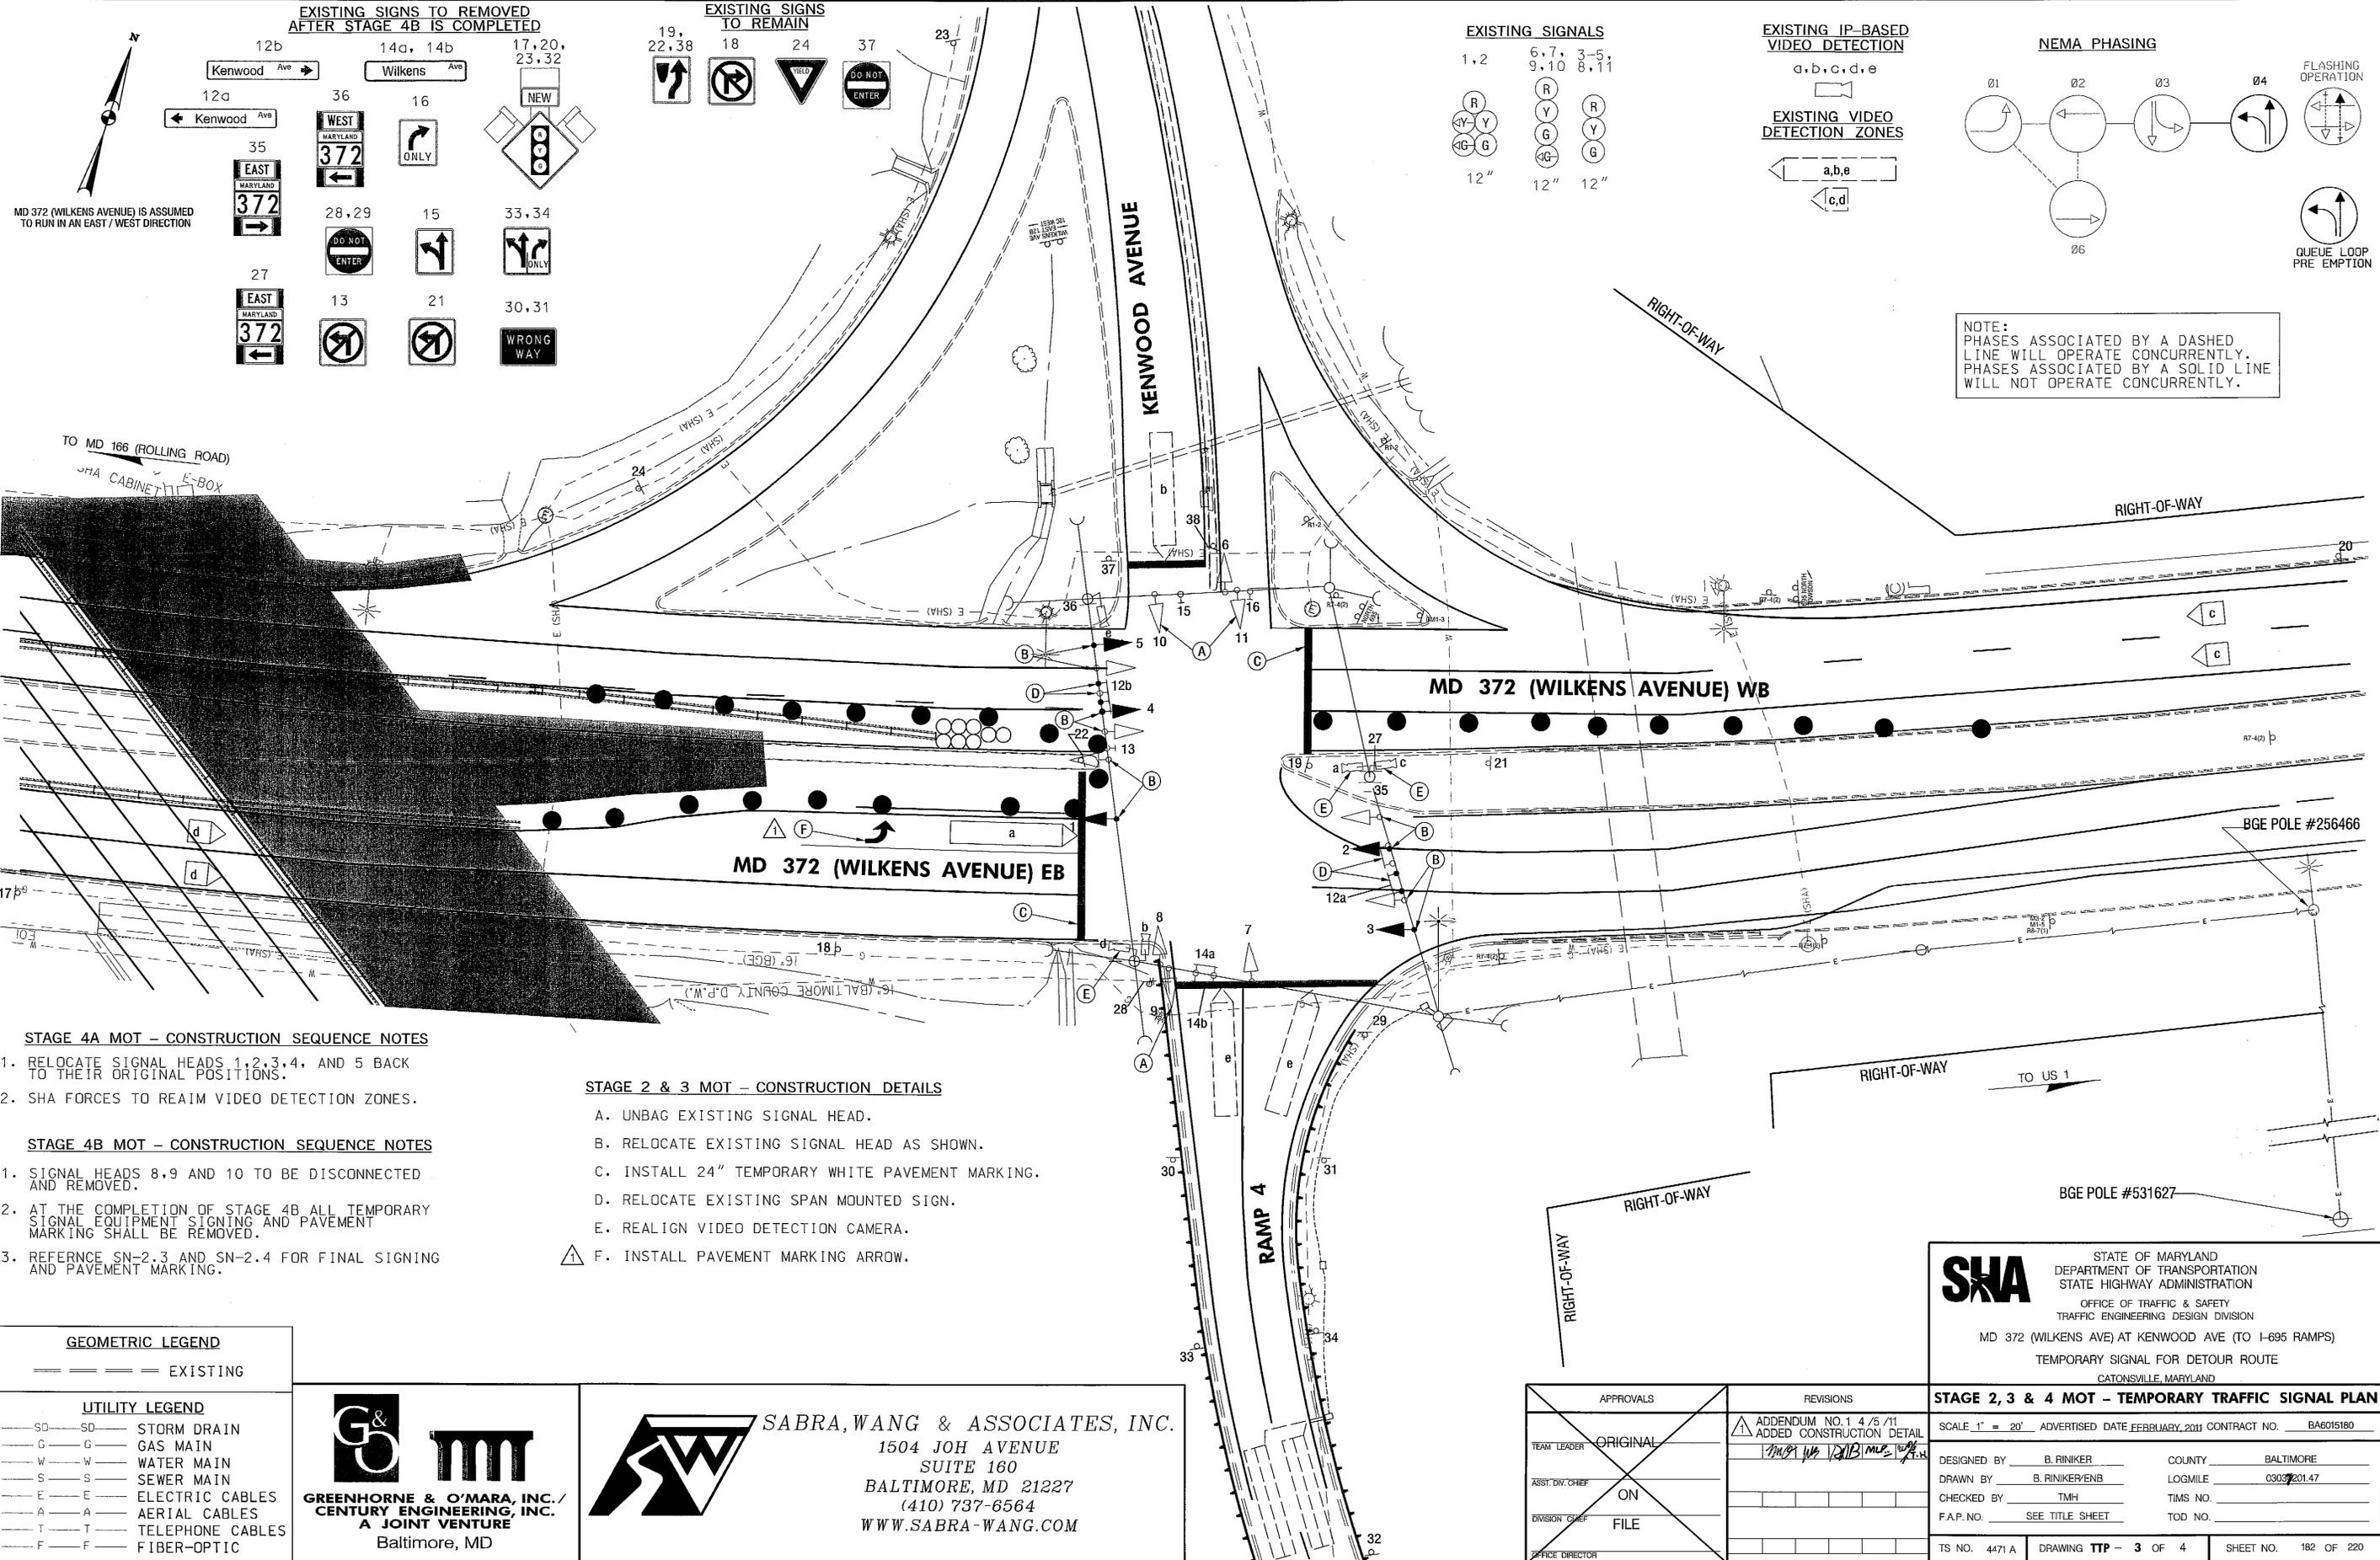

STAGE 4A MOT - CONSTRUCTION SEQUENCE NOTES

1. RELOCATE SIGNAL HEADS 1,2,3,4, AND 5 BACK TO THEIR ORIGINAL POSITIONS.
2. SHA FORCES TO REAIM VIDEO DETECTION ZONES.

STAGE 4B MOT - CONSTRUCTION SEQUENCE NOTES

1. SIGNAL HEADS 8,9 AND 10 TO BE DISCONNECTED AND REMOVED.
2. AT THE COMPLETION OF STAGE 4B ALL TEMPORARY SIGNAL EQUIPMENT SIGNING AND PAVEMENT MARKING SHALL BE REMOVED.
3. REFERENCE SN-2.3 AND SN-2.4 FOR FINAL SIGNING AND PAVEMENT MARKING.

STAGE 2 & 3 MOT - CONSTRUCTION DETAILS

- A. UNBAG EXISTING SIGNAL HEAD.
- B. RELOCATE EXISTING SIGNAL HEAD AS SHOWN.
- C. INSTALL 24" TEMPORARY WHITE PAVEMENT MARKING.
- D. RELOCATE EXISTING SPAN MOUNTED SIGN.
- E. REALIGN VIDEO DETECTION CAMERA.
- F. INSTALL PAVEMENT MARKING ARROW.

GEOMETRIC LEGEND



--- EXISTING

UTILITY LEGEND

- SD STORM DRAIN
- G GAS MAIN
- W WATER MAIN
- S SEWER MAIN
- E ELECTRIC CABLES
- A AERIAL CABLES
- T TELEPHONE CABLES
- F FIBER-OPTIC

EXISTING SIGNALS

1,2	6,7, 9,10	3-5, 8,11
(R) (Y) (G)	(R) (Y) (G)	(R) (Y) (G)
12"	12"	12"

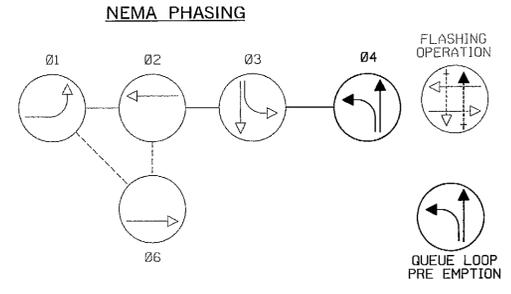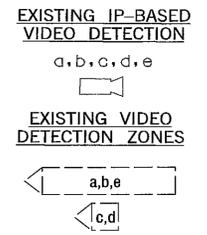

NOTE:
PHASES ASSOCIATED BY A DASHED LINE WILL OPERATE CONCURRENTLY.
PHASES ASSOCIATED BY A SOLID LINE WILL NOT OPERATE CONCURRENTLY.

BY: bostic -

APPROVALS

TEAM LEADER	ORIGINAL
ASST. DIV. CHIEF	ON
DIVISION CHIEF	FILE
OFFICE DIRECTOR	

REVISIONS

1	ADDENDUM NO. 1 4/5/11 ADDED CONSTRUCTION DETAIL
2	1/24/09 WBS 12/11/08 MLE 10/08

SHA STATE OF MARYLAND
DEPARTMENT OF TRANSPORTATION
STATE HIGHWAY ADMINISTRATION
OFFICE OF TRAFFIC & SAFETY
TRAFFIC ENGINEERING DESIGN DIVISION

MD 372 (WILKENS AVE) AT KENWOOD AVE (TO I-695 RAMP)

TEMPORARY SIGNAL FOR DETOUR ROUTE
CATONSVILLE, MARYLAND

STAGE 2, 3 & 4 MOT - TEMPORARY TRAFFIC SIGNAL PLAN

SCALE 1" = 20' ADVERTISED DATE FEBRUARY, 2011 CONTRACT NO. BA6015180

DESIGNED BY B. RINKER COUNTY BALTIMORE
DRAWN BY B. RINKER/ENB LOGMILE 03037201.47
CHECKED BY TMH TMS NO.
F.A.P. NO. SEE TITLE SHEET TOD NO.

TS NO. 4471 A DRAWING TTP - 3 OF 4 SHEET NO. 182 OF 220