MD 542 (LOCH RAVEN BLVD) AND TAYLOR AVENUE

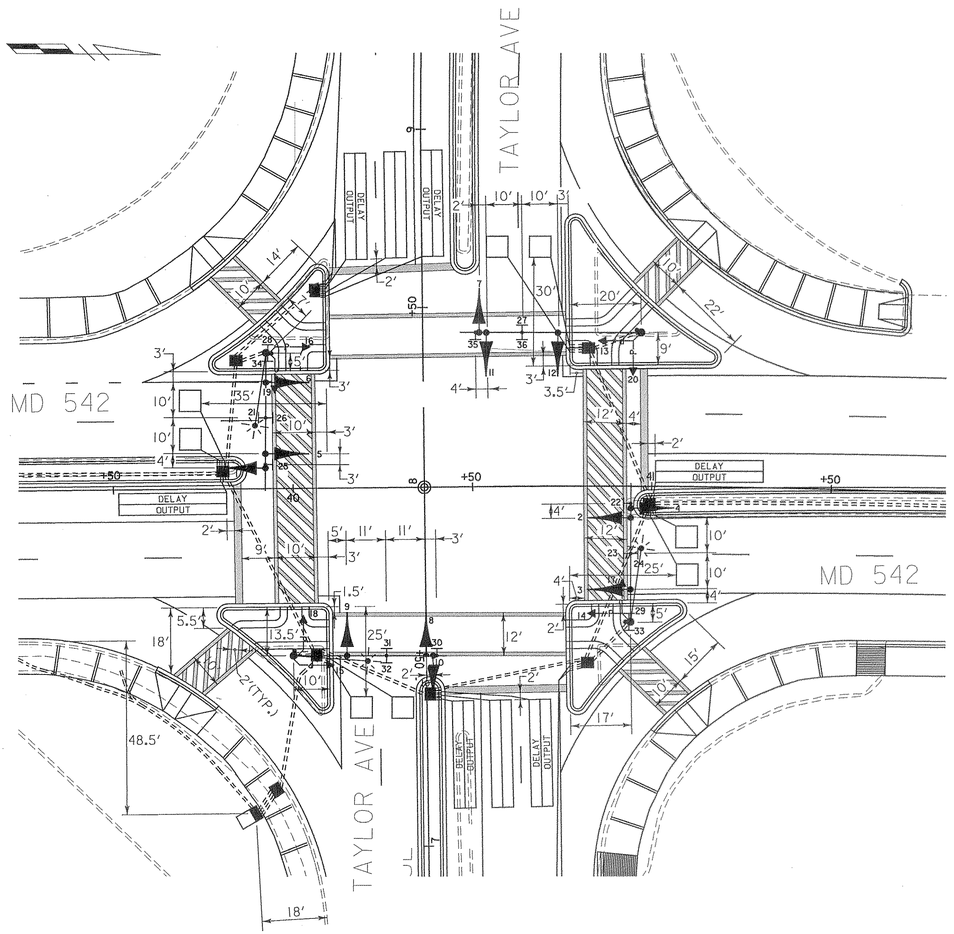

MD 542 (LOCH RAVEN BLVD) AND GLEN KEITH BLVD

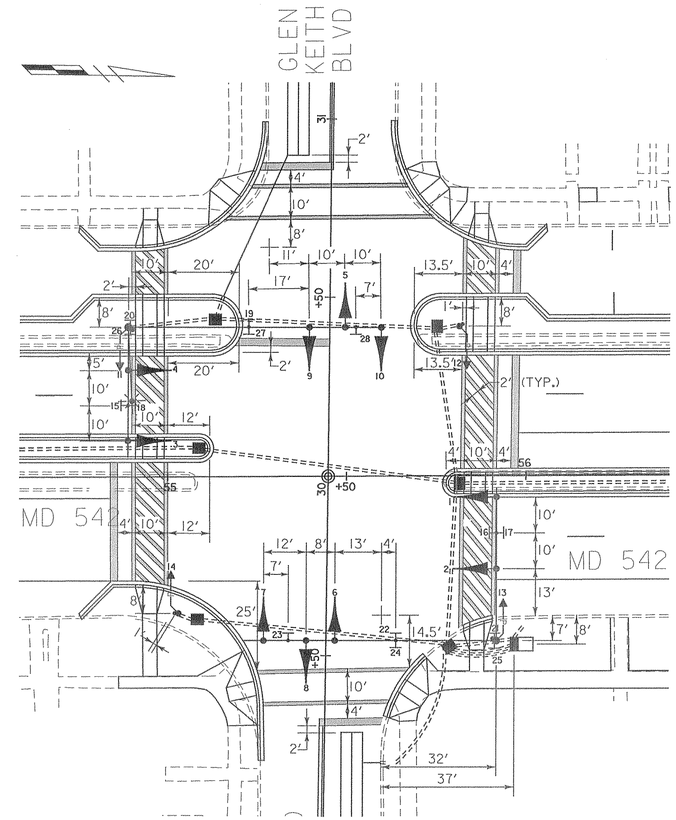

⚠ RELOCATE TRAFFIC SIGNAL POLES
ADDENDUM NO. 1 MAY 11, 2000

TSP-7

MARYLAND DOT - STATE HIGHWAY ADMINISTRATION
Office of Traffic & Safety
TRAFFIC ENGINEERING DESIGN DIVISION
DIMENSION DIAGRAM
MD 542 (LOCH RAVEN BLVD) INTERSECTIONS

WR&A
Whitman, Requardt and Associates, LLP
2315 Saint Paul Street
Baltimore, Maryland 21218
(410) 235-3450

DRAWN BY:	S.BLOSS	F.A.P. NO.	SEE TITLE SHEET	TS NO.	SHEET NO.
CHECKED BY:	N.LEARY	S.H.A. NO.	BA3225183		
SCALE:	1" = 20'	COUNTY:	BALTIMORE	T.I.M.S. NO.	OF
DATE:	5/2/00	LOG MILE:		D558	