F.H.W.A. REGION NO.	STATE	FED. AID PROJ. NO.	SHEET NO.	SHEETS
3	MD.			

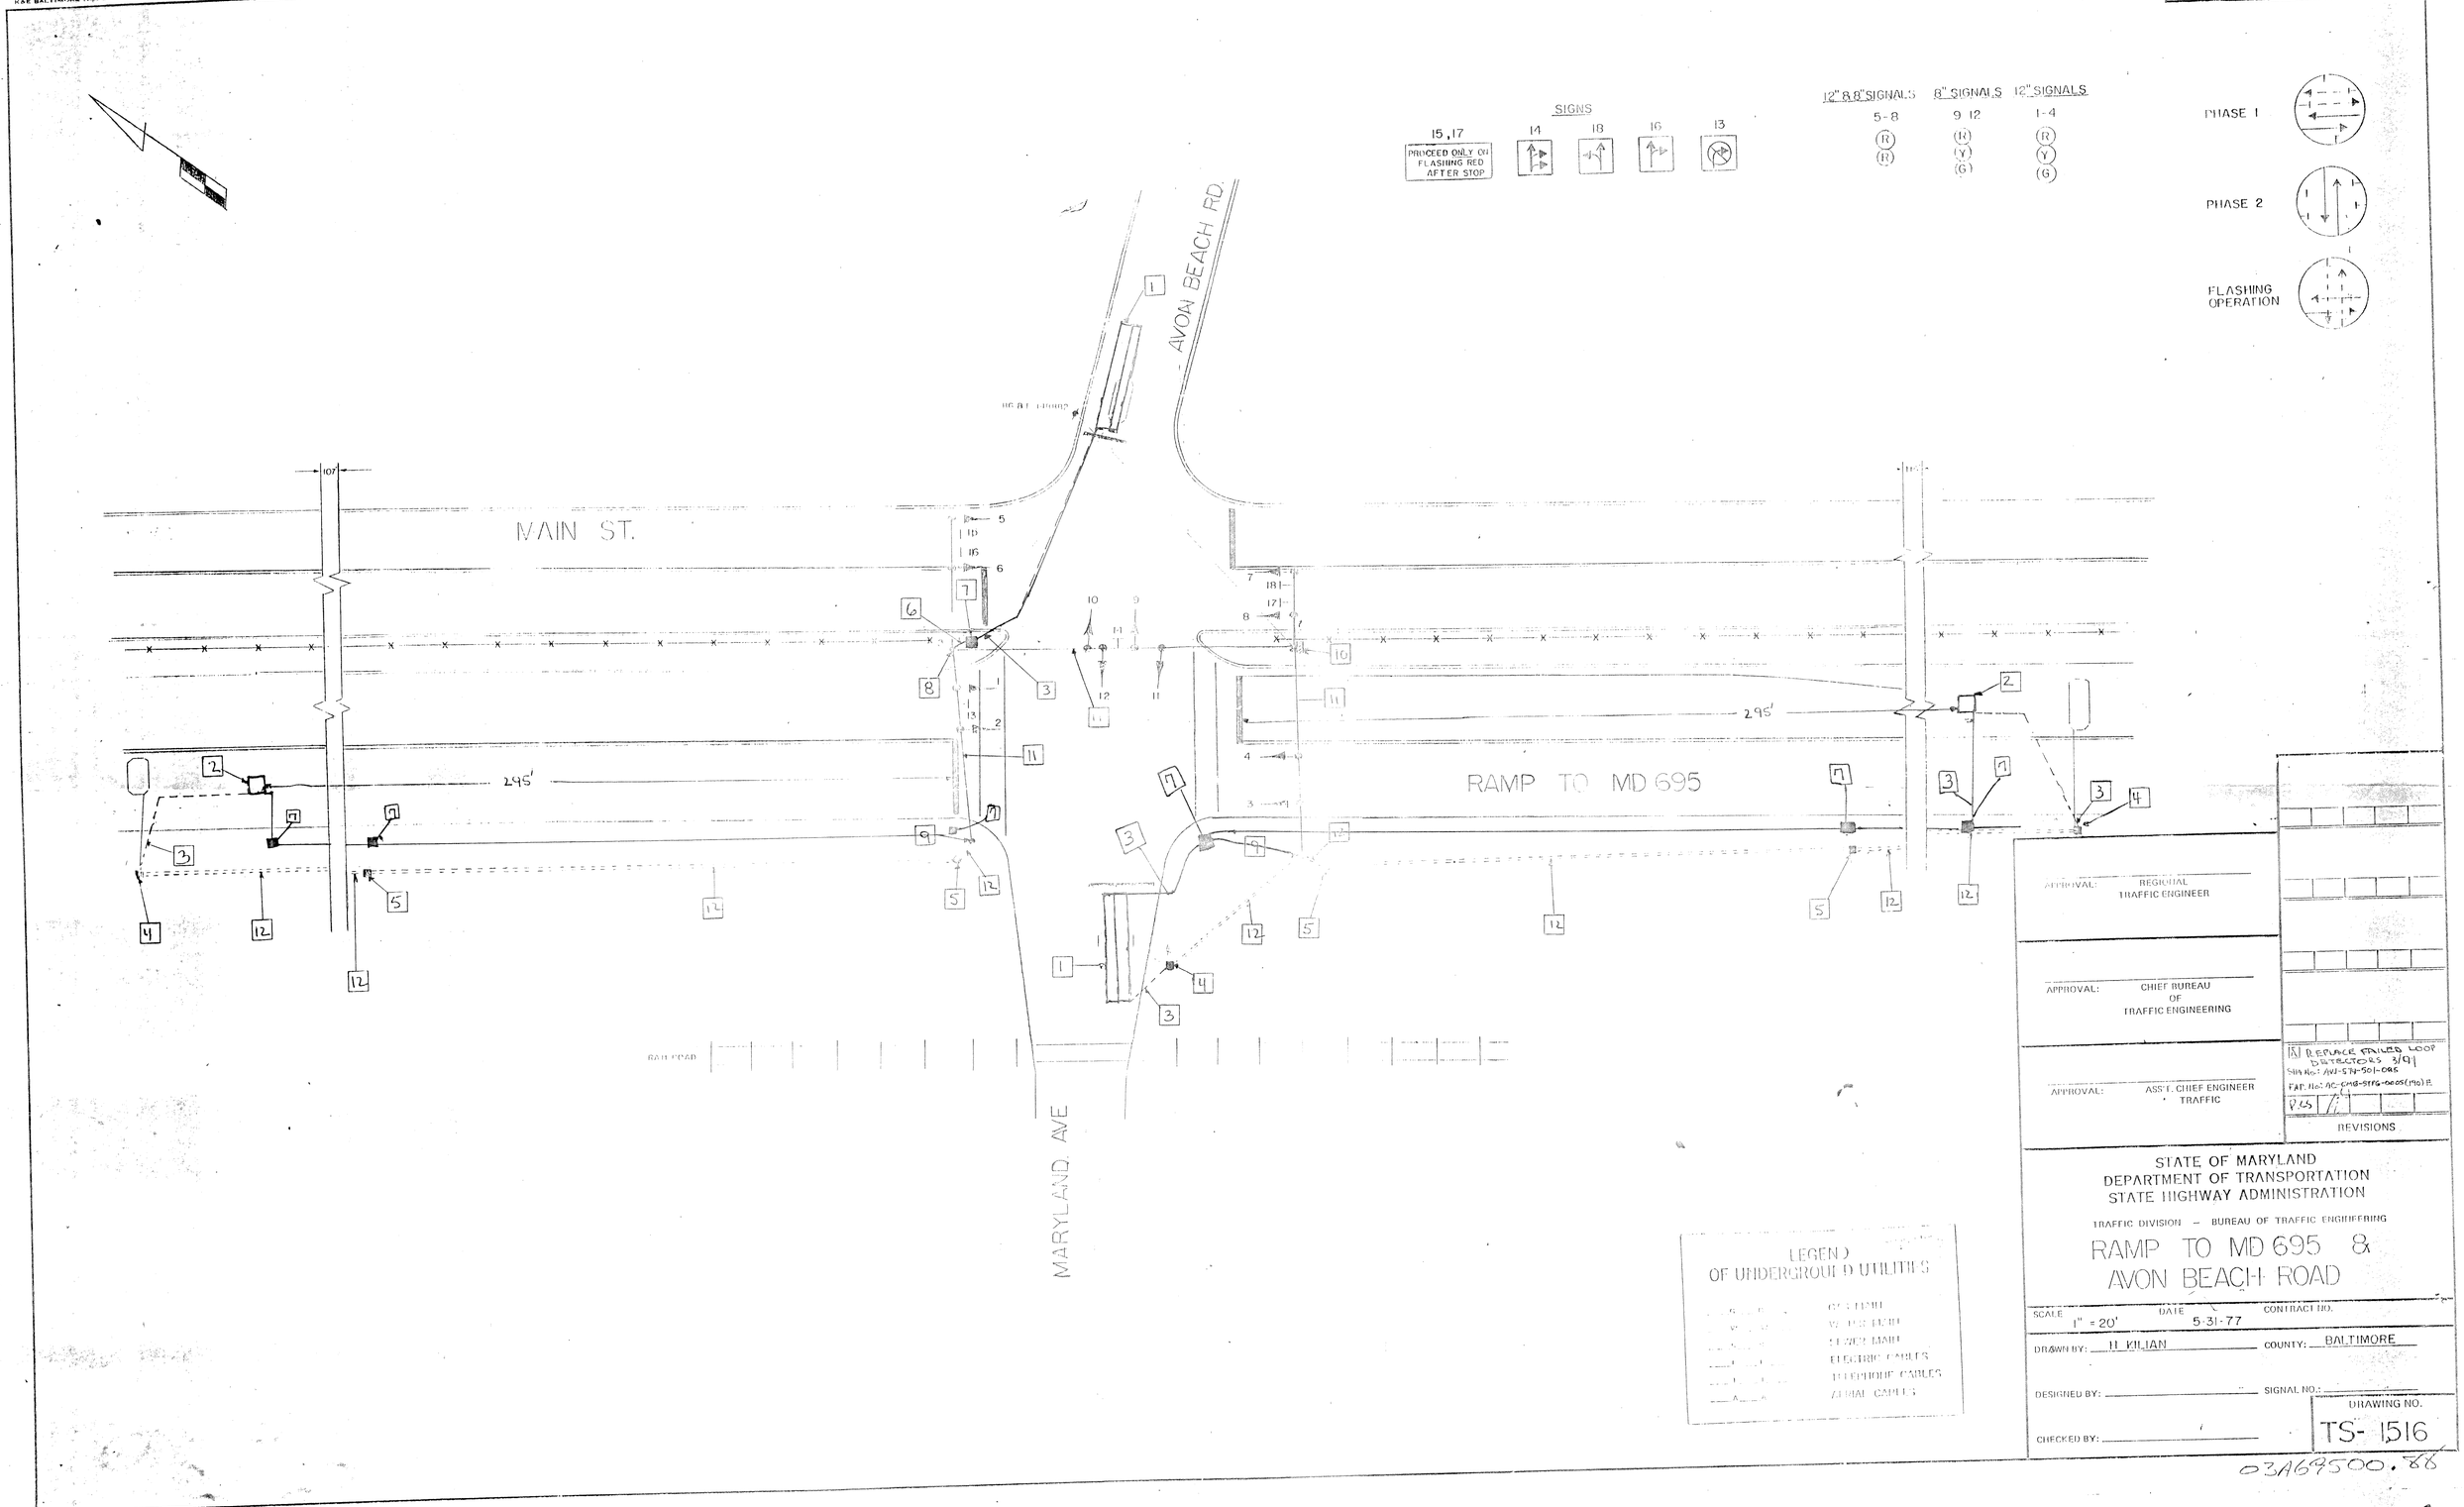

APPROVAL: REGIONAL TRAFFIC ENGINEER

APPROVAL: CHIEF BUREAU OF TRAFFIC ENGINEERING

APPROVAL: ASS'T. CHIEF ENGINEER TRAFFIC

REPLACE FAILED LOOP DETECTORS 3/91
SHA No: AW-574-501-095
FAP. No: AC-CMG-STPG-0005(190) E

REVISIONS

STATE OF MARYLAND
DEPARTMENT OF TRANSPORTATION
STATE HIGHWAY ADMINISTRATION

TRAFFIC DIVISION – BUREAU OF TRAFFIC ENGINEERING

RAMP TO MD 695 & AVON BEACH ROAD

SCALE 1" = 20' DATE 5-31-77 CONTRACT NO.

DRAWN BY: H. KILIAN COUNTY: BALTIMORE

DESIGNED BY: SIGNAL NO.:

CHECKED BY:

DRAWING NO. TS- 1516

03A69500.88

2