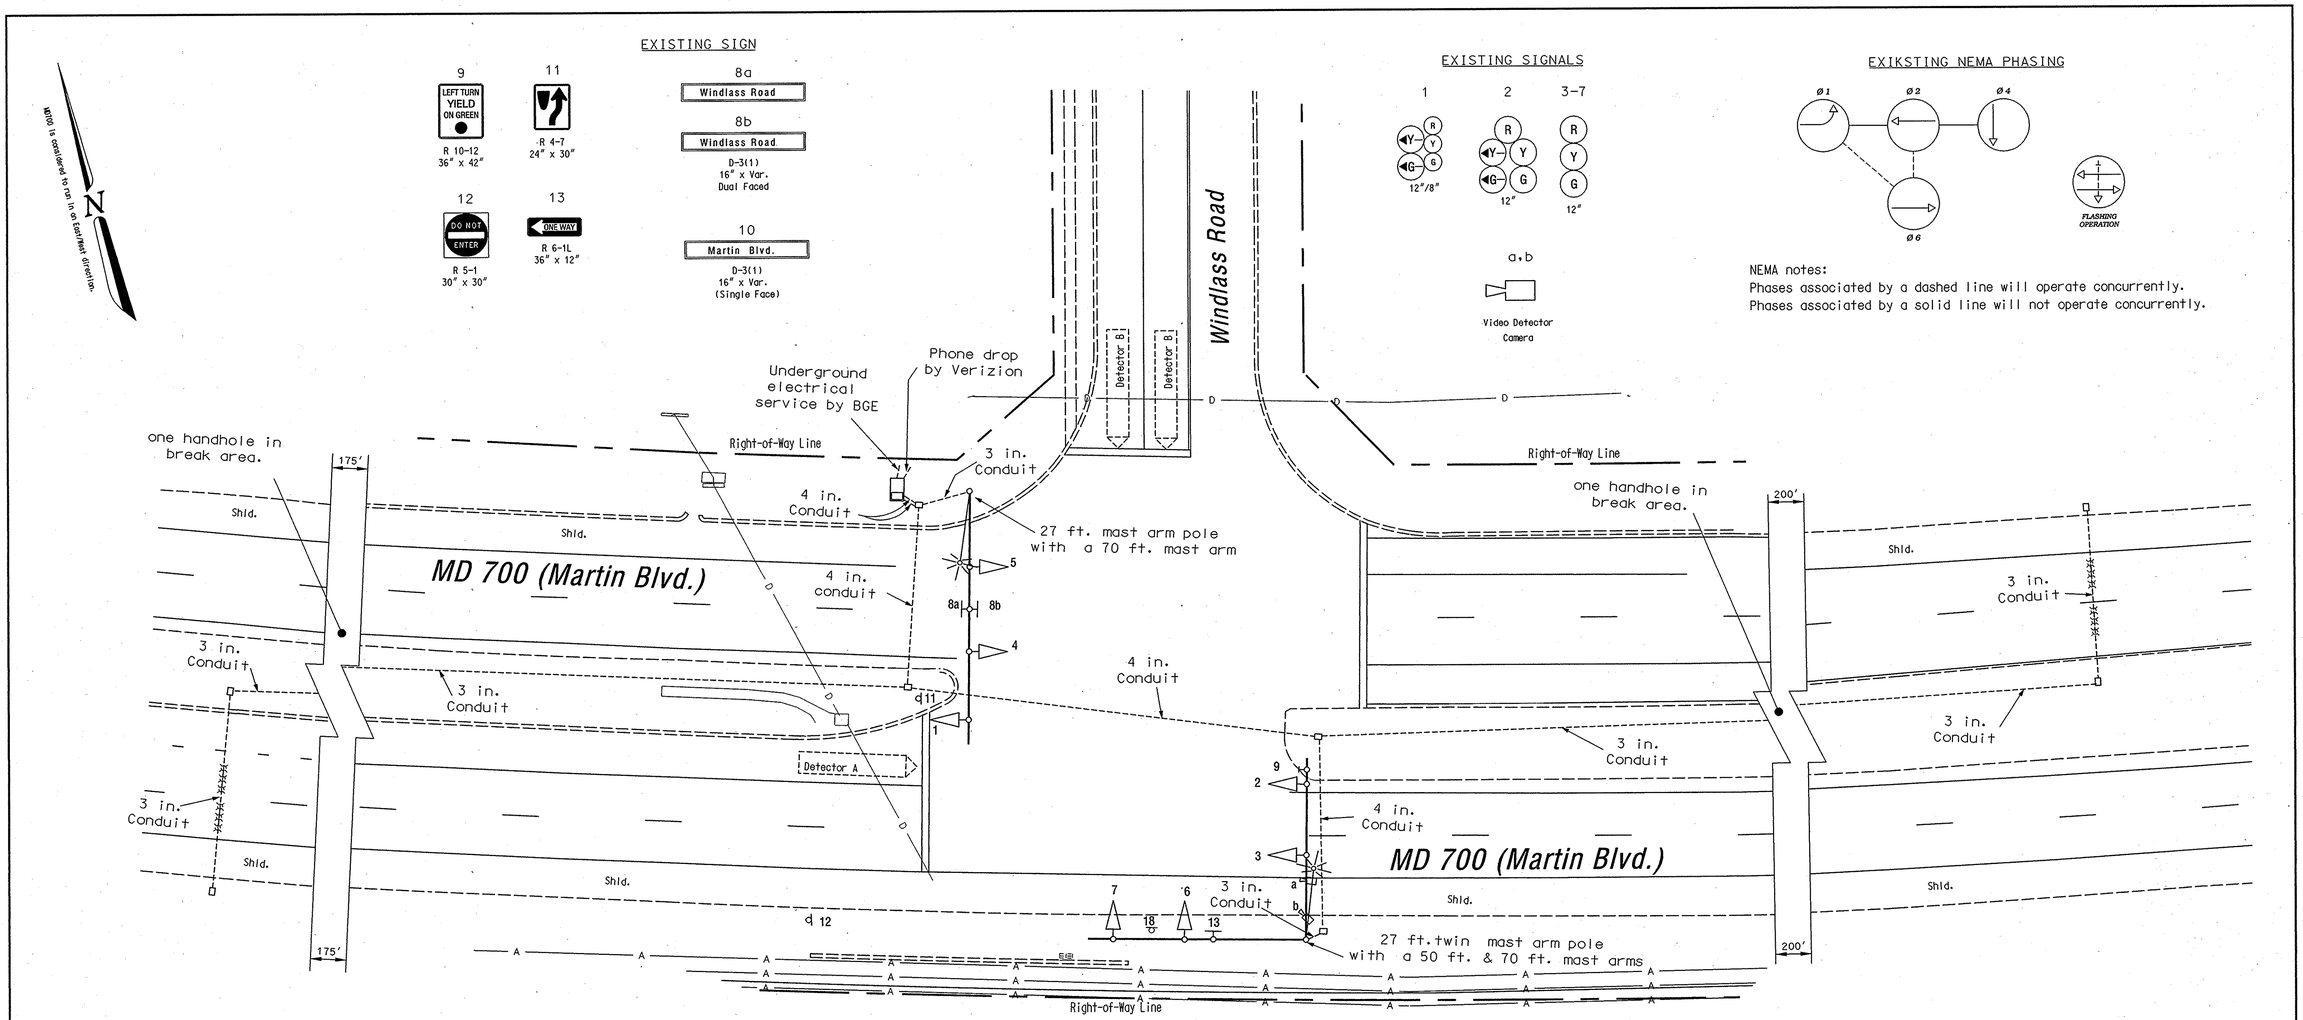

GEOMETRIC LEGEND	
	EXISTING GEOMETRICS
	PROPOSED GEOMETRICS

UTILITY LEGEND	
G	GAS MAIN
W	WATER MAIN
S	SEWER MAIN
E	ELECTRIC CABLES
D	STORM DRAIN
A	AERIAL CABLES
T	TELEPHONE CABLES

"AS-BUILT"

The Traffic Group

The Traffic Group, Inc.
410-931-6600
Fax 410-931-6601

REVISIONS	
AS-BUILT S.H.A. No.:BW996M82	June 22, 2005
FJH	

APPROVALS
TEAM LEADER, TRAFFIC ENGINEERING DESIGN DIVISION
ASST. CHIEF TRAFFIC ENGINEERING DESIGN DIVISION
CHIEF, TRAFFIC ENGINEERING DESIGN DIVISION
DIRECTOR, TRAFFIC & SAFETY

MARYLAND DOT - STATE HIGHWAY ADMINISTRATION
Office of Traffic & Safety
TRAFFIC ENGINEERING DESIGN DIVISION
(Traffic Signal Plan)

MD 700 (Martin Blvd.) at Windlass Road

DRAWN BY:	Frank Hoeckel	F.A.P. NO.	N/A	TS NO. 4317	SHEET NO.
CHECKED BY:		S.H.A. NO.	BW996M82		
SCALE:	1" = 20'	COUNTY:	Baltimore	T.I.M.S. NO. G371	1 OF 1
DATE:	June 4, 2004	LOG MILE:	03070000.85		

f:\2003\2003-0810\dwg\AS-built-signal.dgn 6/20/2005