F H WA REGION NO	STATE	FED. AID PROJ. NO	SHEET NO.	TOTAL SHEETS
3	MD.	M-3038 (2)		

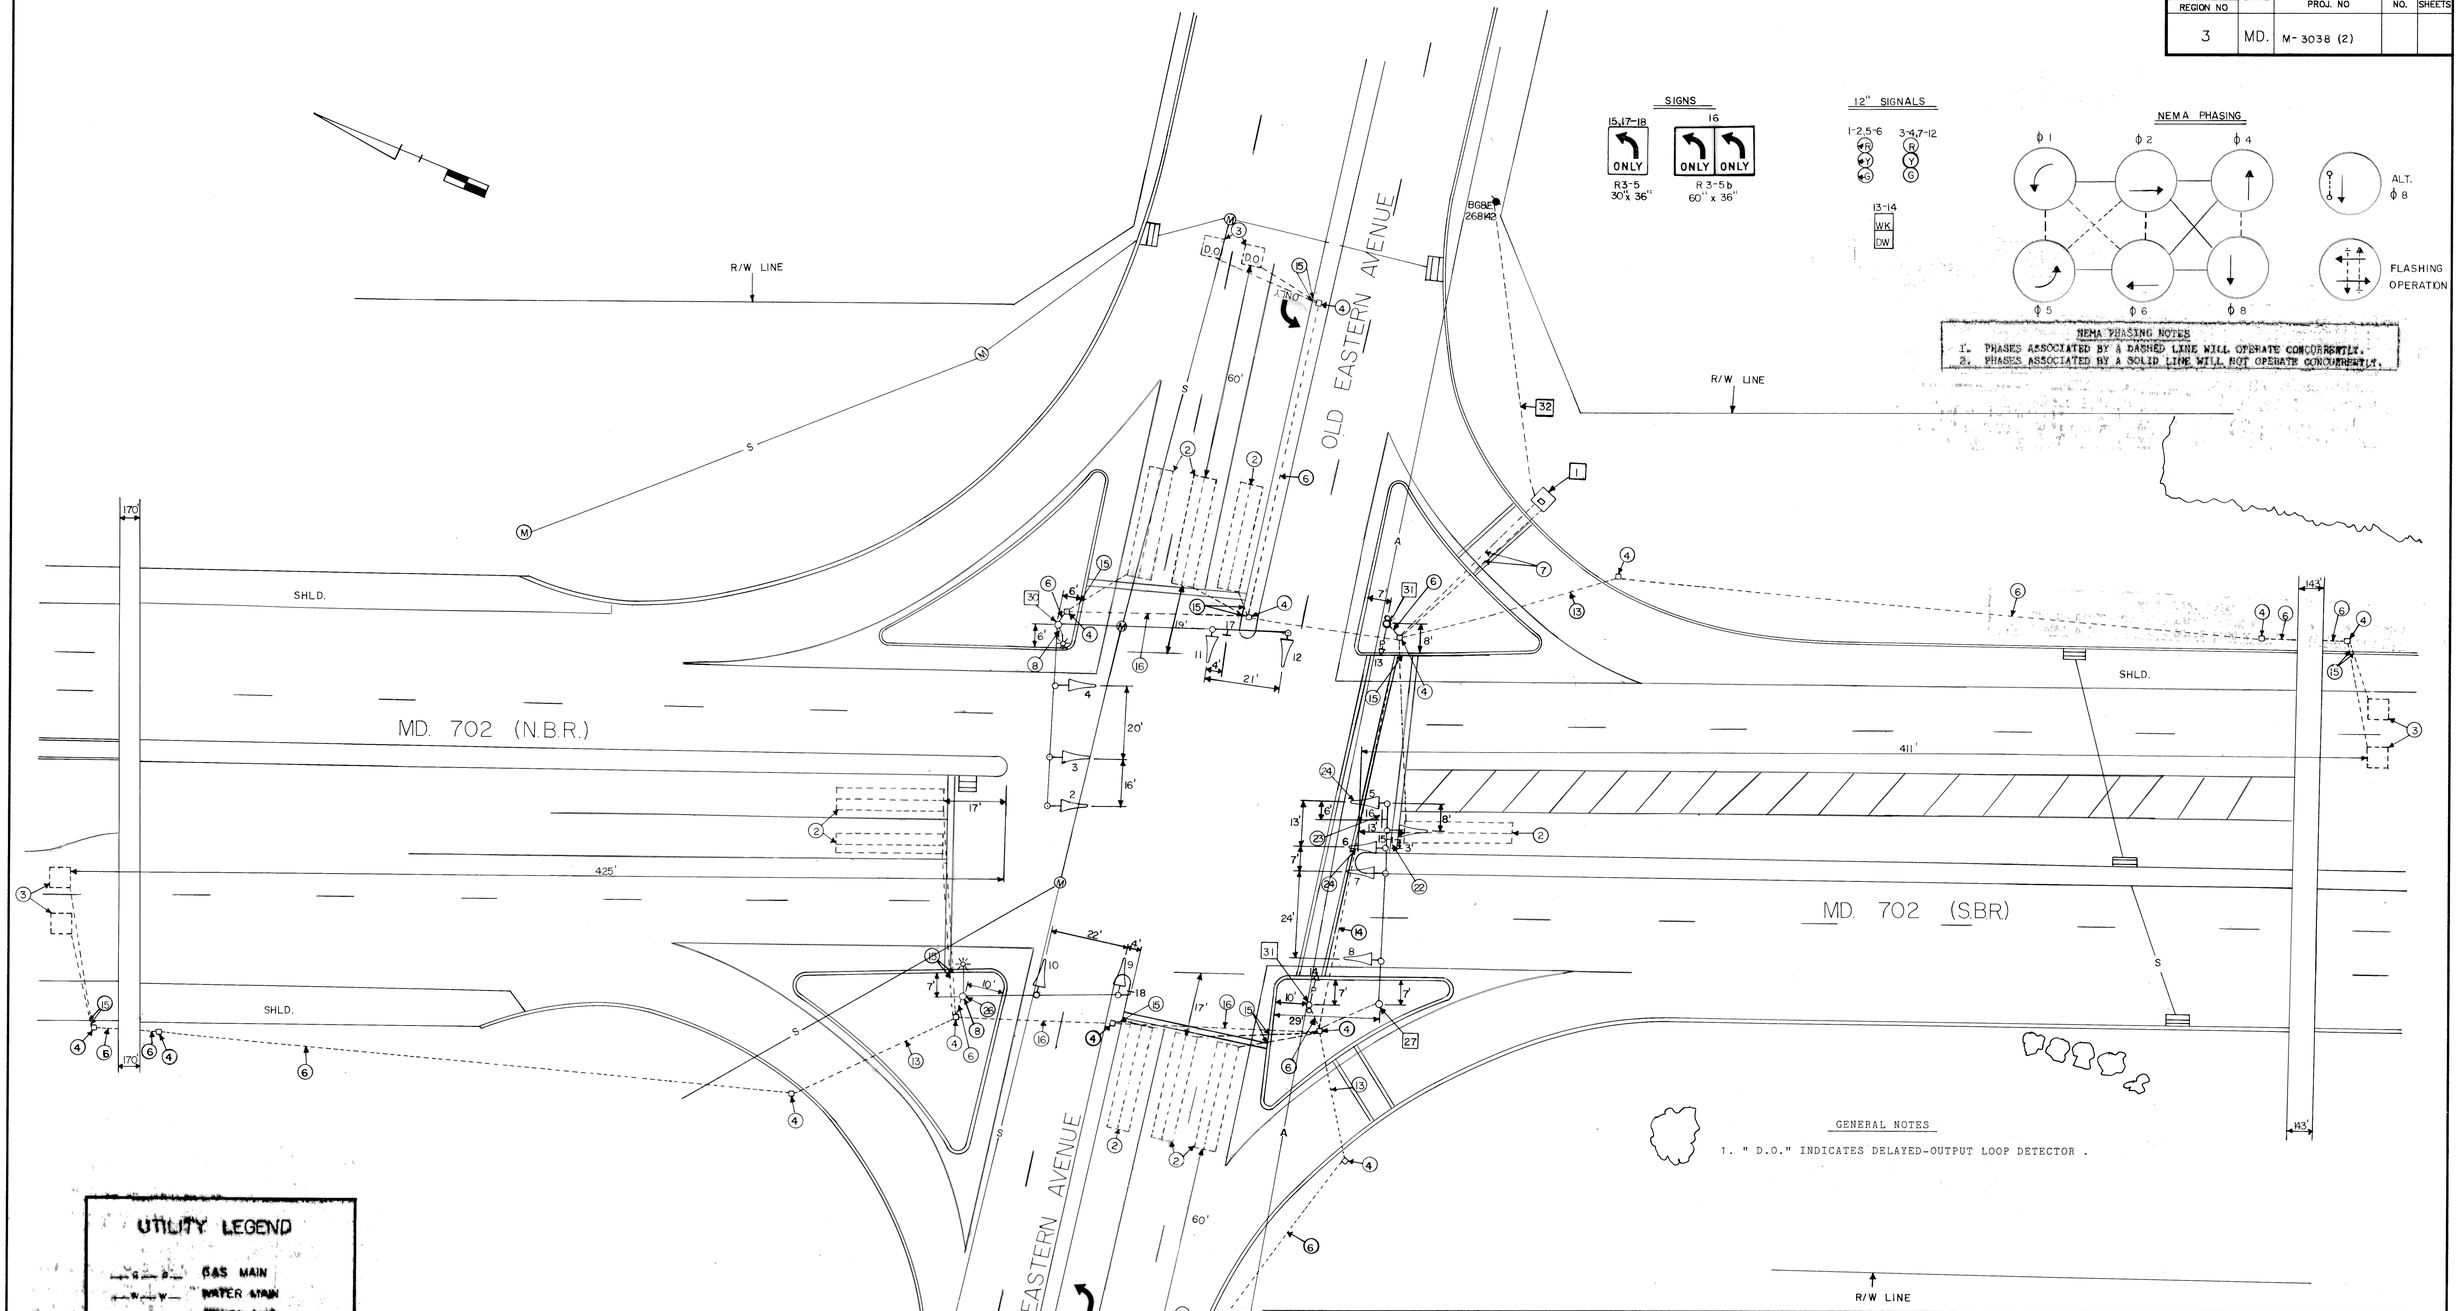

REVISIONS	APPROVALS
A SHA NO. B-546-502-471 6-17-89 RELOCATE S/E CORNER MAST ARM TO N/E CORNER. EGA	CHIEF, SIGNAL DESIGN SECTION 5/1/87
	ASST. DISTRICT ENGINEER, TRAFFIC 10/26/87
	CHIEF, BUREAU OF TRAFFIC ENGINEERING 2-26-87
	DEPUTY CHIEF ENGINEER, OFFICE OF TRAFFIC 10/28/87

MARYLAND DEPARTMENT OF TRANSPORTATION
STATE HIGHWAY ADMINISTRATION – OFFICE OF TRAFFIC
BUREAU OF TRAFFIC ENGINEERING

DRAWN BY: GENE SIMMERS
DES. BY: GENE SIMMERS
CHK. BY: 2/26/87

MD. 702 AT OLD EASTERN AVENUE

COUNTY: BALTIMORE

DATE: 2-10-87
SCALE: 1" = 20'
F.A.P. NO. M-3038 (2)
S.H.A. NO. B-546-502-471
TS/FILE NO. 1220 A
SHEET NO. ___ OF ___

03070208.01

Folder 12