FHWA REGION NO	STATE	FED. AID PROJ. NO	SHEET NO.	TOTAL SHEETS
3	MD.		154D	197

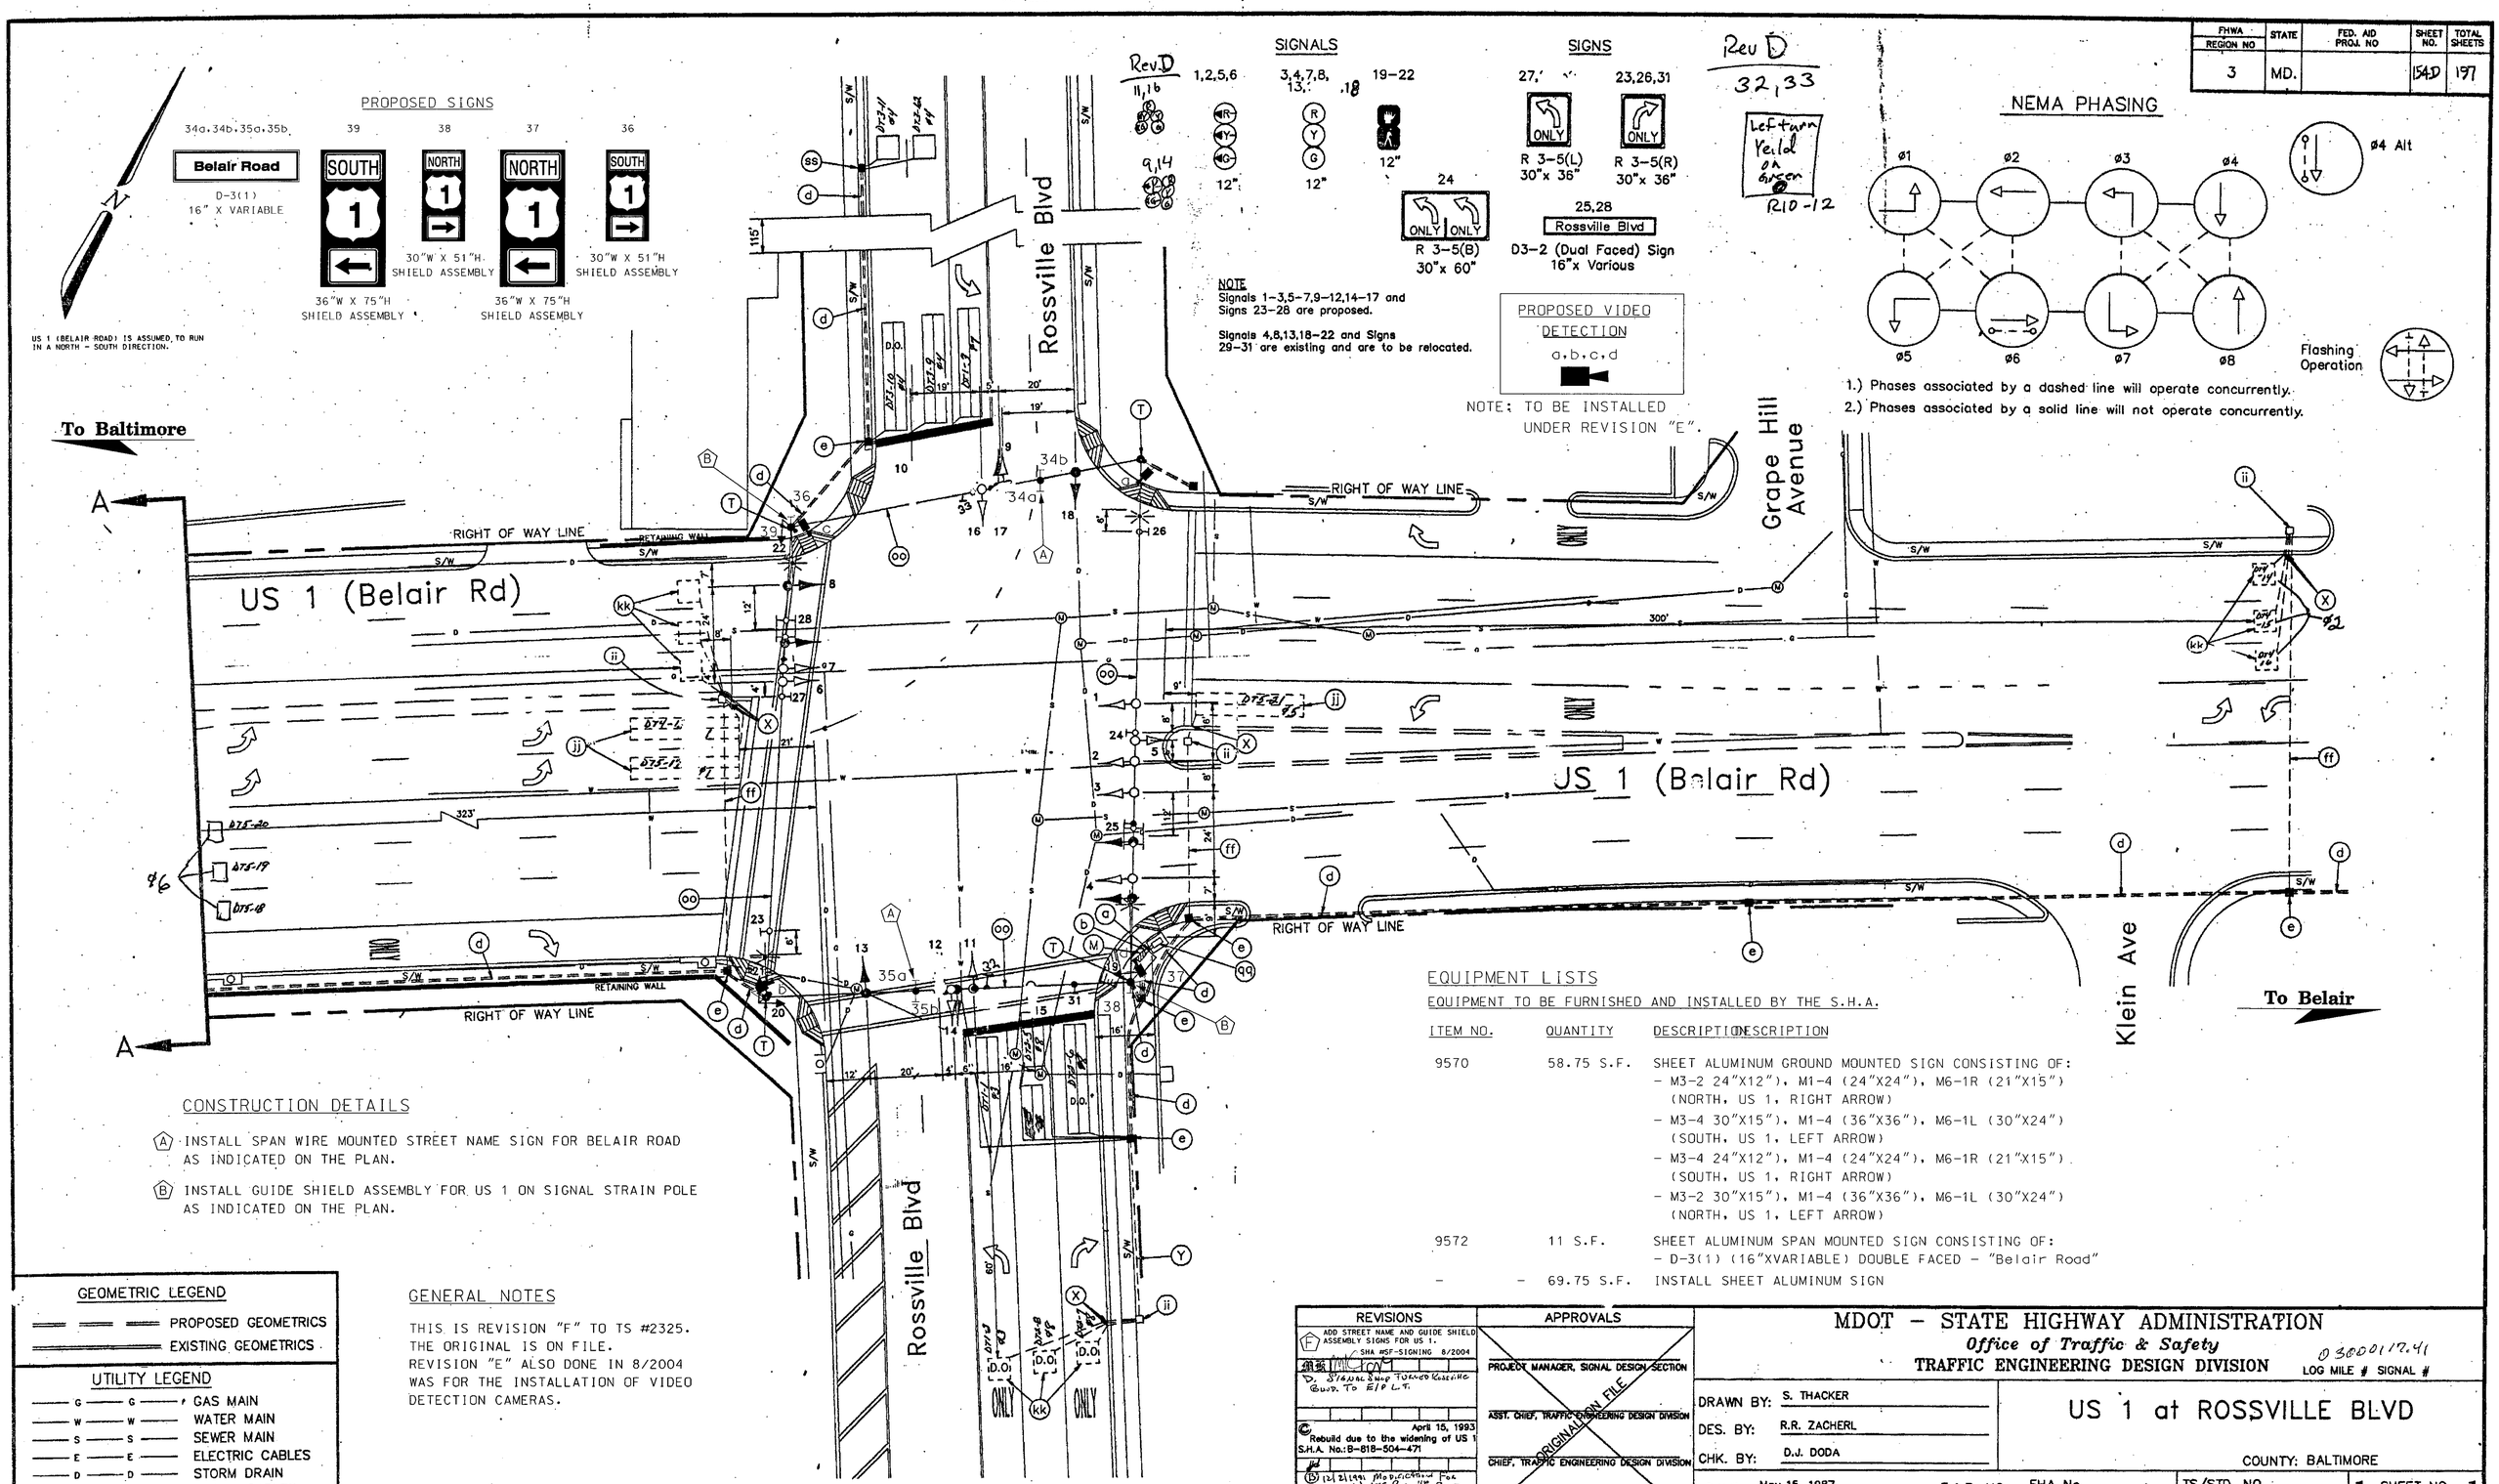

EQUIPMENT LISTS

EQUIPMENT TO BE FURNISHED AND INSTALLED BY THE S.H.A.

ITEM NO.	QUANTITY	DESCRIPTION DESCRIPTION
9570	58.75 S.F.	SHEET ALUMINUM GROUND MOUNTED SIGN CONSISTING OF: - M3-2 24"X12"), M1-4 (24"X24"), M6-1R (21"X15") (NORTH, US 1, RIGHT ARROW) - M3-4 30"X15"), M1-4 (36"X36"), M6-1L (30"X24") (SOUTH, US 1, LEFT ARROW) - M3-4 24"X12"), M1-4 (24"X24"), M6-1R (21"X15") (SOUTH, US 1, RIGHT ARROW) - M3-2 30"X15"), M1-4 (36"X36"), M6-1L (30"X24") (NORTH, US 1, LEFT ARROW)
9572	11 S.F.	SHEET ALUMINUM SPAN MOUNTED SIGN CONSISTING OF: - D-3(1) (16"XVARIABLE) DOUBLE FACED - "Belair Road"
-	- 69.75 S.F.	INSTALL SHEET ALUMINUM SIGN

CONSTRUCTION DETAILS

(A) INSTALL SPAN WIRE MOUNTED STREET NAME SIGN FOR BELAIR ROAD AS INDICATED ON THE PLAN.

(B) INSTALL GUIDE SHIELD ASSEMBLY FOR US 1 ON SIGNAL STRAIN POLE AS INDICATED ON THE PLAN.

GENERAL NOTES

THIS IS REVISION "F" TO TS #2325.
THE ORIGINAL IS ON FILE.
REVISION "E" ALSO DONE IN 8/2004
WAS FOR THE INSTALLATION OF VIDEO
DETECTION CAMERAS.

GEOMETRIC LEGEND

PROPOSED GEOMETRICS
EXISTING GEOMETRICS

UTILITY LEGEND

G — GAS MAIN
W — WATER MAIN
S — SEWER MAIN
E — ELECTRIC CABLES
D — STORM DRAIN
A — AERIAL CABLES
T — TELEPHONE CABLES

REVISIONS

(F) ADD STREET NAME AND GUIDE SHIELD ASSEMBLY SIGNS FOR US 1. SHA #SF-SIGNING 8/2004
(E) 8/2004 MC FOW
D. SIGNAL & MOD TURNBOUT CHANGE TO E/P L.T.
(C) April 15, 1993 Rebuild due to the widening of US 1 S.H.A. No.:B-818-504-471
(B) 12/21/1990 MODIFICATION FOR NEW WEBER ROSSVILLE BLVD.
CJ DSD DAZ EFP TH

APPROVALS

PROJECT MANAGER, SIGNAL DESIGN SECTION
ASST. CHIEF, TRAFFIC ENGINEERING DESIGN DIVISION
CHIEF, TRAFFIC ENGINEERING DESIGN DIVISION
DIRECTOR, OFFICE OF TRAFFIC & SAFETY
ORIGINAL ON FILE

MDOT - STATE HIGHWAY ADMINISTRATION
Office of Traffic & Safety
TRAFFIC ENGINEERING DESIGN DIVISION

0 3000117.41
LOG MILE # SIGNAL #

DRAWN BY: S. THACKER
DES. BY: R.R. ZACHERL
CHK. BY: D.J. DODA

US 1 at ROSSVILLE BLVD

COUNTY: BALTIMORE

DATE: May 15, 1987
SCALE: 1" = 20'
F.A.P. NO. FHA No
S.H.A. NO. SHA No

TS/STD. NO. 2325 C D F

SHEET NO. 1 OF 197 (154D)