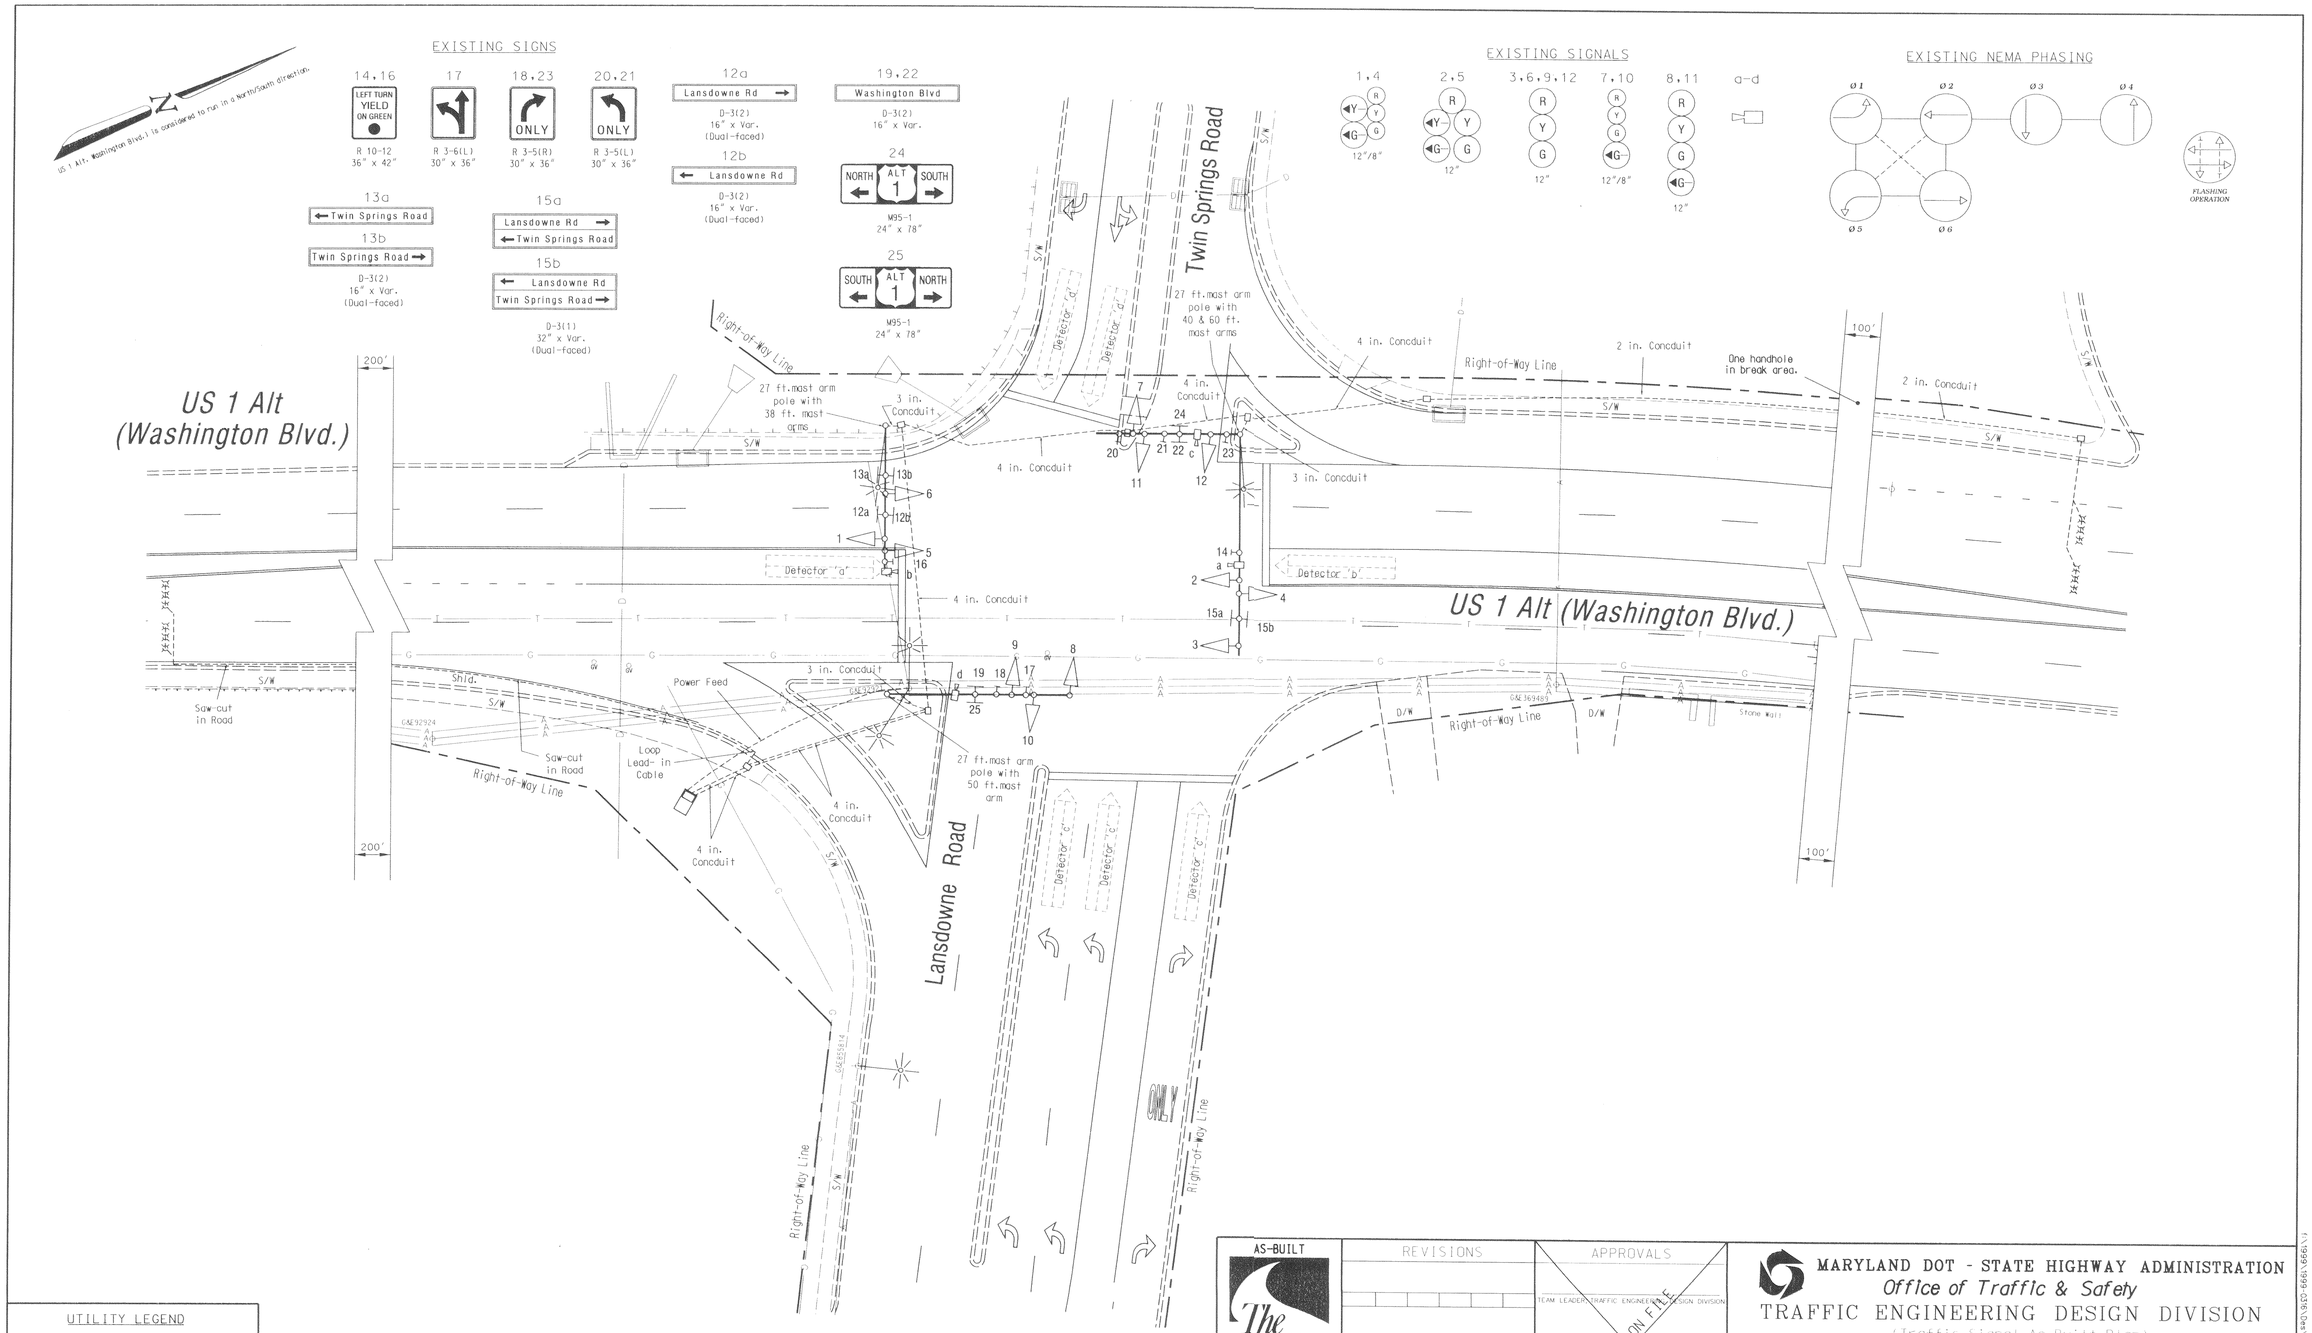

UTILITY LEGEND

G	GAS MAIN
W	WATER MAIN
S	SEWER MAIN
E	ELECTRIC CABLES
D	STORM DRAIN
A	AERIAL CABLES
T	TELEPHONE CABLES

AS-BUILT

The Traffic Group

The Traffic Group, Inc.
410-931-6600
Fax 410-931-6601

REVISIONS

AS-BUILT		July 18, 2005
FJH		
D	Rebuild signal, add fourth leg to intersection. S.H.A. No.:BW996M82	May 6, 2002
FDB		

APPROVALS

ORIGINAL ON FILE

TEAM LEADER, TRAFFIC ENGINEERING DESIGN DIVISION

ASST. CHIEF TRAFFIC ENGINEERING DESIGN DIVISION

CHIEF, TRAFFIC ENGINEERING DESIGN DIVISION

DIRECTOR, TRAFFIC & SAFETY

MARYLAND DOT - STATE HIGHWAY ADMINISTRATION

Office of Traffic & Safety

TRAFFIC ENGINEERING DESIGN DIVISION

(Traffic Signal As-Built Plan)

US 1 Alt (Washington Blvd.) at Lansdowne Road./Twin Springs Road

DRAWN BY: W. Richardson	F.A.P. NO. N/A	TS NO. 465D	SHEET NO.
CHECKED BY:	S.H.A. NO. N/A	T.I.M.S. NO. F052	1 OF 1
SCALE: 1" = 20'	COUNTY: Baltimore		
DATE:	LOG MILE: 03400102.33		

I:\1999\1999-03\Dwg\AS-BUILT.dgn 8/9/2005