K&E 19 1153 6-81 MC 2647

F.H.W.A. REGION NO.	STATE	FED. AID PROJ. NO.	SHEET NO.	TOTAL SHEETS
3	MD.	FR-PRE-2617-1(7)	13	15

NOTES

1. SOME HANDBOXES TO BE CONSTRUCTED IN CONCRETE S/W
2. ALL SIDE STREET 6'x6' LOOP DET. TO BE DELAY OUTPUT
3. CROSSWALK & STOP BAR FOR NB US.1 ARE PROPOSED

PHASE SEQUENCE
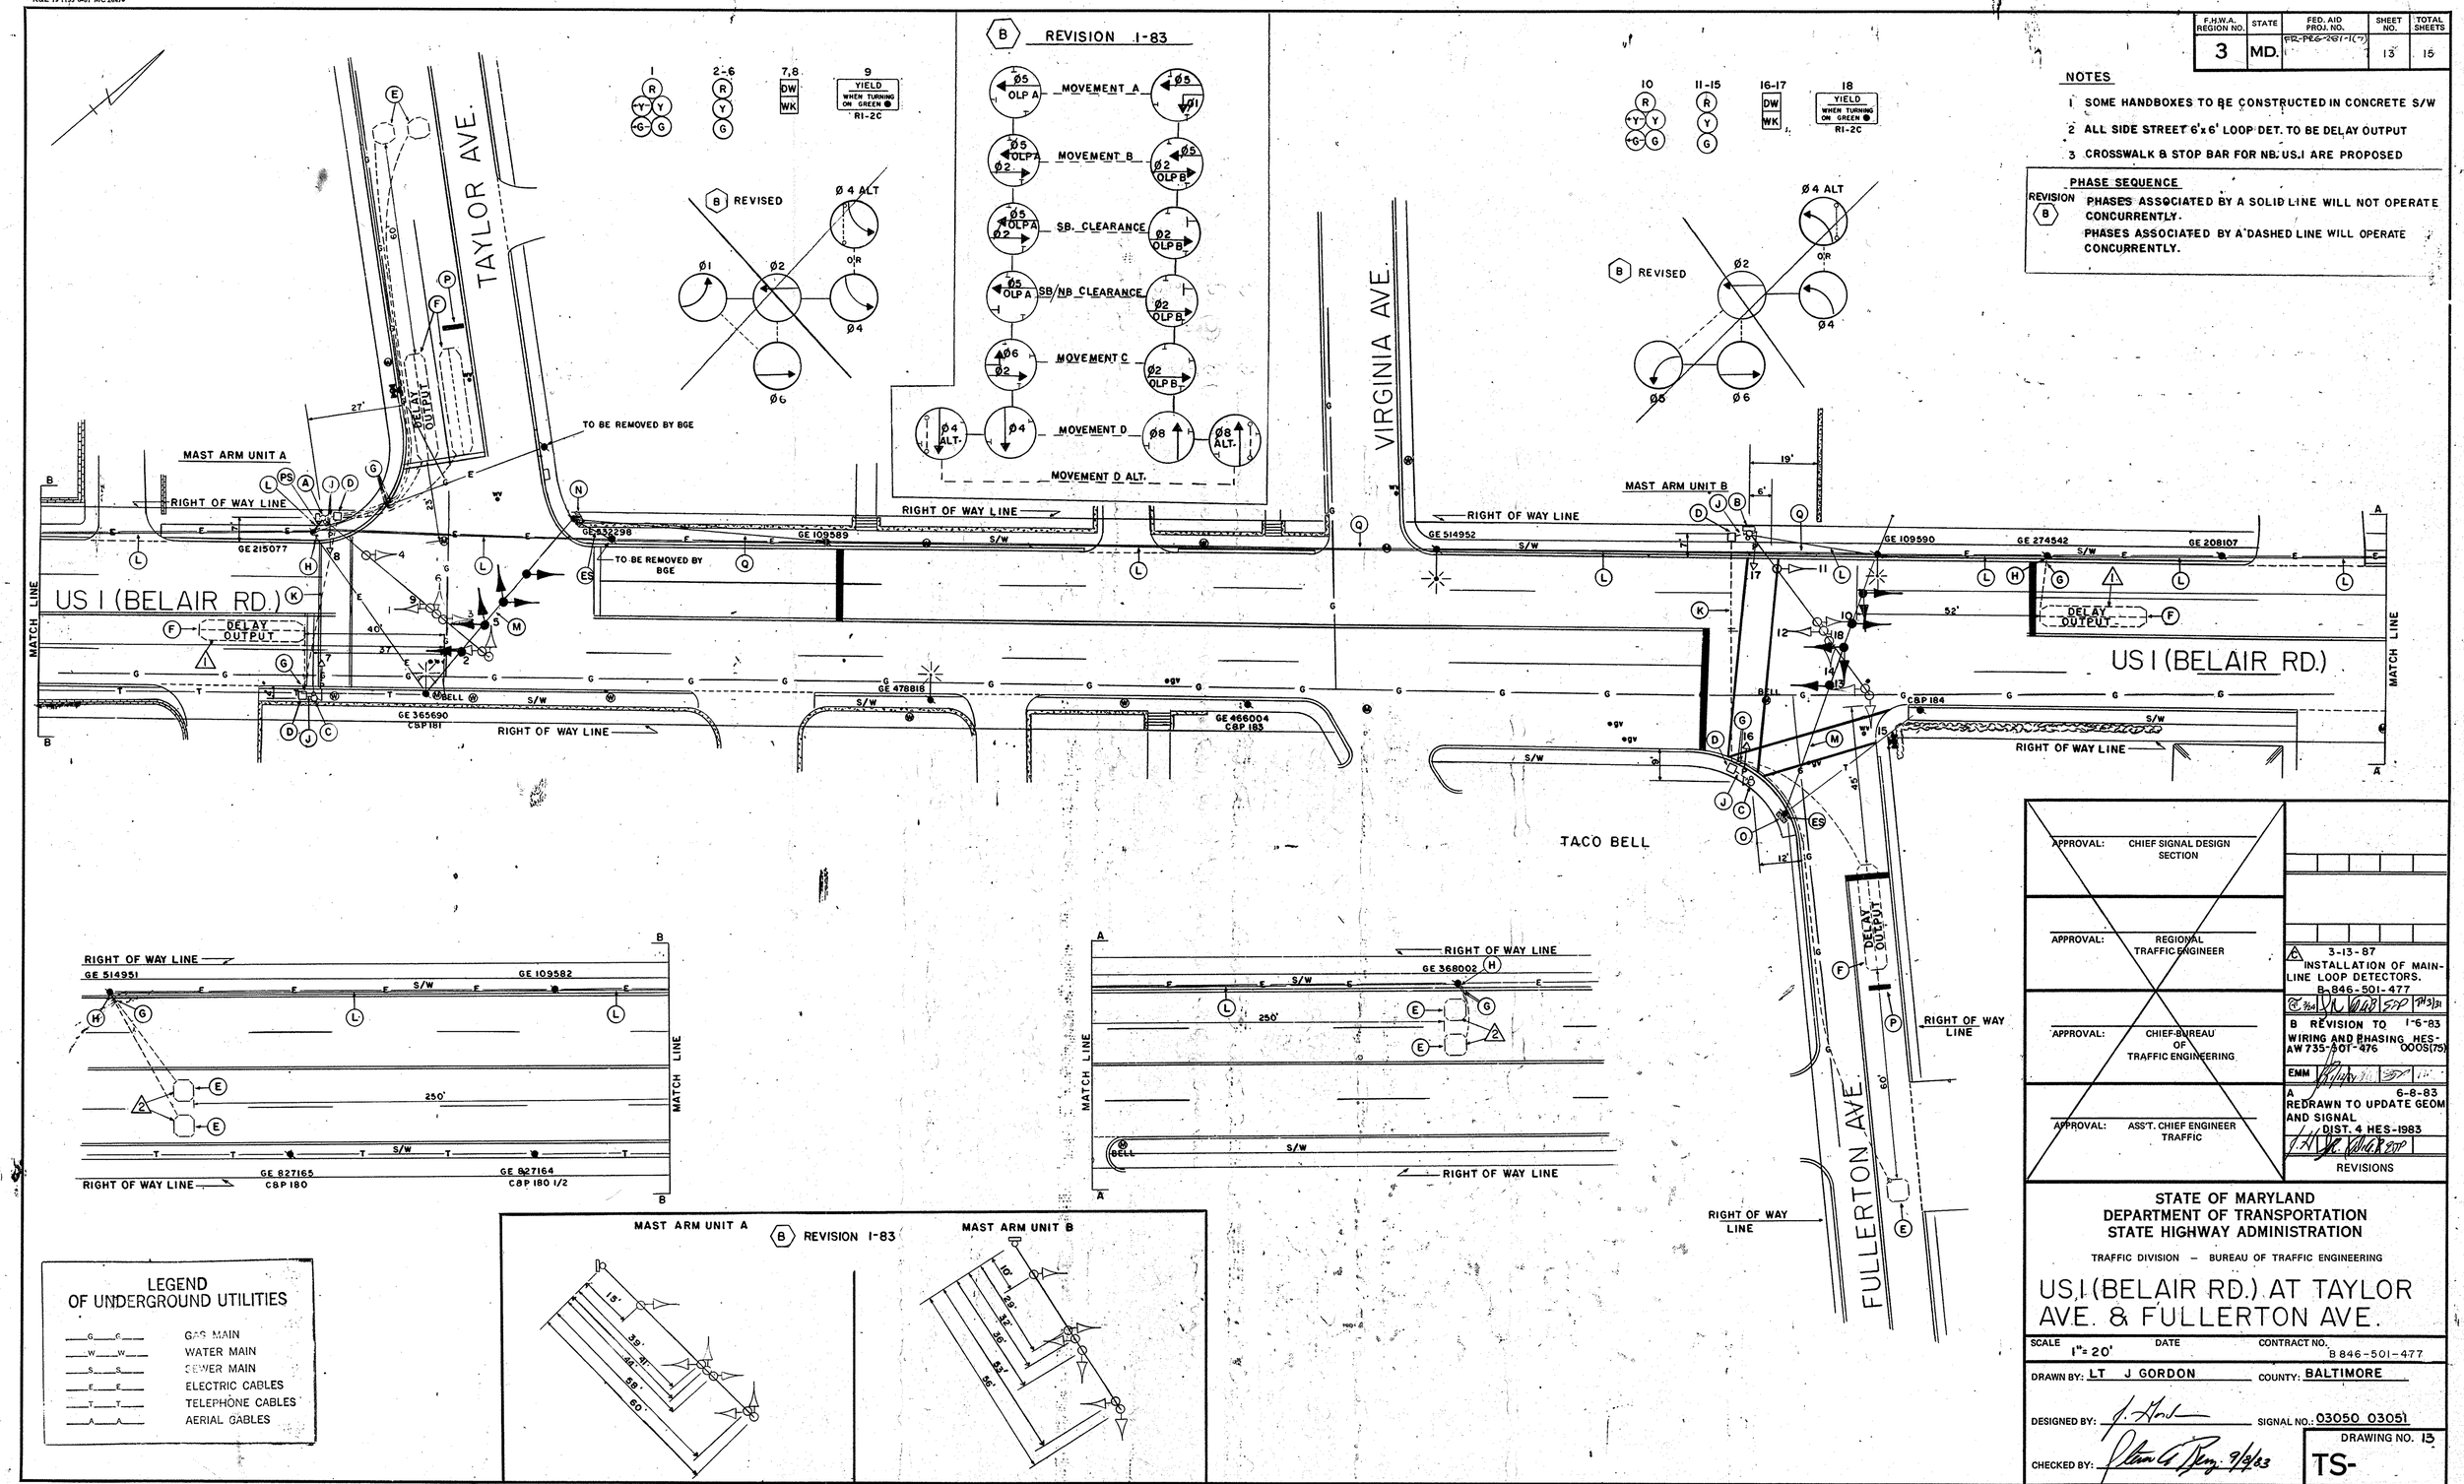
REVISION (B) PHASES ASSOCIATED BY A SOLID LINE WILL NOT OPERATE CONCURRENTLY.
PHASES ASSOCIATED BY A DASHED LINE WILL OPERATE CONCURRENTLY.