K&E BALTIMORE 17 0153 PHOENIX 10-75 MC 4156

F.H.W.A. REGION NO.	STATE	FED. AID PROJ. NO.	SHEET NO.	TOTAL SHEETS
3	MD.	PR-PRG-281-(7)	14	15

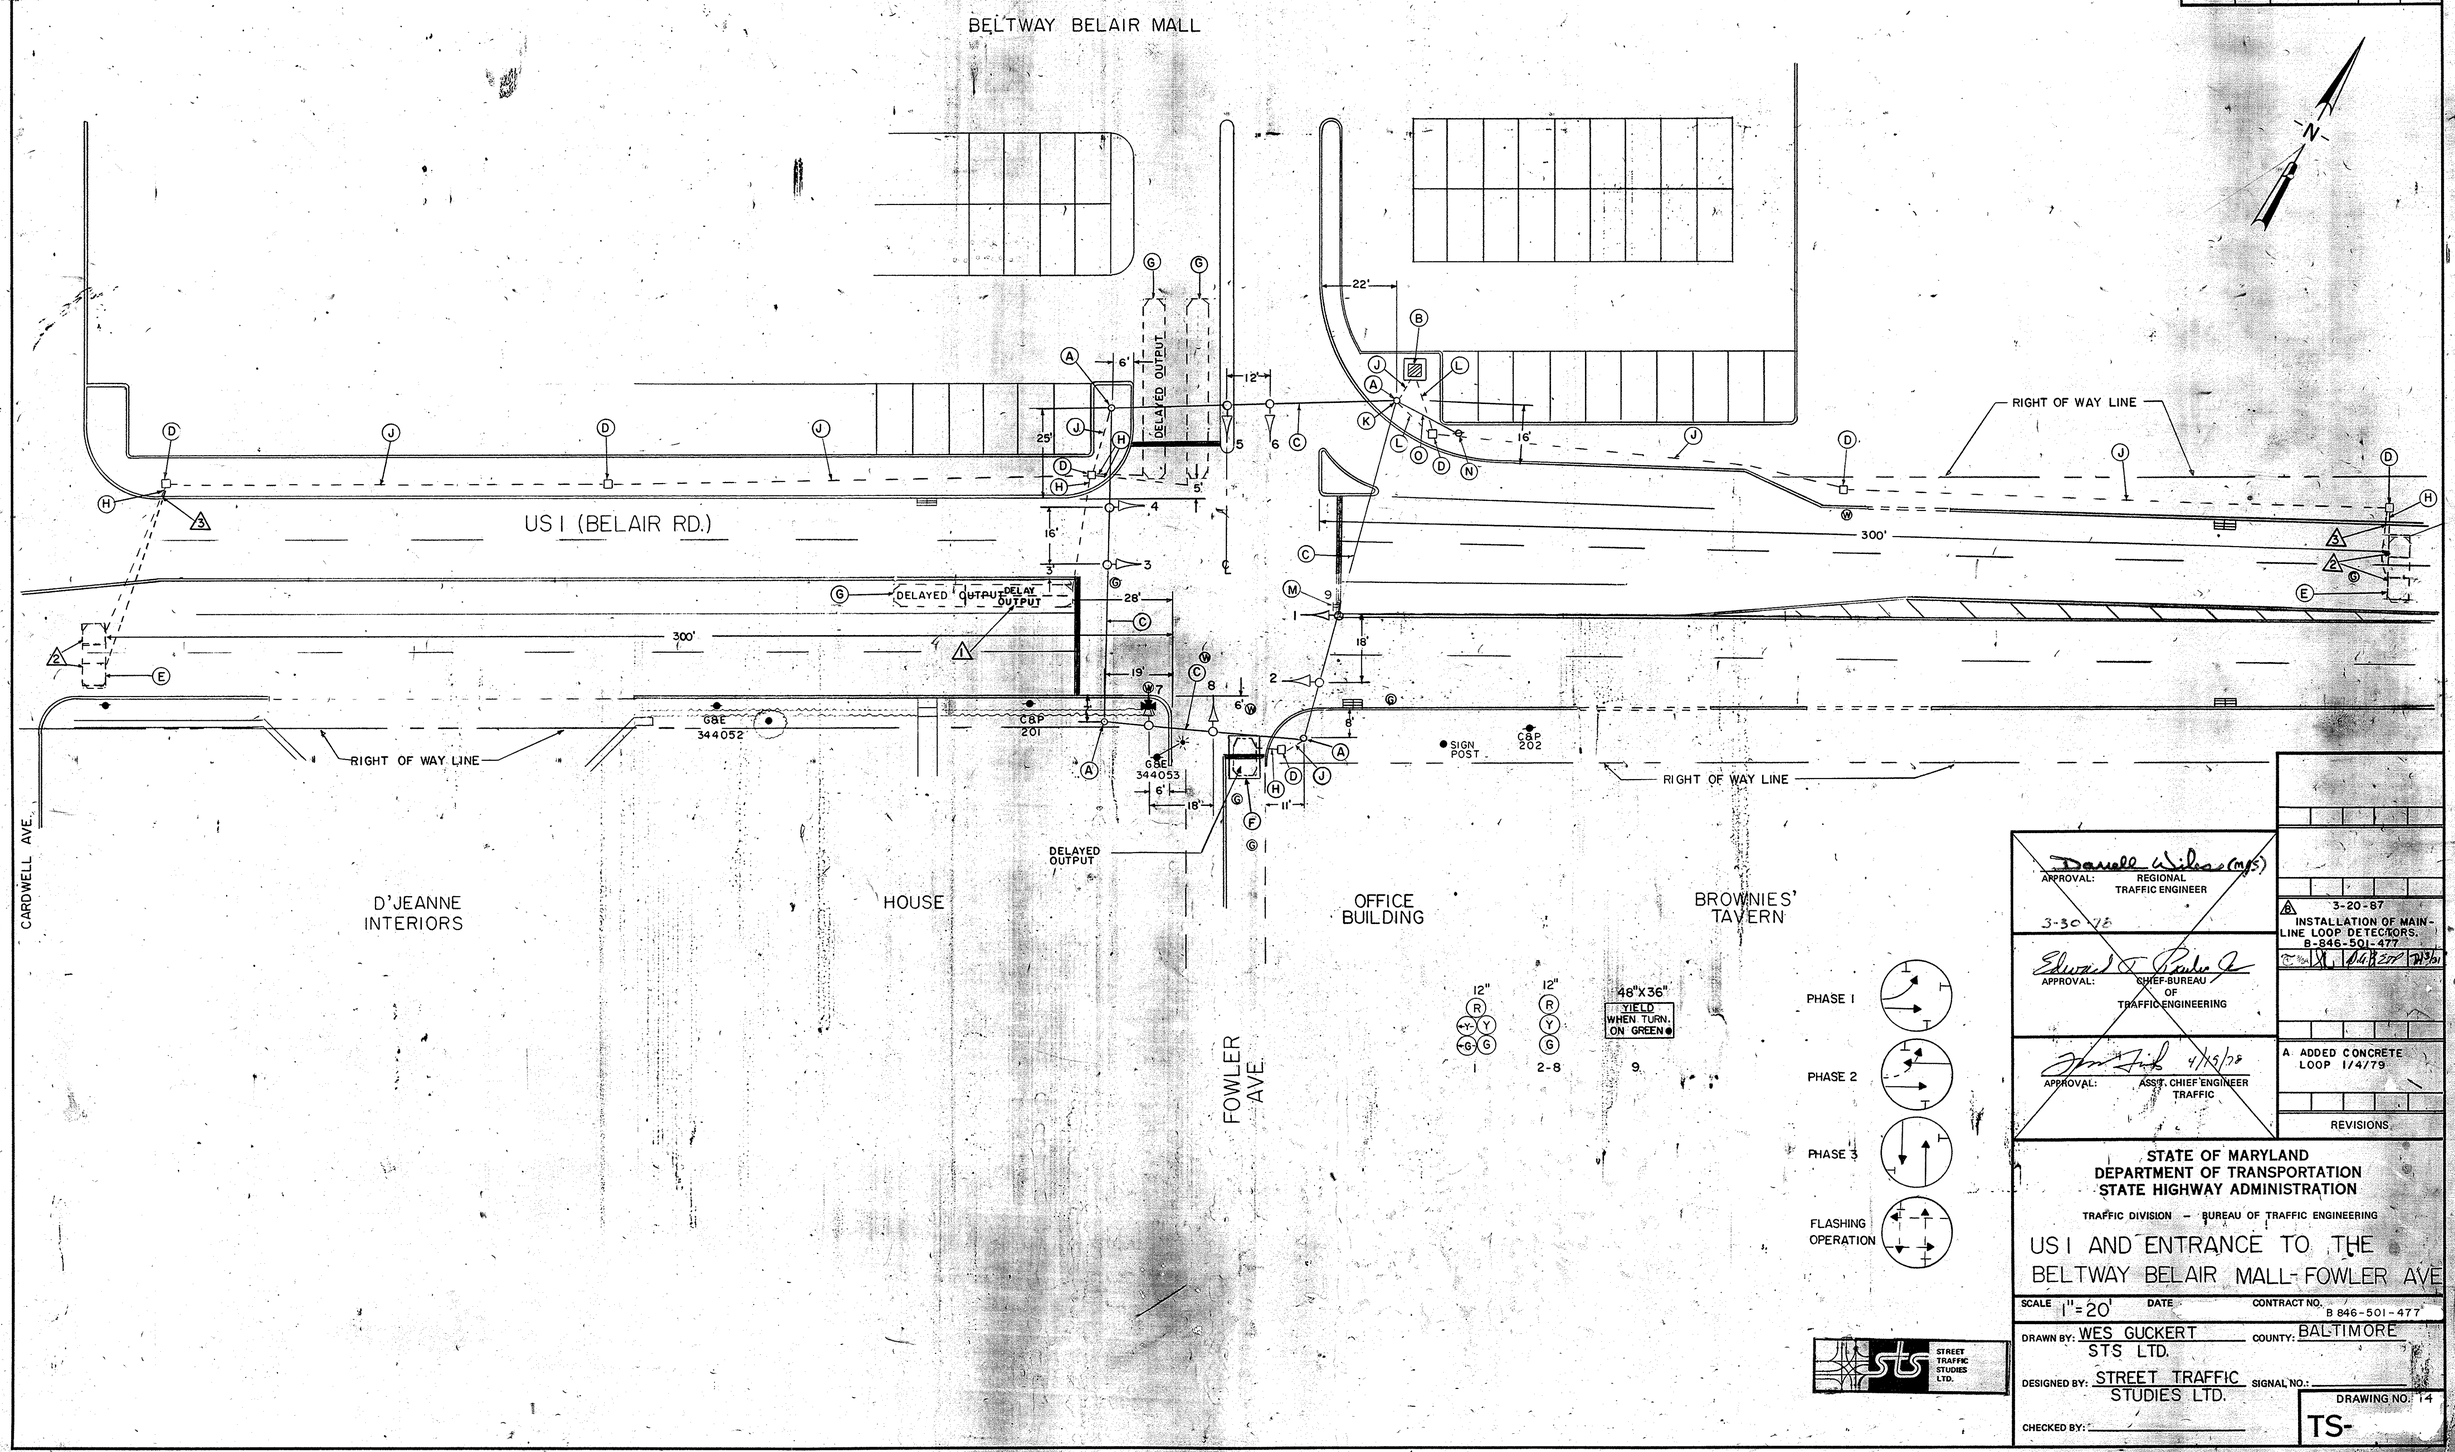

APPROVAL: REGIONAL TRAFFIC ENGINEER
3-30-78

APPROVAL: CHIEF-BUREAU OF TRAFFIC ENGINEERING

APPROVAL: ASS'T. CHIEF ENGINEER TRAFFIC 4/13/78

3-20-87
INSTALLATION OF MAIN-LINE LOOP DETECTORS. B-846-501-477

A ADDED CONCRETE LOOP 1/4/79

REVISIONS

STATE OF MARYLAND
DEPARTMENT OF TRANSPORTATION
STATE HIGHWAY ADMINISTRATION

TRAFFIC DIVISION – BUREAU OF TRAFFIC ENGINEERING

US I AND ENTRANCE TO THE BELTWAY BELAIR MALL- FOWLER AVE

SCALE 1" = 20' DATE CONTRACT NO. B 846-501-477

DRAWN BY: WES GUCKERT STS LTD. COUNTY: BALTIMORE

DESIGNED BY: STREET TRAFFIC STUDIES LTD. SIGNAL NO.:

CHECKED BY:

STREET TRAFFIC STUDIES LTD.

DRAWING NO. 14

TS-