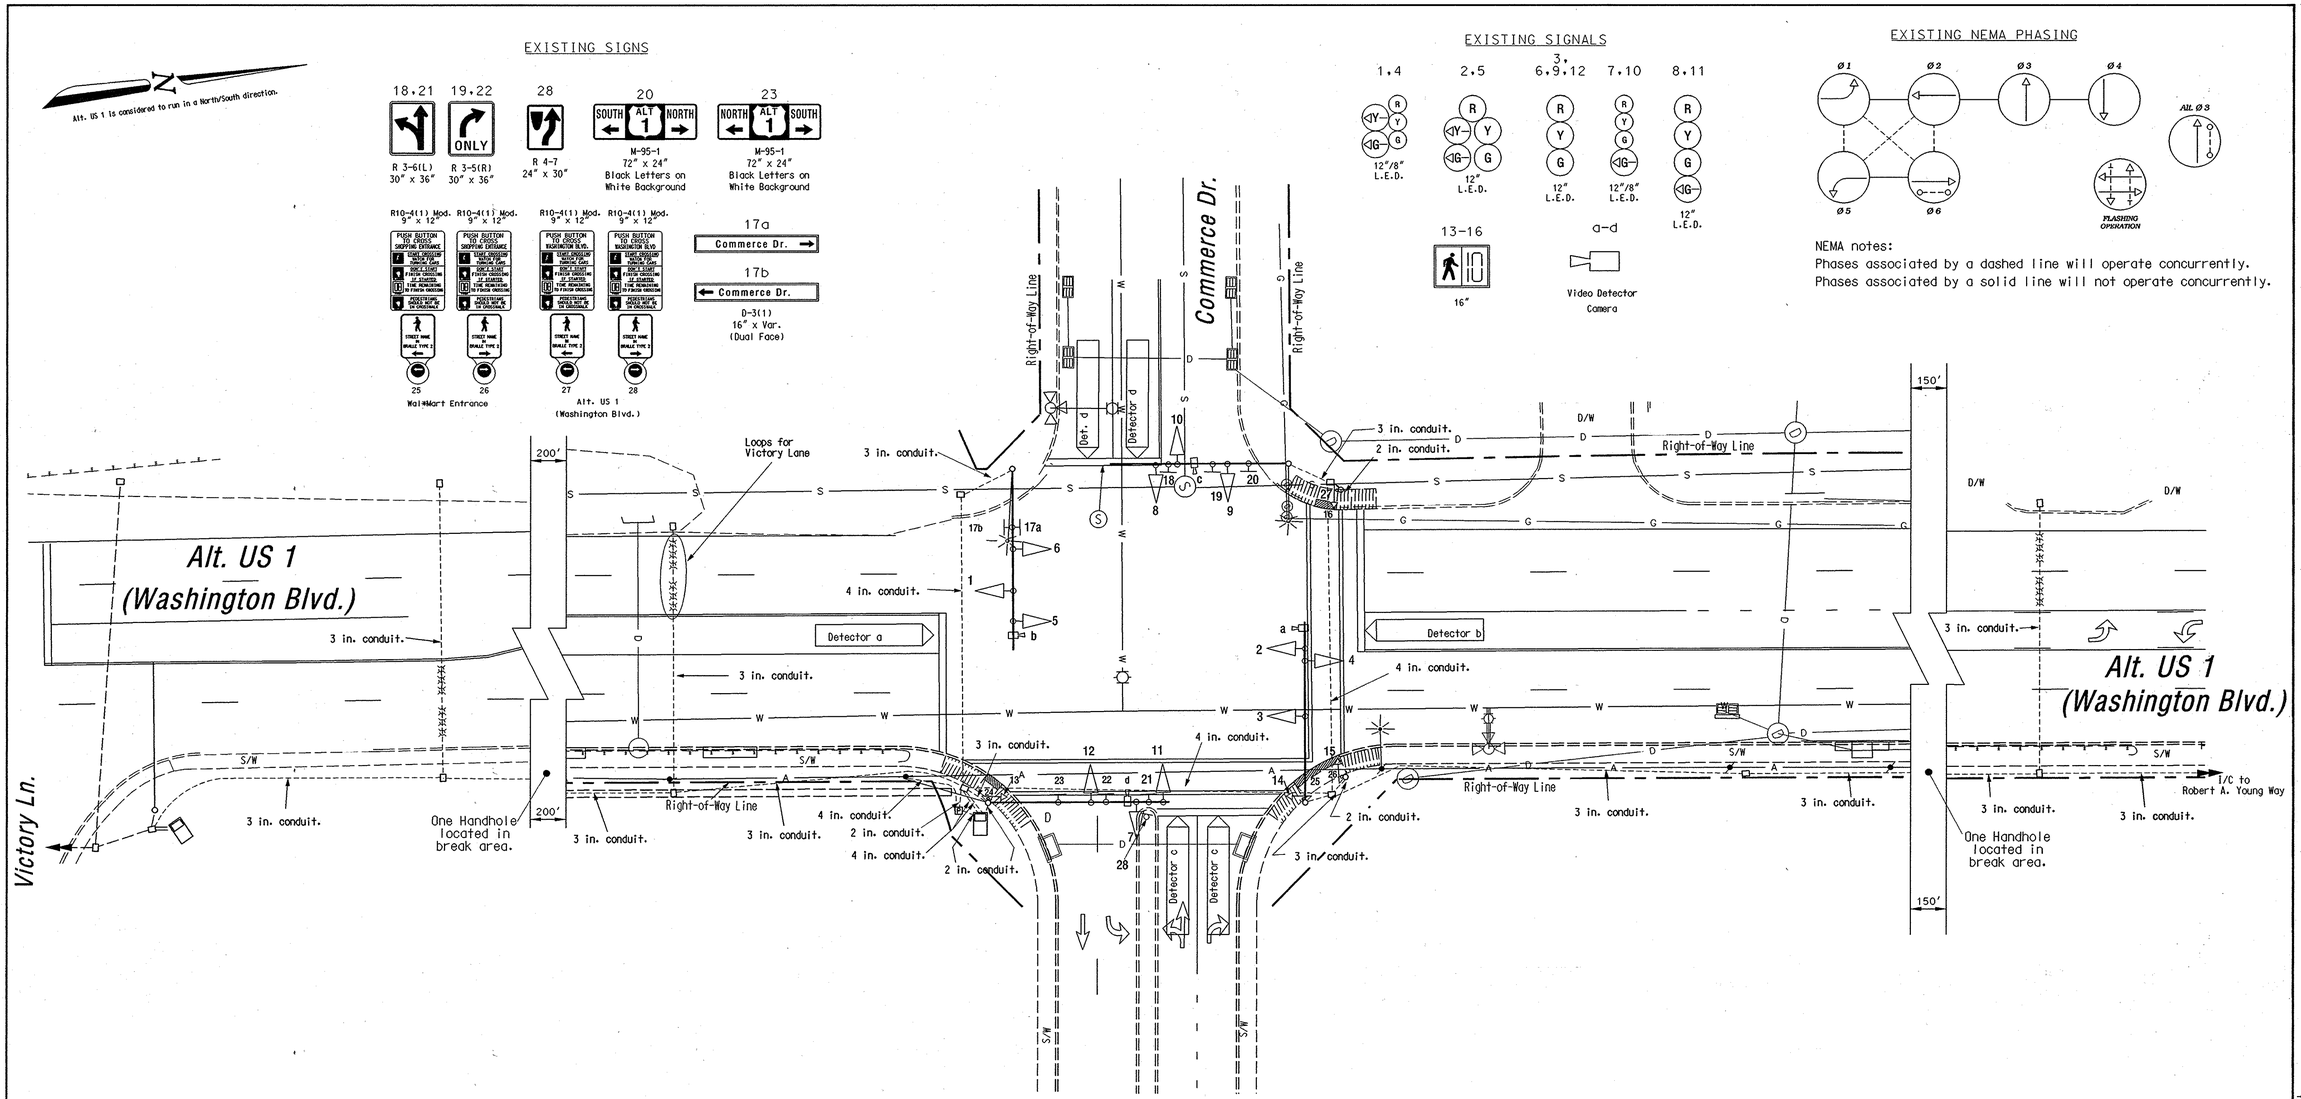

AS-BUILT

GEOMETRIC LEGEND	
	EXISTING GEOMETRICS
	PROPOSED GEOMETRICS

UTILITY LEGEND	
G	GAS MAIN
W	WATER MAIN
S	SEWER MAIN
E	ELECTRIC CABLES
D	STORM DRAIN
A	AERIAL CABLES
T	TELEPHONE CABLES

The Traffic Group
The Traffic Group, Inc.
410-931-6600
Fax 410-931-6601

REVISIONS

AS-BUILT April 16, 2008
S.H.A. No.:BW996M82
FJH

APPROVALS

TEAM LEADER, TRAFFIC ENGINEERING DESIGN DIVISION
ASST. CHIEF TRAFFIC ENGINEERING DESIGN DIVISION
CHIEF, TRAFFIC ENGINEERING DESIGN DIVISION
DIRECTOR, TRAFFIC & SAFETY

ORIGINAL ON FILE

MARYLAND DOT - STATE HIGHWAY ADMINISTRATION
Office of Traffic & Safety
TRAFFIC ENGINEERING DESIGN DIVISION
(Traffic Signal Plan)
Alt. US 1 (Washington Blvd.) at Commerce Dr./ Wal*Mart South Entrance

DRAWN BY:	J. Storck	F.A.P. NO.	N/A	TS NO. 4496	SHEET NO.
CHECKED BY:		S.H.A. NO.	BW996M82		
SCALE:	1" - 20'	COUNTY:	Baltimore	T.I.M.S. NO. H147	1 OF 1
DATE:	July 18, 2006	LOG MILE:	03001AL001.96		

f:\2004\2004-1022\des\AS-BUILTS\As-built US1@Commerce.dgn 4/28/2008