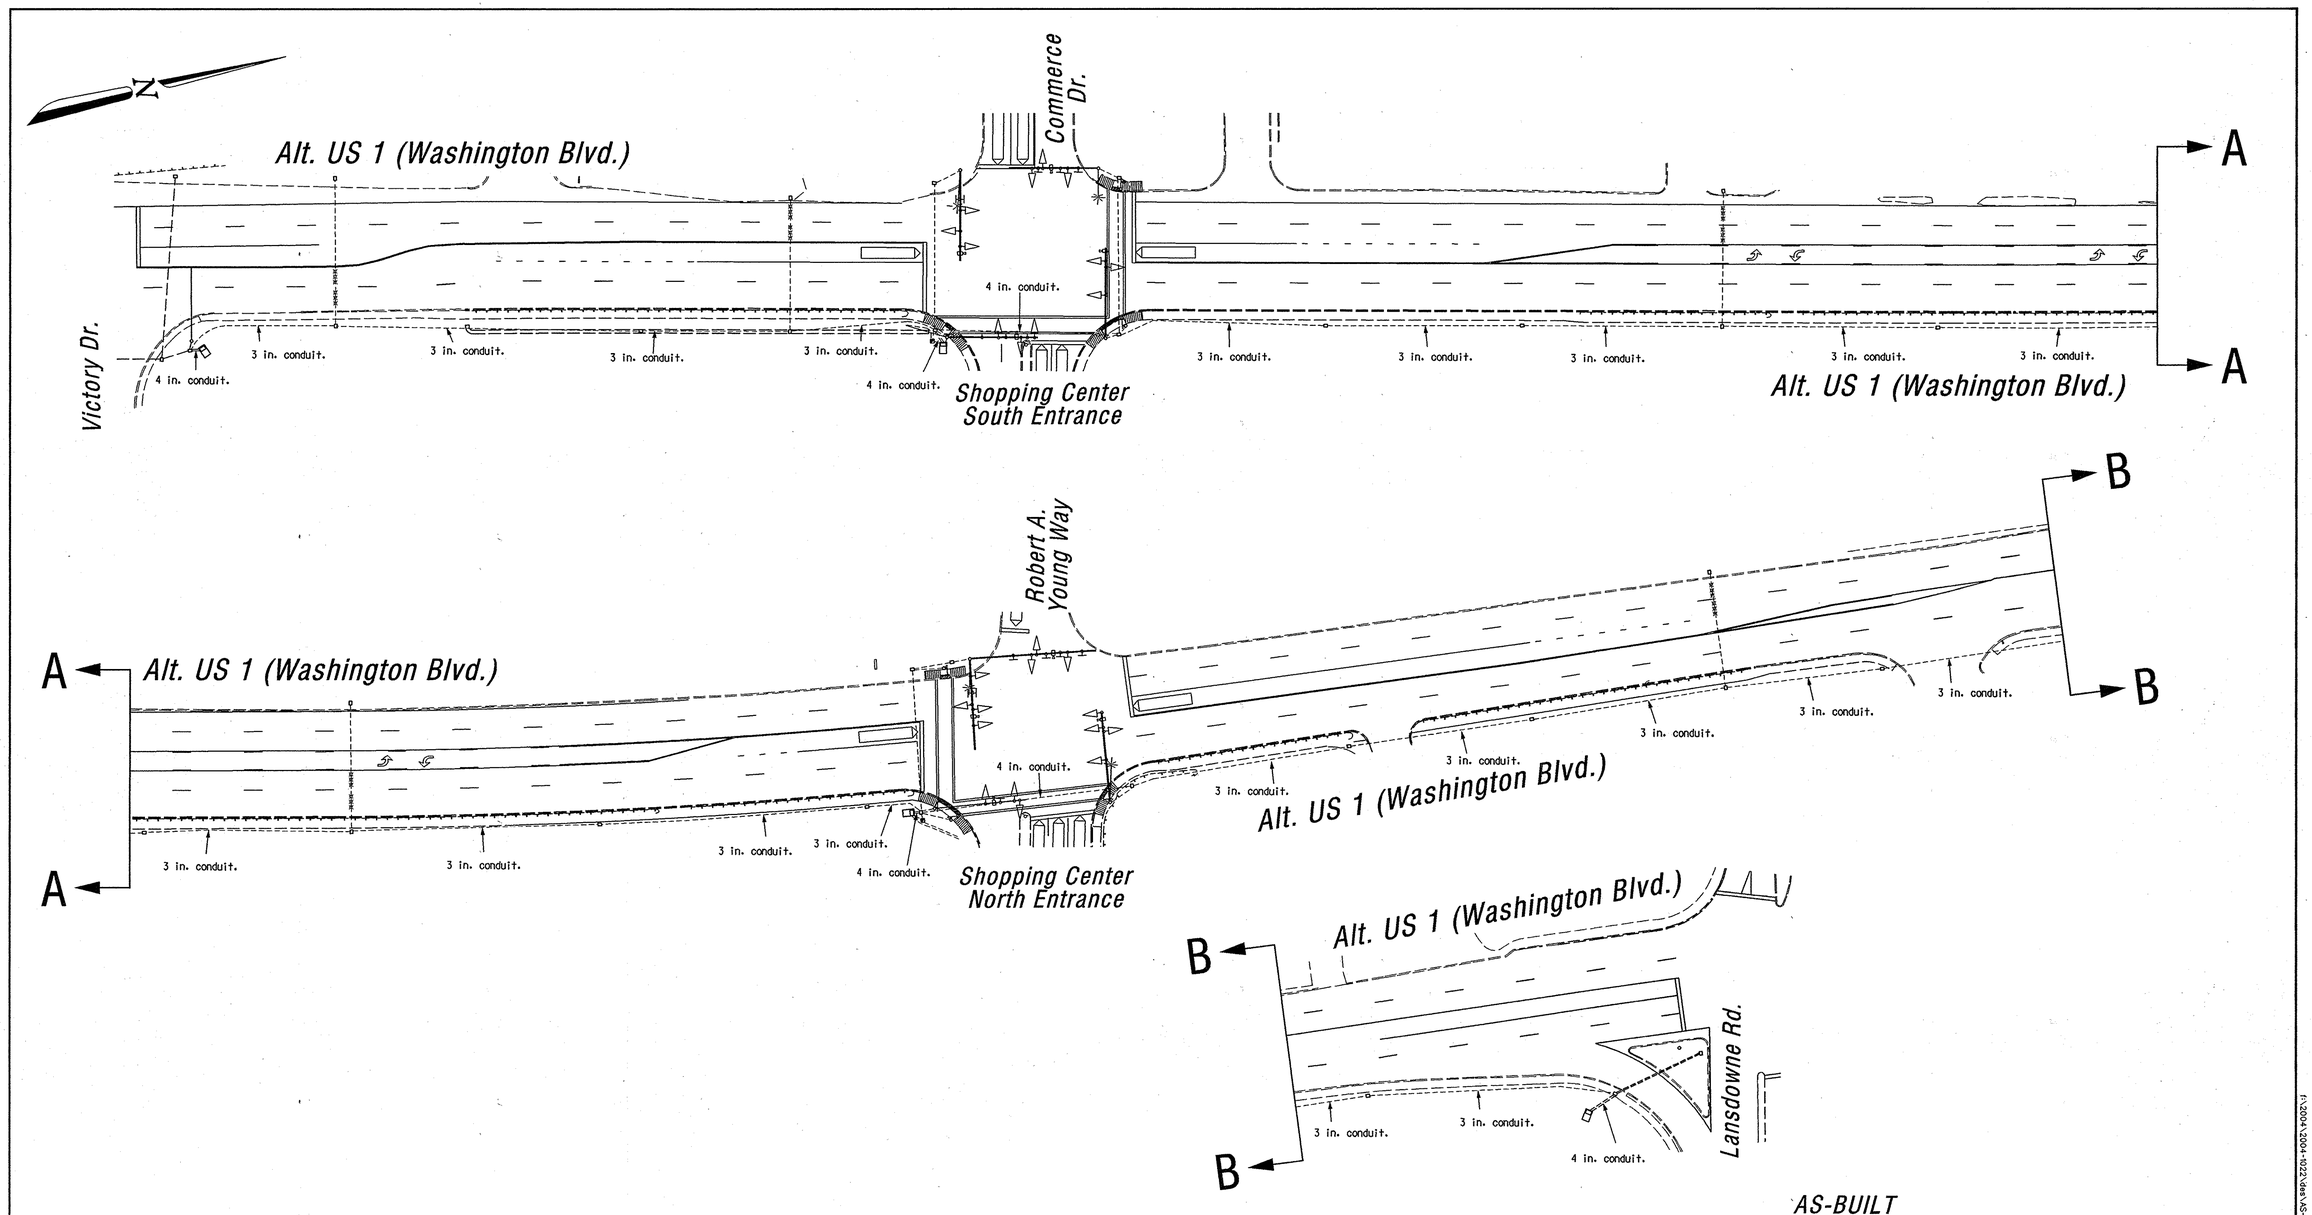

AS-BUILT

GEOMETRIC LEGEND

EXISTING GEOMETRICS
PROPOSED GEOMETRICS

UTILITY LEGEND

G	GAS MAIN
W	WATER MAIN
S	SEWER MAIN
E	ELECTRIC CABLES
D	STORM DRAIN
A	AERIAL CABLES
T	TELEPHONE CABLES

The Traffic Group
The Traffic Group, Inc.
410-931-6600
Fax 410-931-6601

REVISIONS

AS-BUILT April 16, 2008
S.H.A. No.: BW996M82
FJH

APPROVALS

TEAM LEADER, TRAFFIC ENGINEERING DESIGN DIVISION
ASST. CHIEF TRAFFIC ENGINEERING DESIGN DIVISION
CHIEF, TRAFFIC ENGINEERING DESIGN DIVISION
DIRECTOR, TRAFFIC & SAFETY
ORIGINAL ON FILE

MARYLAND DOT - STATE HIGHWAY ADMINISTRATION
Office of Traffic & Safety
TRAFFIC ENGINEERING DESIGN DIVISION
(Traffic Interconnect Plan)

Alt. US 1 (Washington Blvd.) between Victory Ln. and Lansdowne Rd.

DRAWN BY:	J. Storck	F.A.P. NO.	N/A	TS NO.	-
CHECKED BY:		S.H.A. NO.	BW996M82	T.I.M.S. NO.	H147
SCALE:	1" = 40'	COUNTY:	Baltimore	SHEET NO.	1 OF 1
DATE:	June 30, 2006	LOG MILE:	-		

f:\2004\2004-1022\dgns\AS-BUILTS\As-built interconnection.dgn 4/28/2008