PLAN NOTES 1. STRIPING SHOWN IS PROPOSED
2. "D.O." INITIALLY INDICATES DELAY OUTPUT LOOP DETECT SUBJECT TO CHANGE BY THE ENGINEER

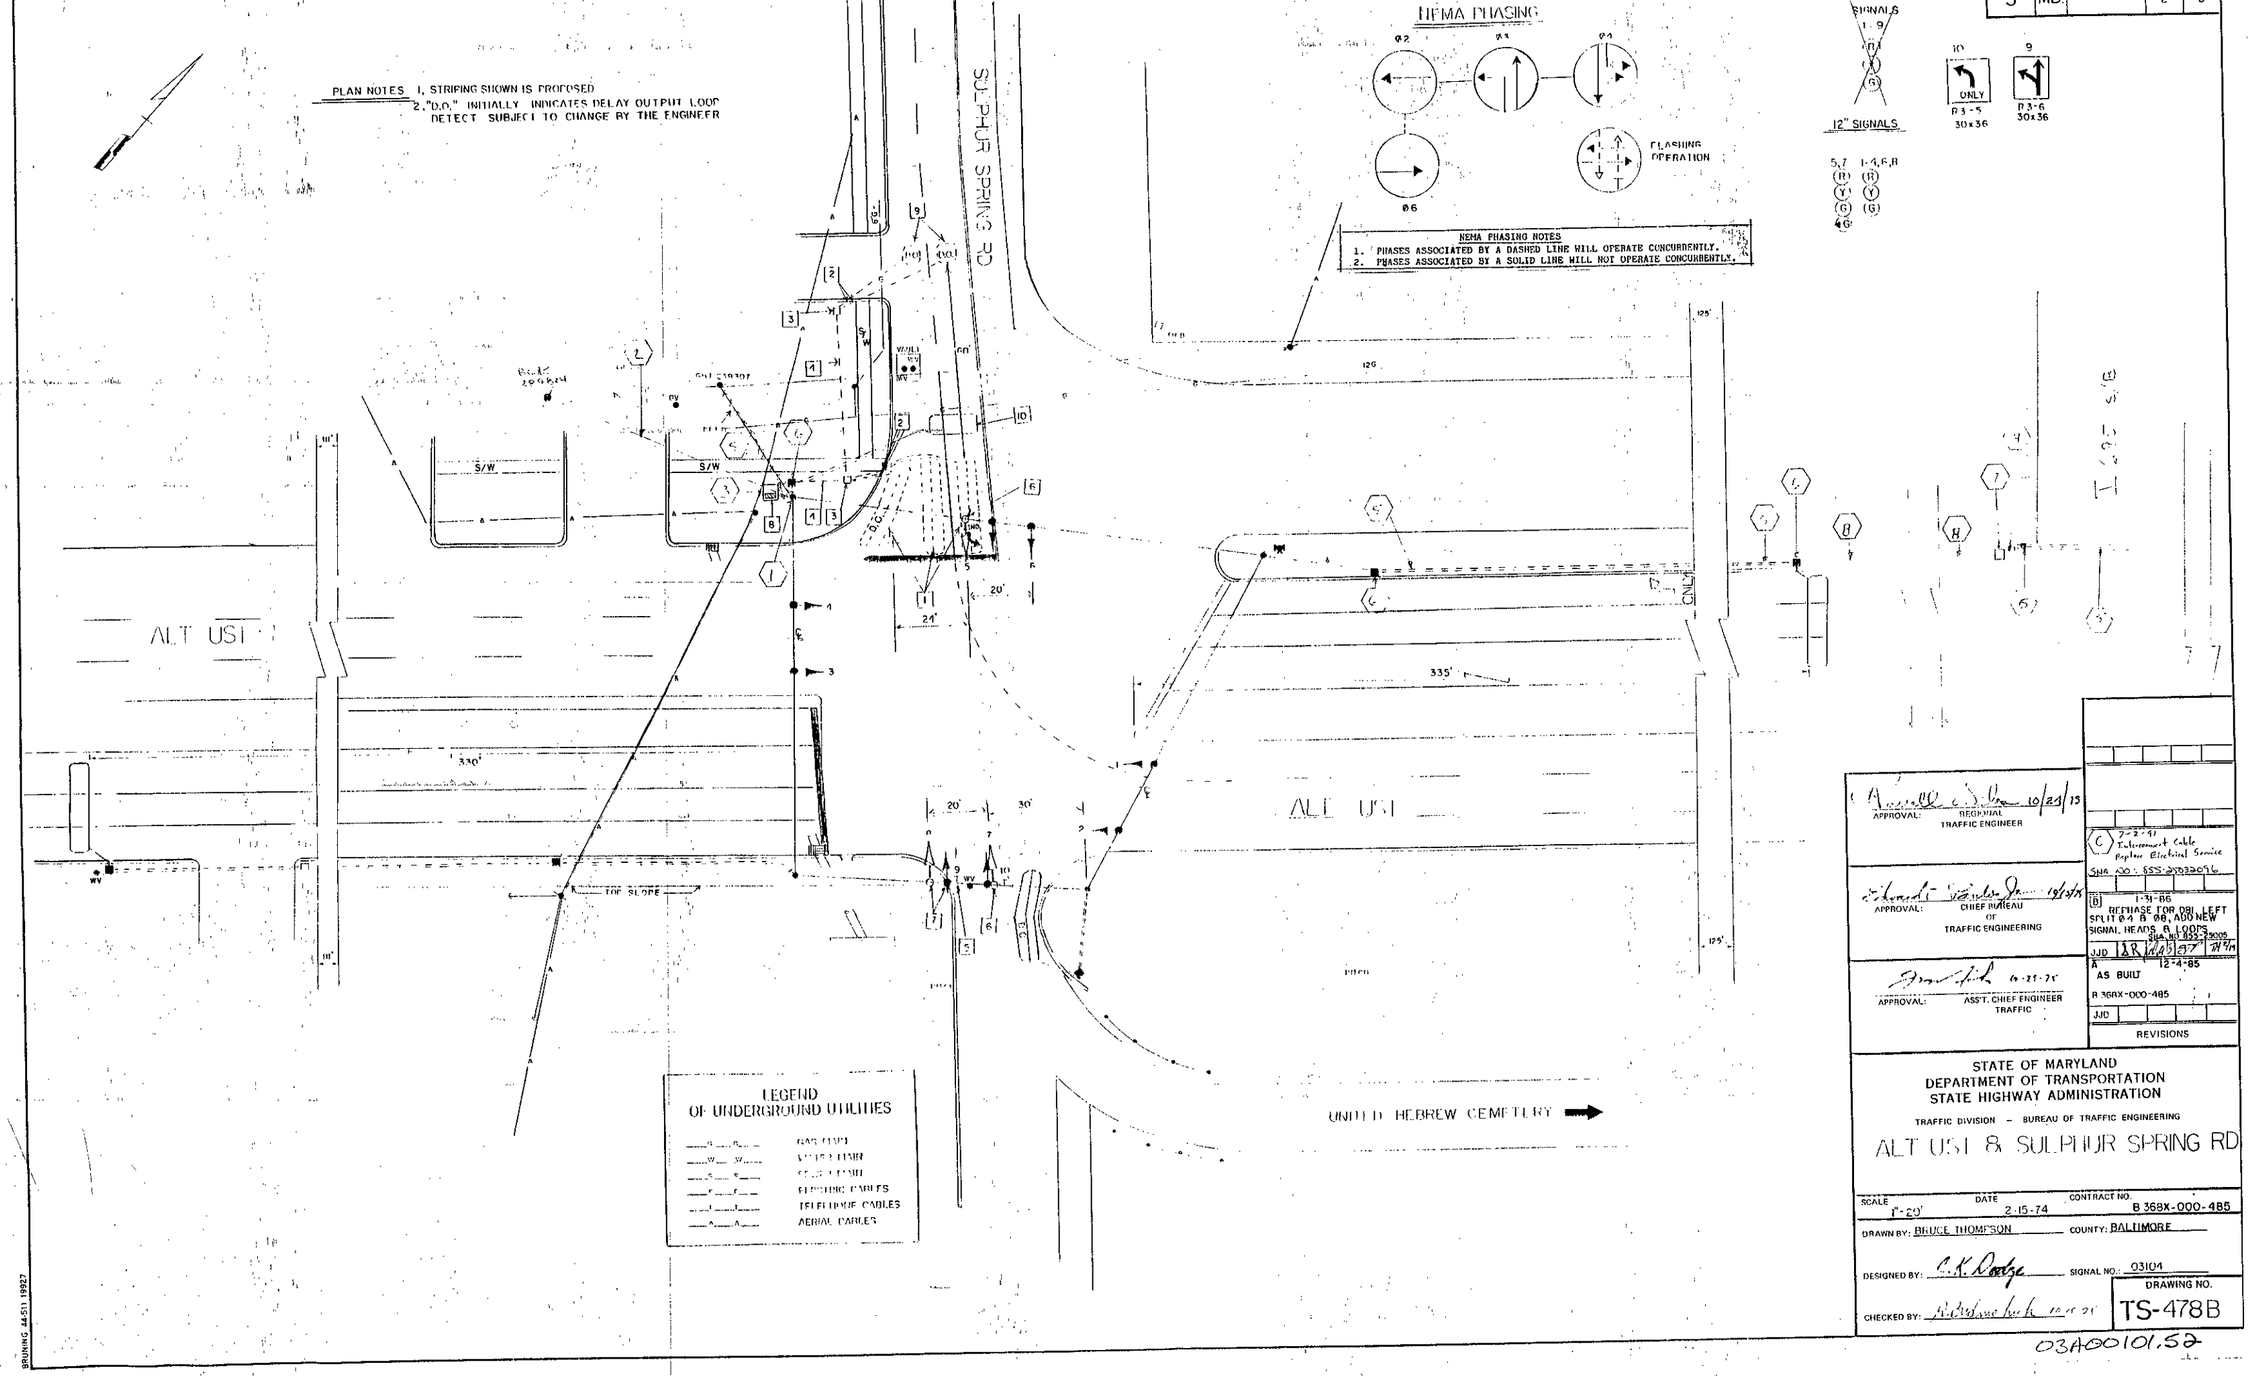

APPROVAL: REGIONAL TRAFFIC ENGINEER 10/23/13

APPROVAL: CHIEF BUREAU OF TRAFFIC ENGINEERING 10/24/13

APPROVAL: ASS'T. CHIEF ENGINEER TRAFFIC 6-25-75

C 7-2-91 Interconnect Cable Peptone Electrical Service SHA NO: 555-2033096

B 1-31-86 REPHASE FOR DBL LEFT SPLIT Ø4 & Ø6, ADD NEW SIGNAL HEADS & LOOPS SHA NO: 555-2033005 JJD 12/5/97 12/5/97

A 12-4-85 AS BUILT B 368X-000-485 JJD

REVISIONS

STATE OF MARYLAND
DEPARTMENT OF TRANSPORTATION
STATE HIGHWAY ADMINISTRATION

TRAFFIC DIVISION – BUREAU OF TRAFFIC ENGINEERING

ALT US1 & SULPHUR SPRING RD

SCALE	DATE	CONTRACT NO.
1"=20'	2-15-74	B 368X-000-485

DRAWN BY: BRUCE THOMPSON COUNTY: BALTIMORE

DESIGNED BY: C.K. Doetze SIGNAL NO.: 03104

CHECKED BY: 10-10-74

DRAWING NO. TS-478B

03A00101.52

BRUNING 44511 19927