F.H.WA. REGION NO.	STATE	FED. AID PROJ. NO.	SHEET NO.	TOTAL SHEETS
3	MD.			

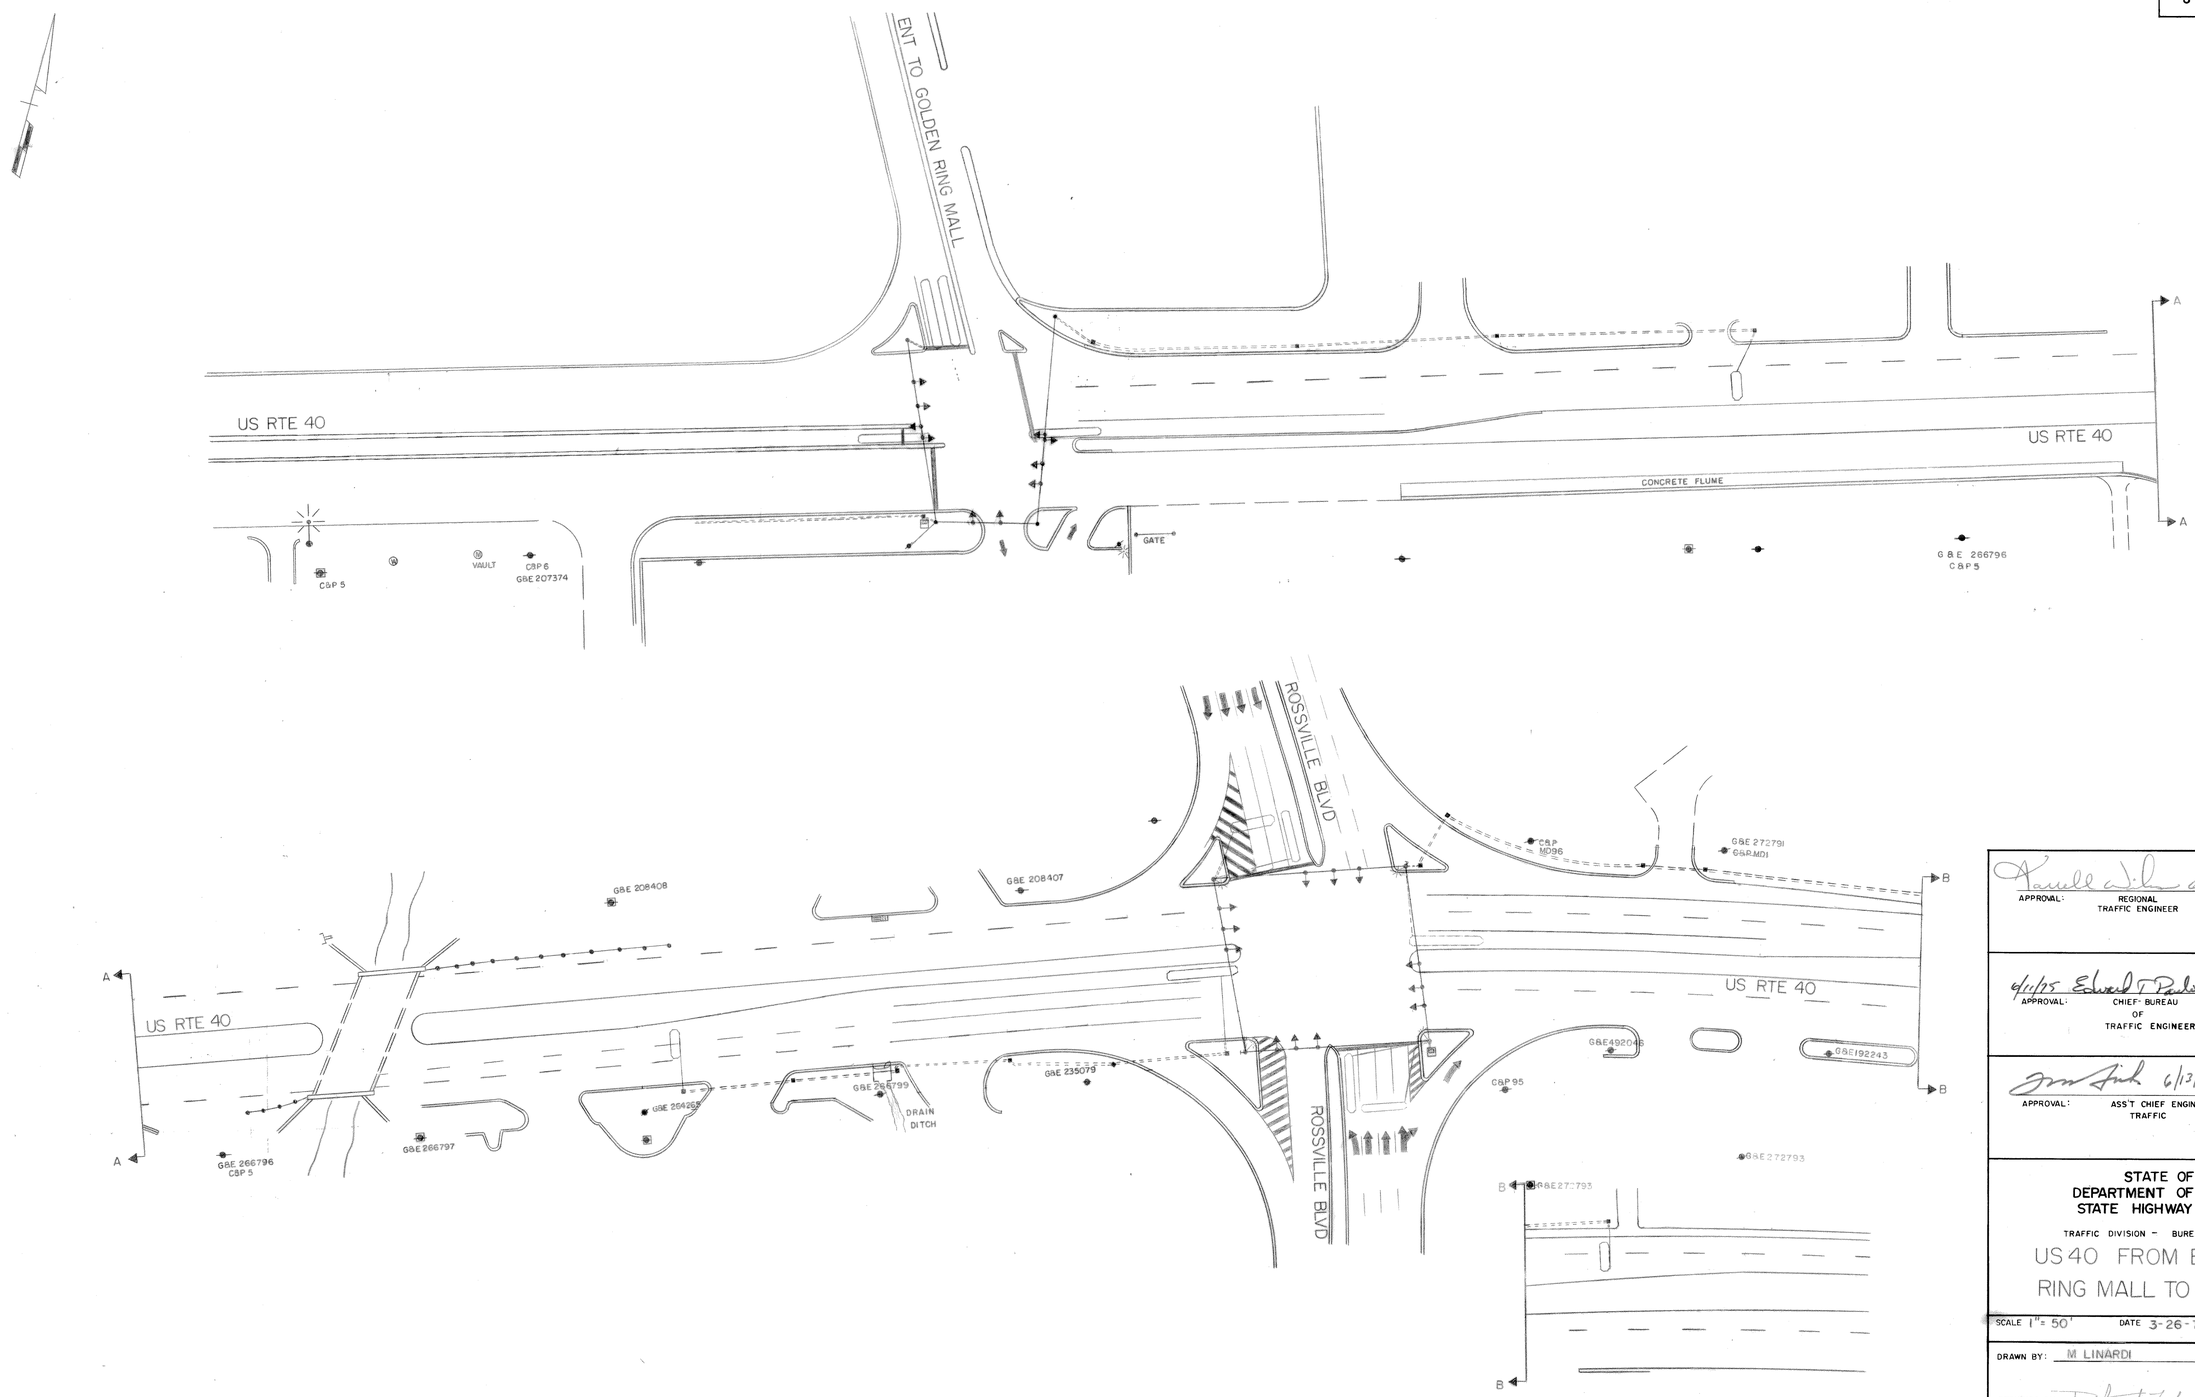

APPROVAL: Karrell Wilson 6/11/75
REGIONAL TRAFFIC ENGINEER

APPROVAL: 6/11/75 Edward T Paulis Jr
CHIEF BUREAU OF TRAFFIC ENGINEERING

APPROVAL: 6/13/75
ASS'T CHIEF ENGINEER TRAFFIC

B 11-14-75
ASBUILT
B-322X-000-485
WDB
A 6-11-75
ADDED MAINLINE DET.
D Z
REVISIONS

STATE OF MARYLAND
DEPARTMENT OF TRANSPORTATION
STATE HIGHWAY ADMINSTRATION

TRAFFIC DIVISION - BUREAU OF TRAFFIC ENGINEERING

US 40 FROM ENT TO GOLDEN RING MALL TO ROSSVILLE BLVD

SCALE 1" = 50' DATE 3-26-74 CONTRACT NO.

DRAWN BY: M LINARDI COUNTY: BALTIMORE

DESIGNED BY: Douglas A. Lafon 6/9/75 SIGNAL NO: 03112

CHECKED BY: A. Budnichuk 6-9-75

DRAWING NO.
TS-1151B

