F H WA REGION NO	STATE	FED. AID PROJ. NO	SHEET NO.	TOTAL SHEETS
3	MD.			

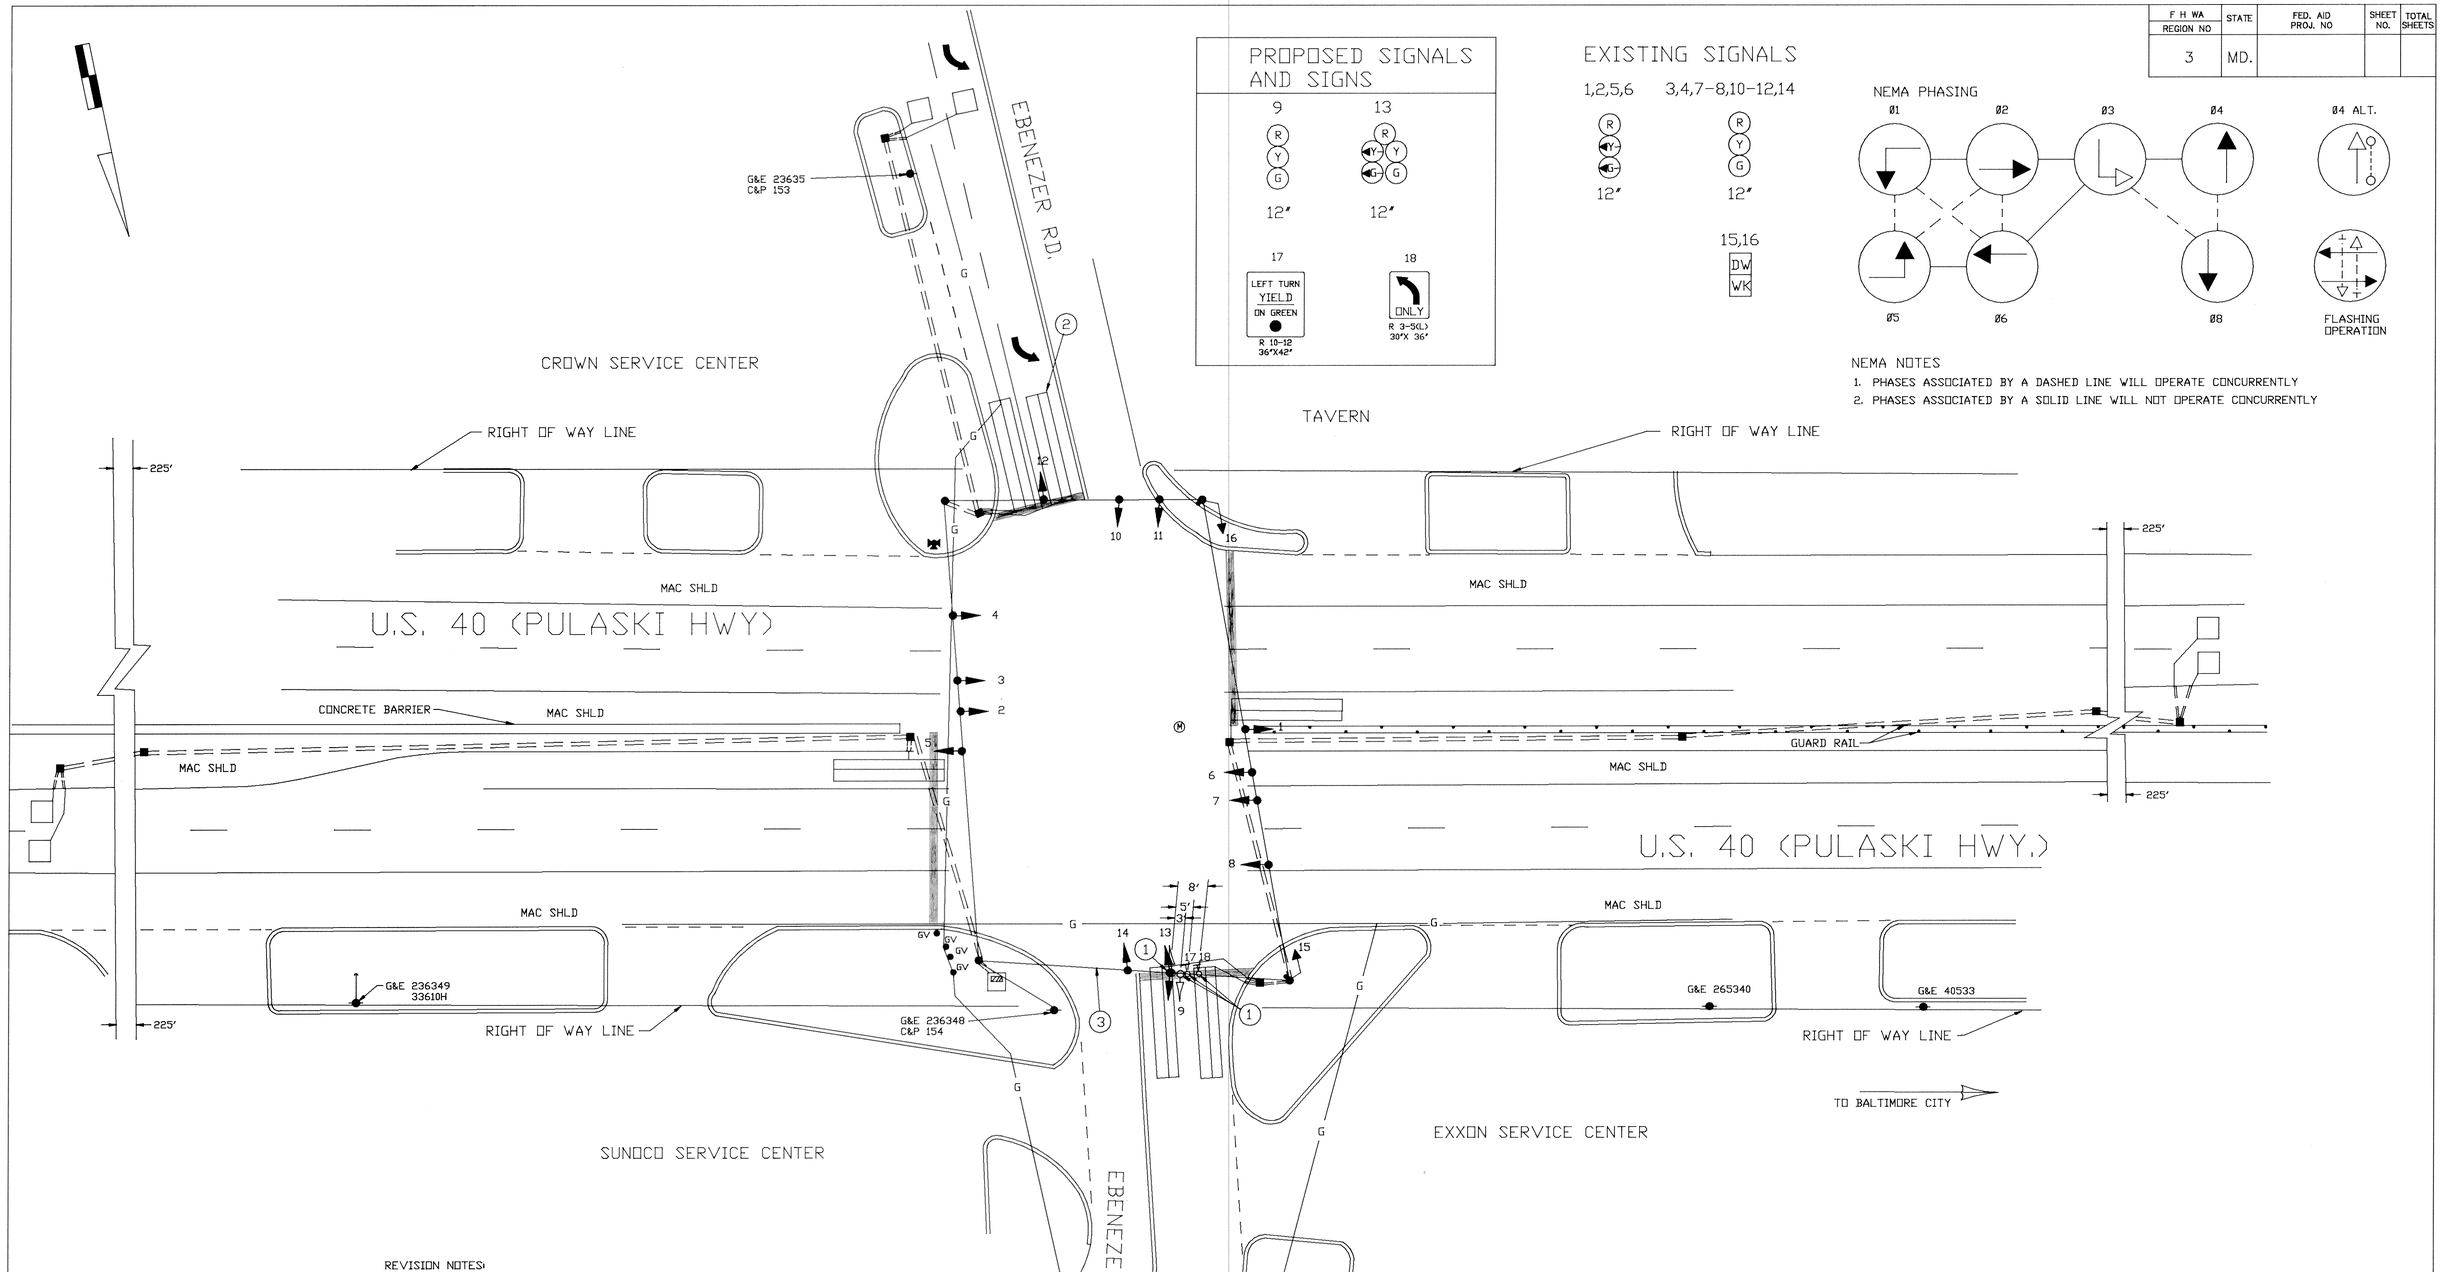

REVISION NOTES:

1. REVISION "C" IS A MODIFICATION TO THE ORIGINAL CONTRACT B-284-485.
2. THE ORIGINAL HAS BEEN FILED.

UTILITY LEGEND

G — G	GAS MAIN
W — W	WATER MAIN
S — S	SEWER MAIN
E — E	ELECTRIC CABLES
A — A	AERIAL CABLES

REVISIONS	APPROVALS
C. 07-89 E/P L.T. FOR NB EBENEZER RD. WM	CHIEF, SIGNAL DESIGN SECTION
B. 07-89 AS-BUILT WM	ASST. DISTRICT ENGINEER, TRAFFIC
A. 8/3/83 REDRAWN JEP KWS	CHIEF, TRAFFIC ENGINEERING DIVISION
	DEPUTY CHIEF ENGINEER, OFFICE OF TRAFFIC

MARYLAND DEPARTMENT OF TRANSPORTATION
STATE HIGHWAY ADMINISTRATION – OFFICE OF TRAFFIC
TRAFFIC ENGINEERING DIVISION

REDRAWN BY W. MALCOLM
~~DRAWN BY~~
REDES. BY: W. MALCOLM
~~DES. BY:~~
CHK. BY:

U.S. 40 & EBENEZER RD.

COUNTY: BALTIMORE

DATE: 07-89
SCALE: 1"=20'
F.A.P. NO.
S.H.A. NO.
TS/FILE NO. TS-605C
SHEET NO. ___ OF ___

03004011.46