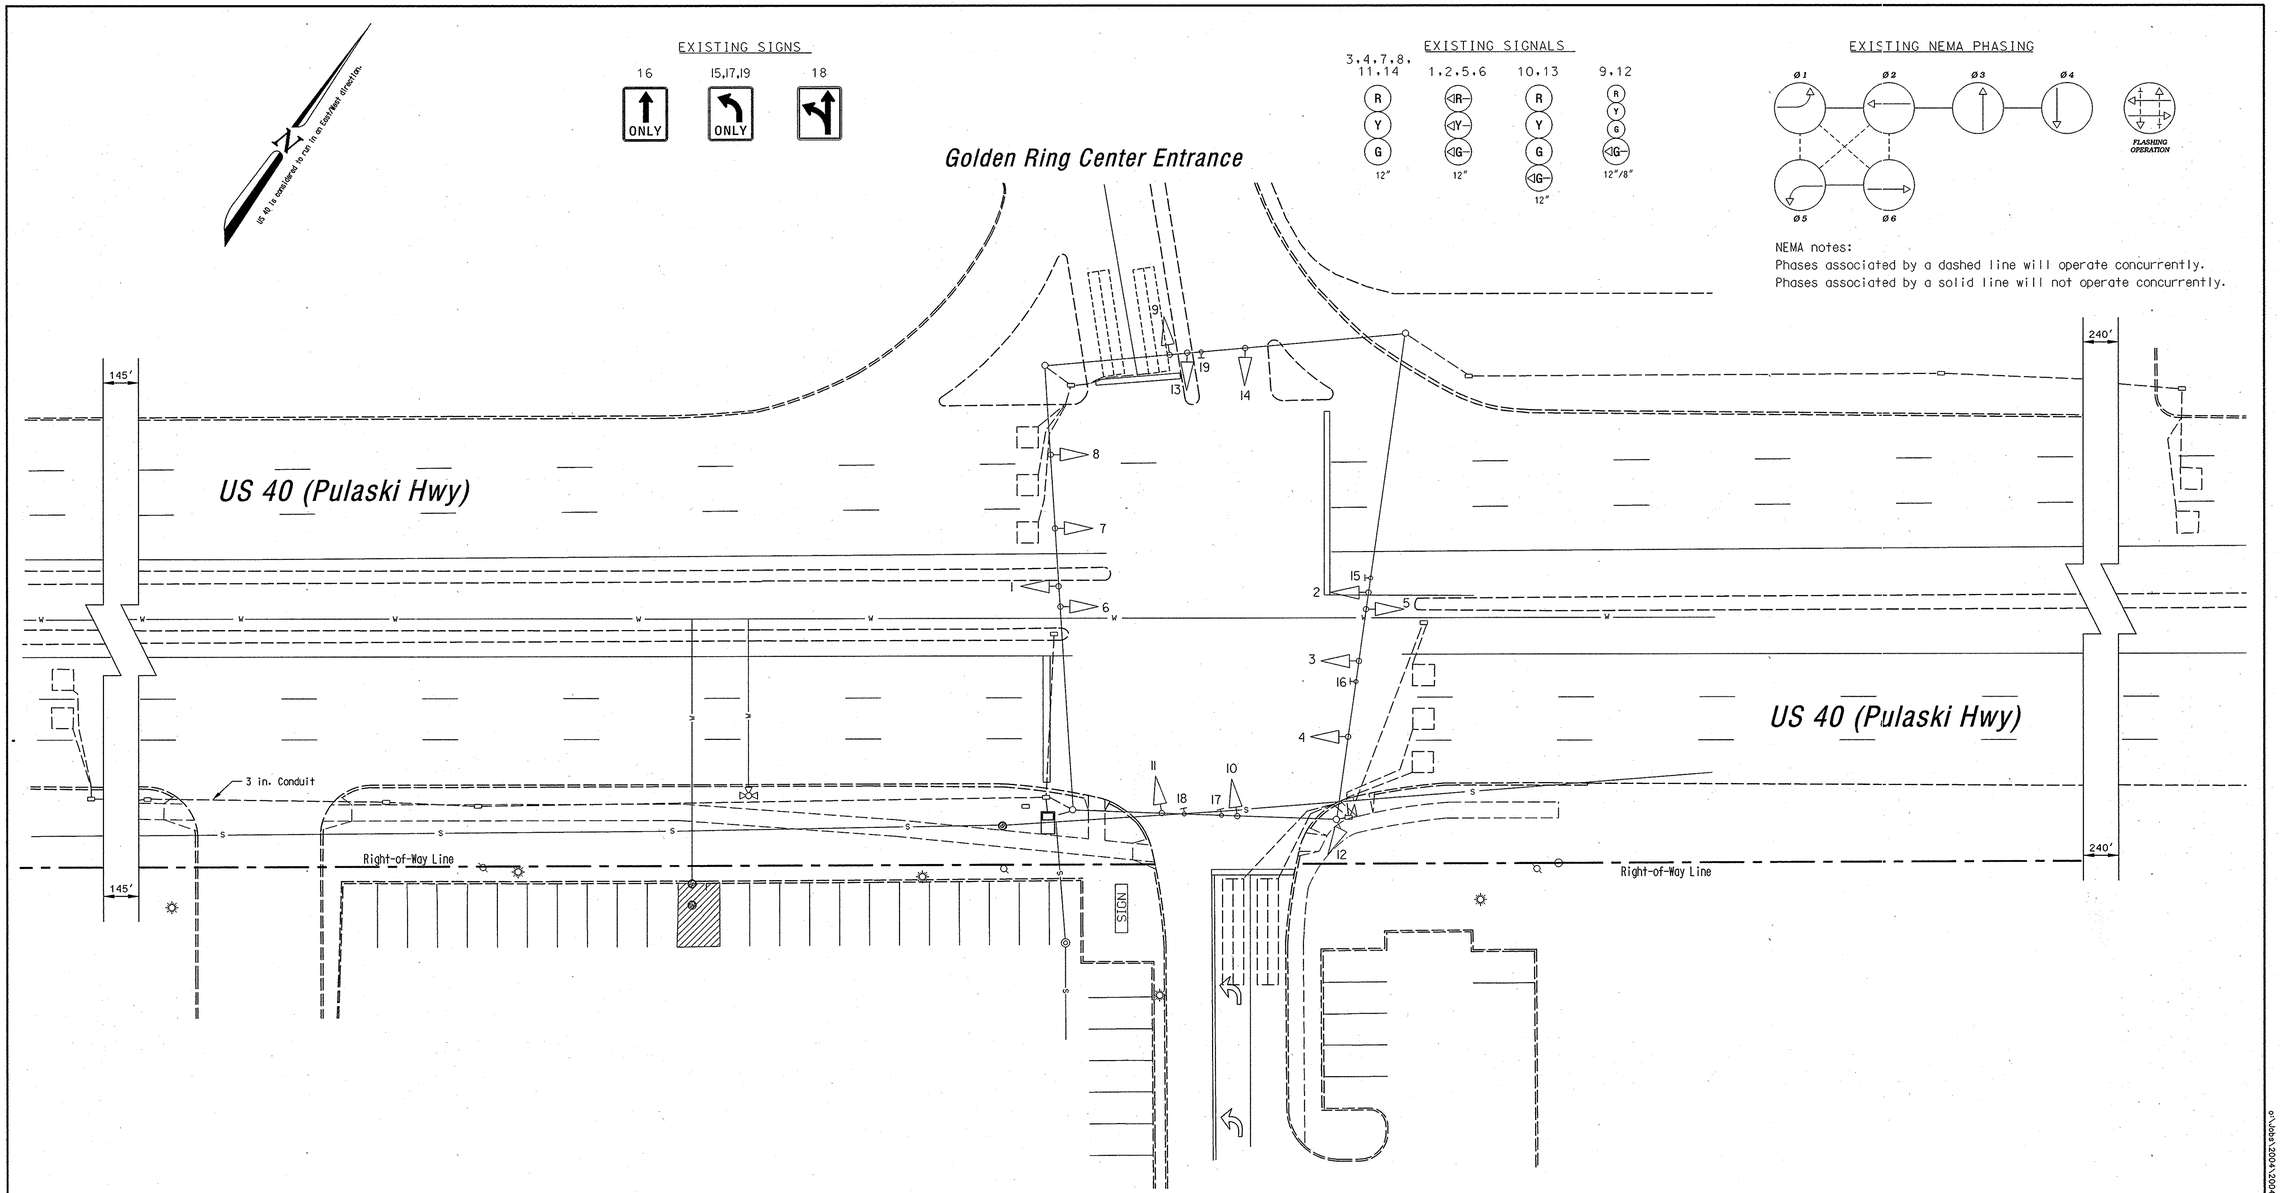

GEOMETRIC LEGEND

EXISTING GEOMETRICS

PROPOSED GEOMETRICS

UTILITY LEGEND

GAS MAIN

WATER MAIN

SEWER MAIN

ELECTRIC CABLES

STORM DRAIN

AERIAL CABLES

TELEPHONE CABLES

Job # 2004-1215

The Traffic Group

The Traffic Group, Inc.
410-931-6600
Fax 410-931-6601

REVISIONS				
F	As-Built	June 5, 2006		
HJK				
E	12/15/05	Modify existing access on east leg of intersection.		
HJK	DJD			
D	3/15/04	Add Luminaire & Lighting arm to steel poles. SHA # AT2885185		
BVD	DJD	DZ	BK	
C	5/01/01	Remove sampling Station at Best Store & relocate to EB & WB US 40		

APPROVALS

TEAM LEADER, TRAFFIC ENGINEERING DESIGN DIVISION

ASST. CHIEF TRAFFIC ENGINEERING DESIGN DIVISION

CHIEF, TRAFFIC ENGINEERING DESIGN DIVISION

DIRECTOR, TRAFFIC & SAFETY

ORIGINAL ON FILE

MARYLAND DOT - STATE HIGHWAY ADMINISTRATION

Office of Traffic & Safety

TRAFFIC ENGINEERING DESIGN DIVISION

(Traffic Signal Plan)

US 40 (Pulaski Hwy) at Golden Ring Center

DRAWN BY:	M. Linardi	F.A.P. NO.	N/A	TS NO.	SHEET NO.
CHECKED BY:	A. Budnichuck	S.H.A. NO.	BW996M82	1102F	
SCALE:	1" = 20'	COUNTY:	Baltimore	T.I.M.S. NO.	
DATE:	January 7, 1974	LOG MILE:	03004017.01		1 OF 1

o:\Jobs\2004\2004-1215\DES\Asbuilt Signal-Marking.dgn 6/5/2006