3	MD.	T-8007 (19)	5	11

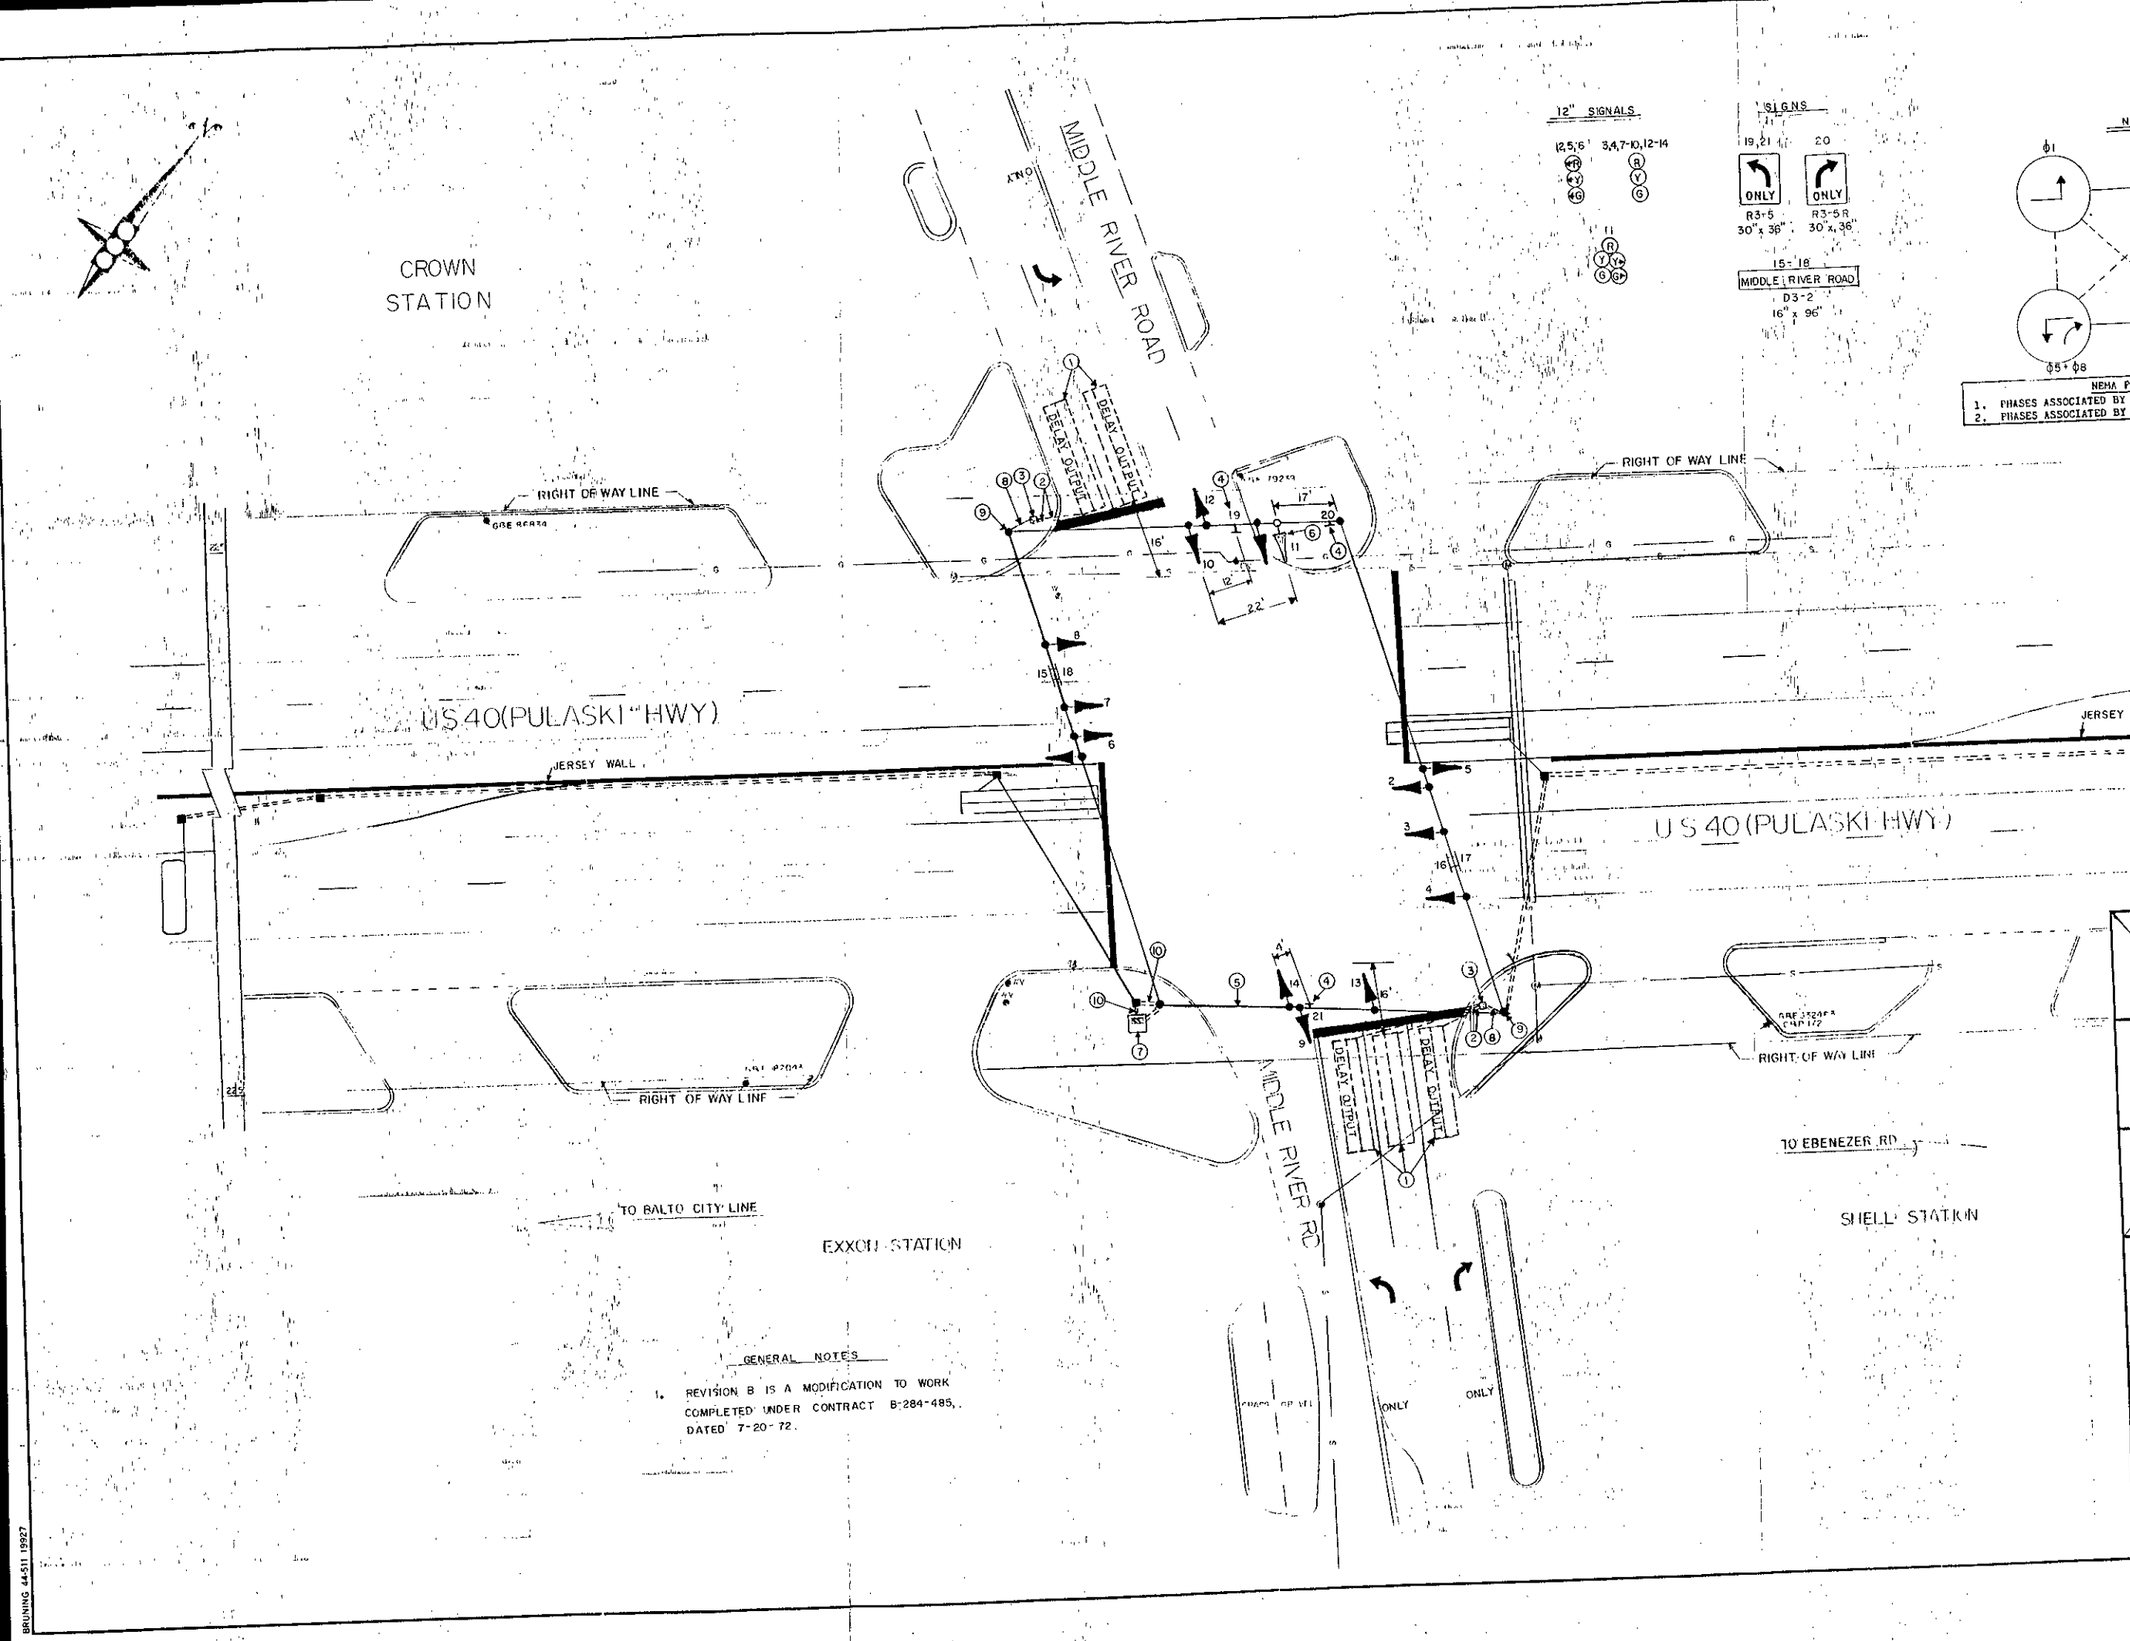

GENERAL NOTES

1. REVISION B IS A MODIFICATION TO WORK COMPLETED UNDER CONTRACT B-284-485, DATED 7-20-72.

APPROVAL: REGIONAL TRAFFIC ENGINEER

APPROVAL: CHIEF BUREAU OF TRAFFIC ENGINEERING

APPROVAL: ASS'T. CHIEF ENGINEER TRAFFIC

B	7-25-91	INSTALL LOOP DETECTORS ON SIDE STREETS. ALSO INSTALL LANE CONTROL SIGNS
A	8-28-74	REVISED POLE LOCATION IN SOUTH EAST CORNER

REVISIONS

STATE OF MARYLAND
DEPARTMENT OF TRANSPORTATION
STATE HIGHWAY ADMINISTRATION
TRAFFIC ENGINEERING DIVISION
OFFICE OF TRAFFIC

US. 40 (PULASKI HWY) & MIDDLE RIVER RD

SCALE 1" = 20' DATE 7-20-72 CONTRACT NO. B-284-485 FAP NO T-8007 (19)

DRAWN BY: L.T & B.T. COUNTY: BALTIMORE

Log-03004009.09

DESIGNED BY: SIGNAL NO.: 0314

CHECKED BY:

DRAWING NO. TS-628 (B)

THOMPSON ELECTRIC INC.
P. O. BOX 125
CHURCHVILLE MD. 21023

BRUNING 44-511 19927