FHWA REGION NO.	STATE	FED. AID PROJ. NO.	SHEET NO.	TOTAL SHEETS
3	MD			

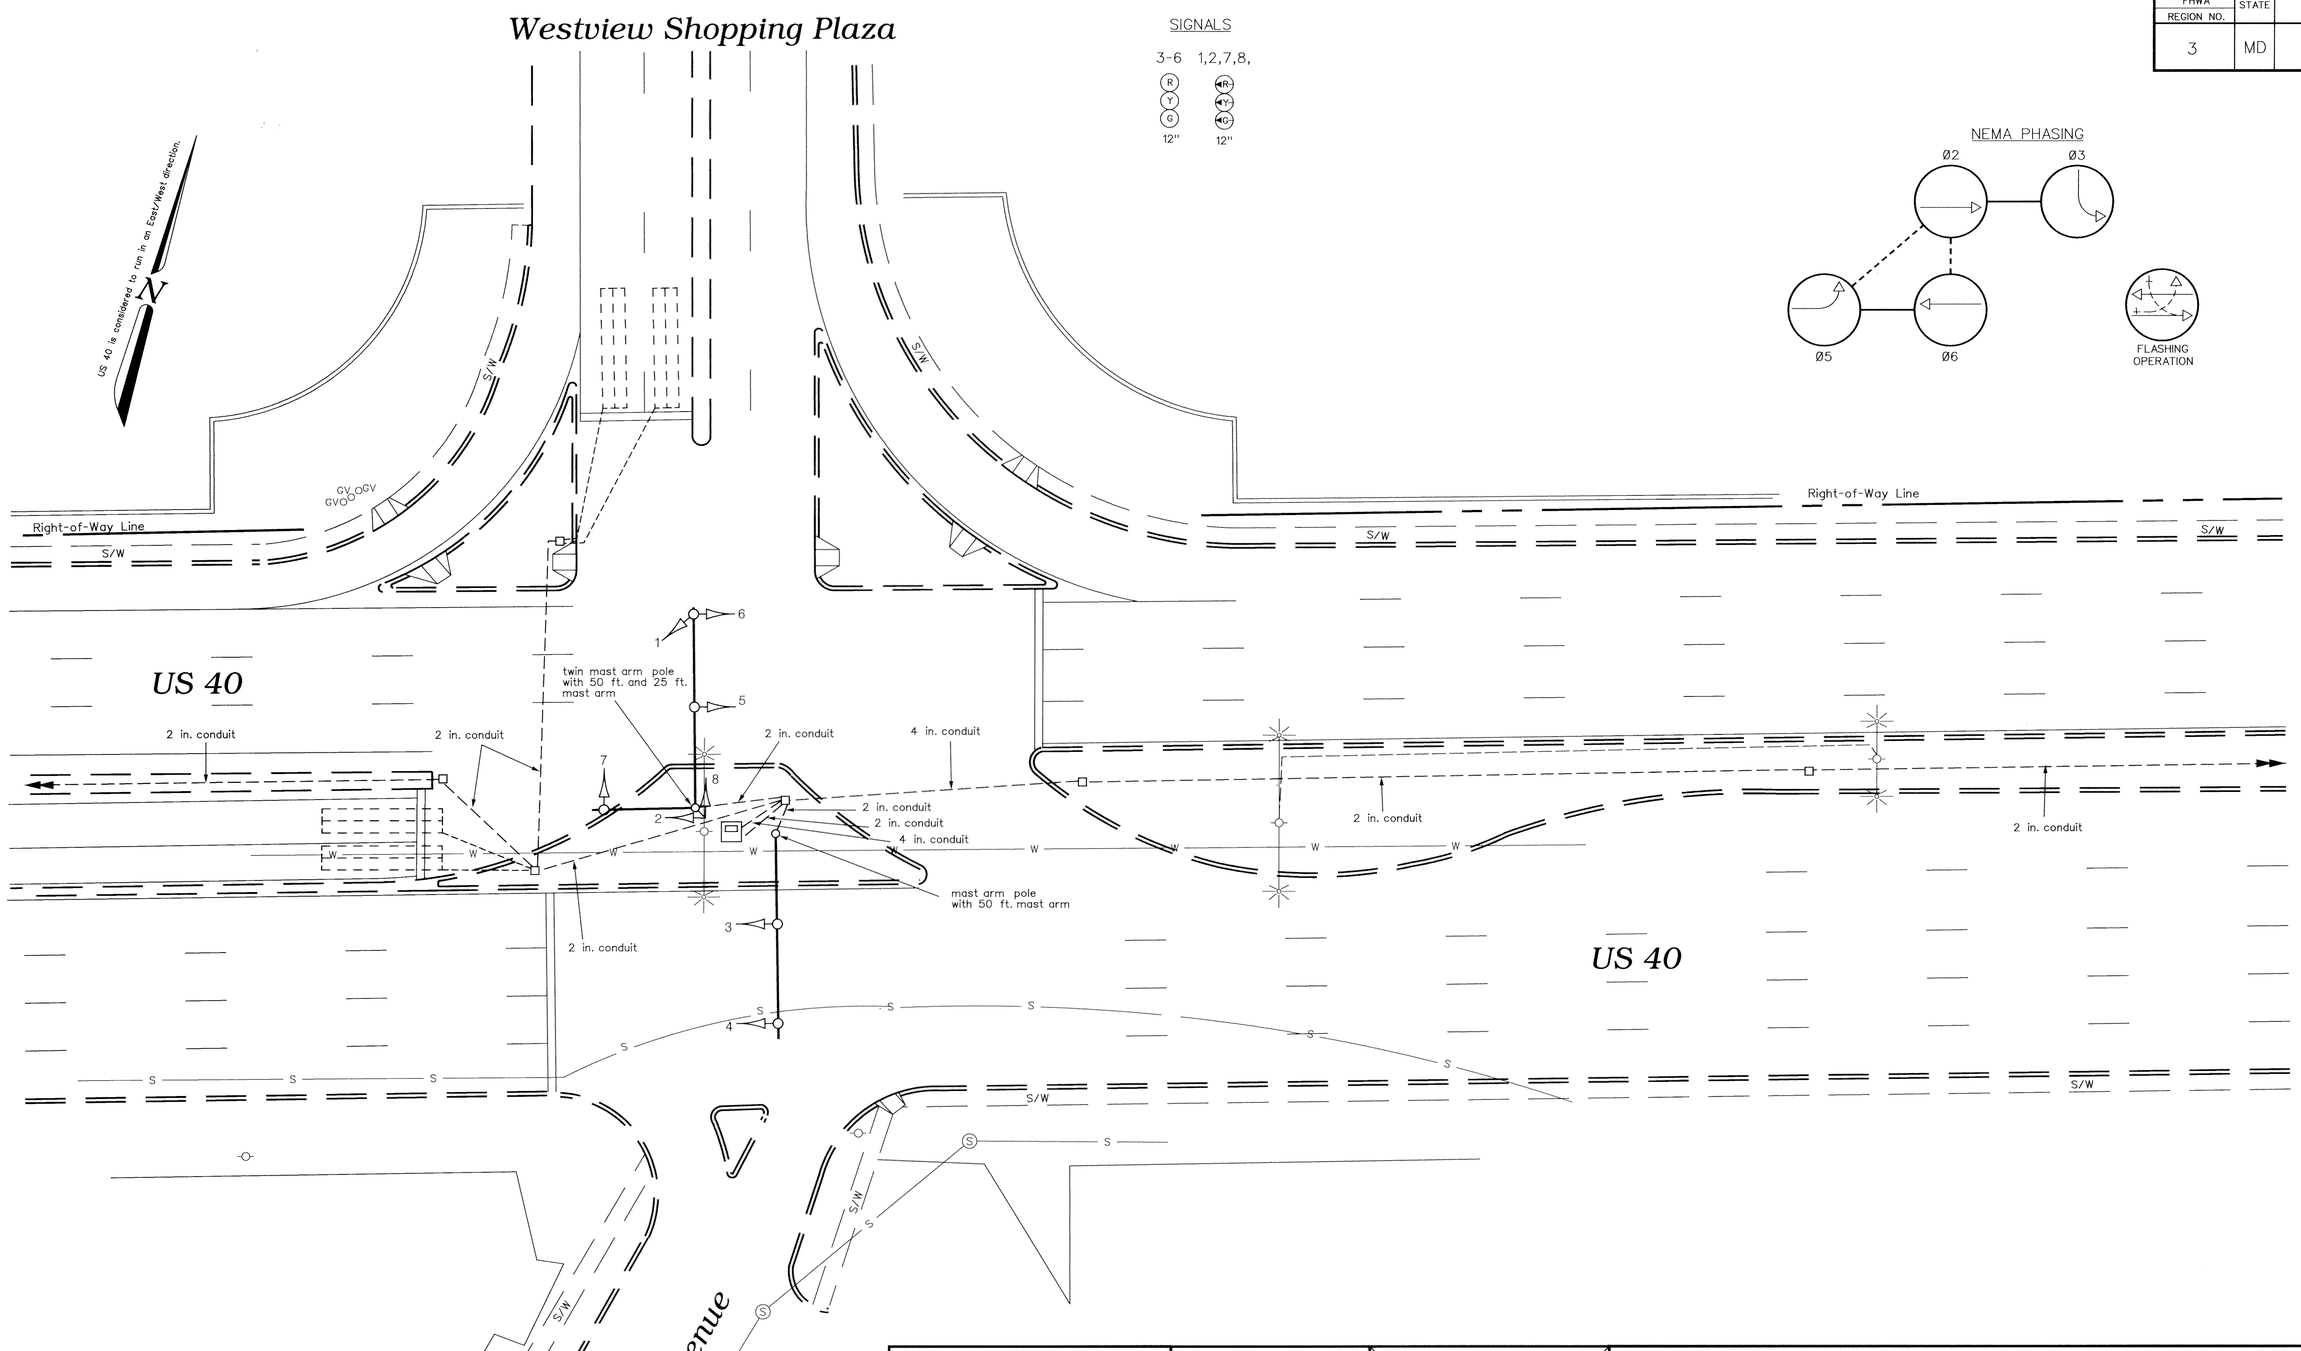

" ASBUILT"

The Traffic Group
The Traffic Group, Inc.
Suite 600
40 W. Chesapeake Avenue
Towson, Maryland 21204
410-583-8405
1-800-583-8411
Fax 410-321-8458
Job. No. 961115
ASBUILT2.DGN

GEOMETRIC LEGEND

EXISTING GEOMETRICS
PROPOSED GEOMETRICS

UTILITY LEGEND

G	GAS MAIN
W	WATER MAIN
S	SEWER MAIN
E	ELECTRIC CABLES
D	STORM DRAIN
A	AERIAL CABLES
T	TELEPHONE CABLES

REVISIONS

(B) May 1, 1997
AS-BUILT
S.H.A. No.:BW XXX-XXX-XXX
FJH

APPROVALS

ASST. DIVISION CHIEF TRAFFIC ENGINEERING DESIGN DIVISION
CHIEF, TRAFFIC ENGINEERING DESIGN DIVISION
ASST. DISTRICT ENGINEER - TRAFFIC
DIRECTOR, OFFICE OF TRAFFIC & SAFETY

ORIGINAL ON FILE

MDOT – STATE HIGHWAY ADMINISTRATION
Office of Traffic & Safety
TRAFFIC ENGINEERING DESIGN DIVISION

DRAWN BY: Les Townsend
DES. BY: (Des By)
CHK. BY: (Chk By)

(Traffic Signal Plan)
US 40, Kent Avenue & Ent. to Westview Shopping Plaza

COUNTY: Baltimore
LOG MILE • 03004002.69

DATE: January 28, 1973
SCALE: 1" = 20'
F.A.P. NO. N/A
S.H.A. NO. B-286-485
TS/STD. NO. 194B ~~1984B~~
SHEET NO. 1 of 1