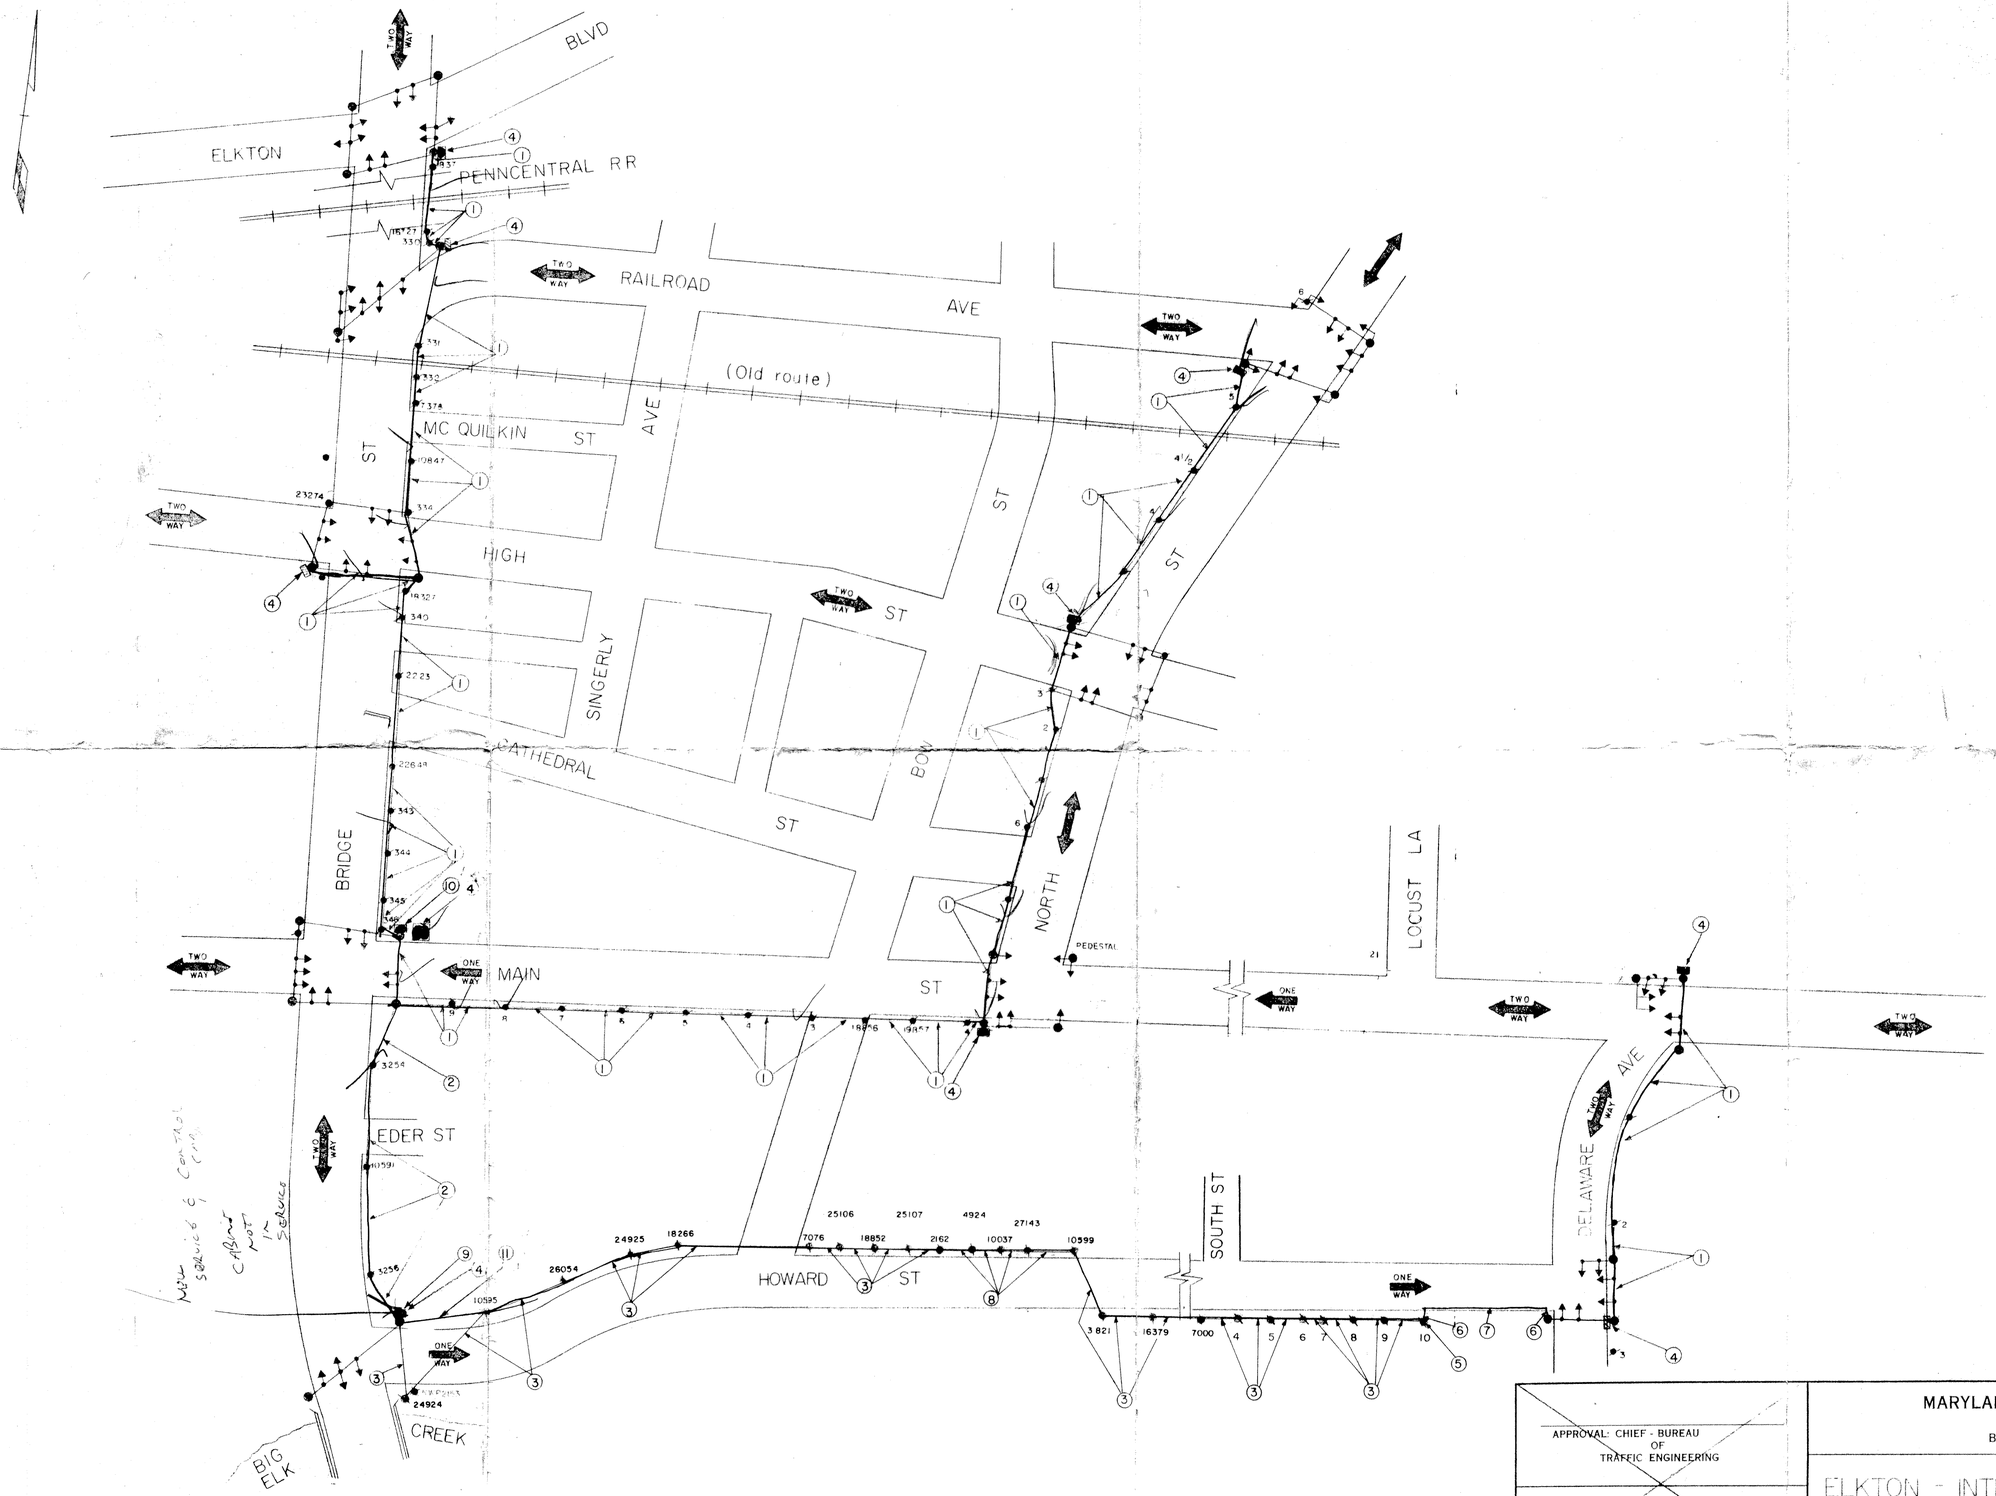

A 1/31/85
PHASE I INTERCONNECT
SHA NO. 855-2500I CABLE
DLA
REVISIONS

APPROVAL: CHIEF - BUREAU OF TRAFFIC ENGINEERING

APPROVAL: ASS'T CHIEF ENGINEER TRAFFIC SAFETY

MARYLAND STATE ROADS COMMISSION
DIVISION OF TRAFFIC SAFETY
BUREAU OF TRAFFIC ENGINEERING

ELKTON - INTERCONNECT DIAGRAM

DATE 10-3-72
SCALE NOT TO SCALE
DRAWN BY: G. COOK
CONTRACT NO
COUNTY CECIL
CHECKED BY:

DRAWING NO. TS - 115