MD 213 IS ASSUMED TO RUN
IN A NORTH SOUTH DIRECTION

PROPOSED PAVEMENT MARKINGS

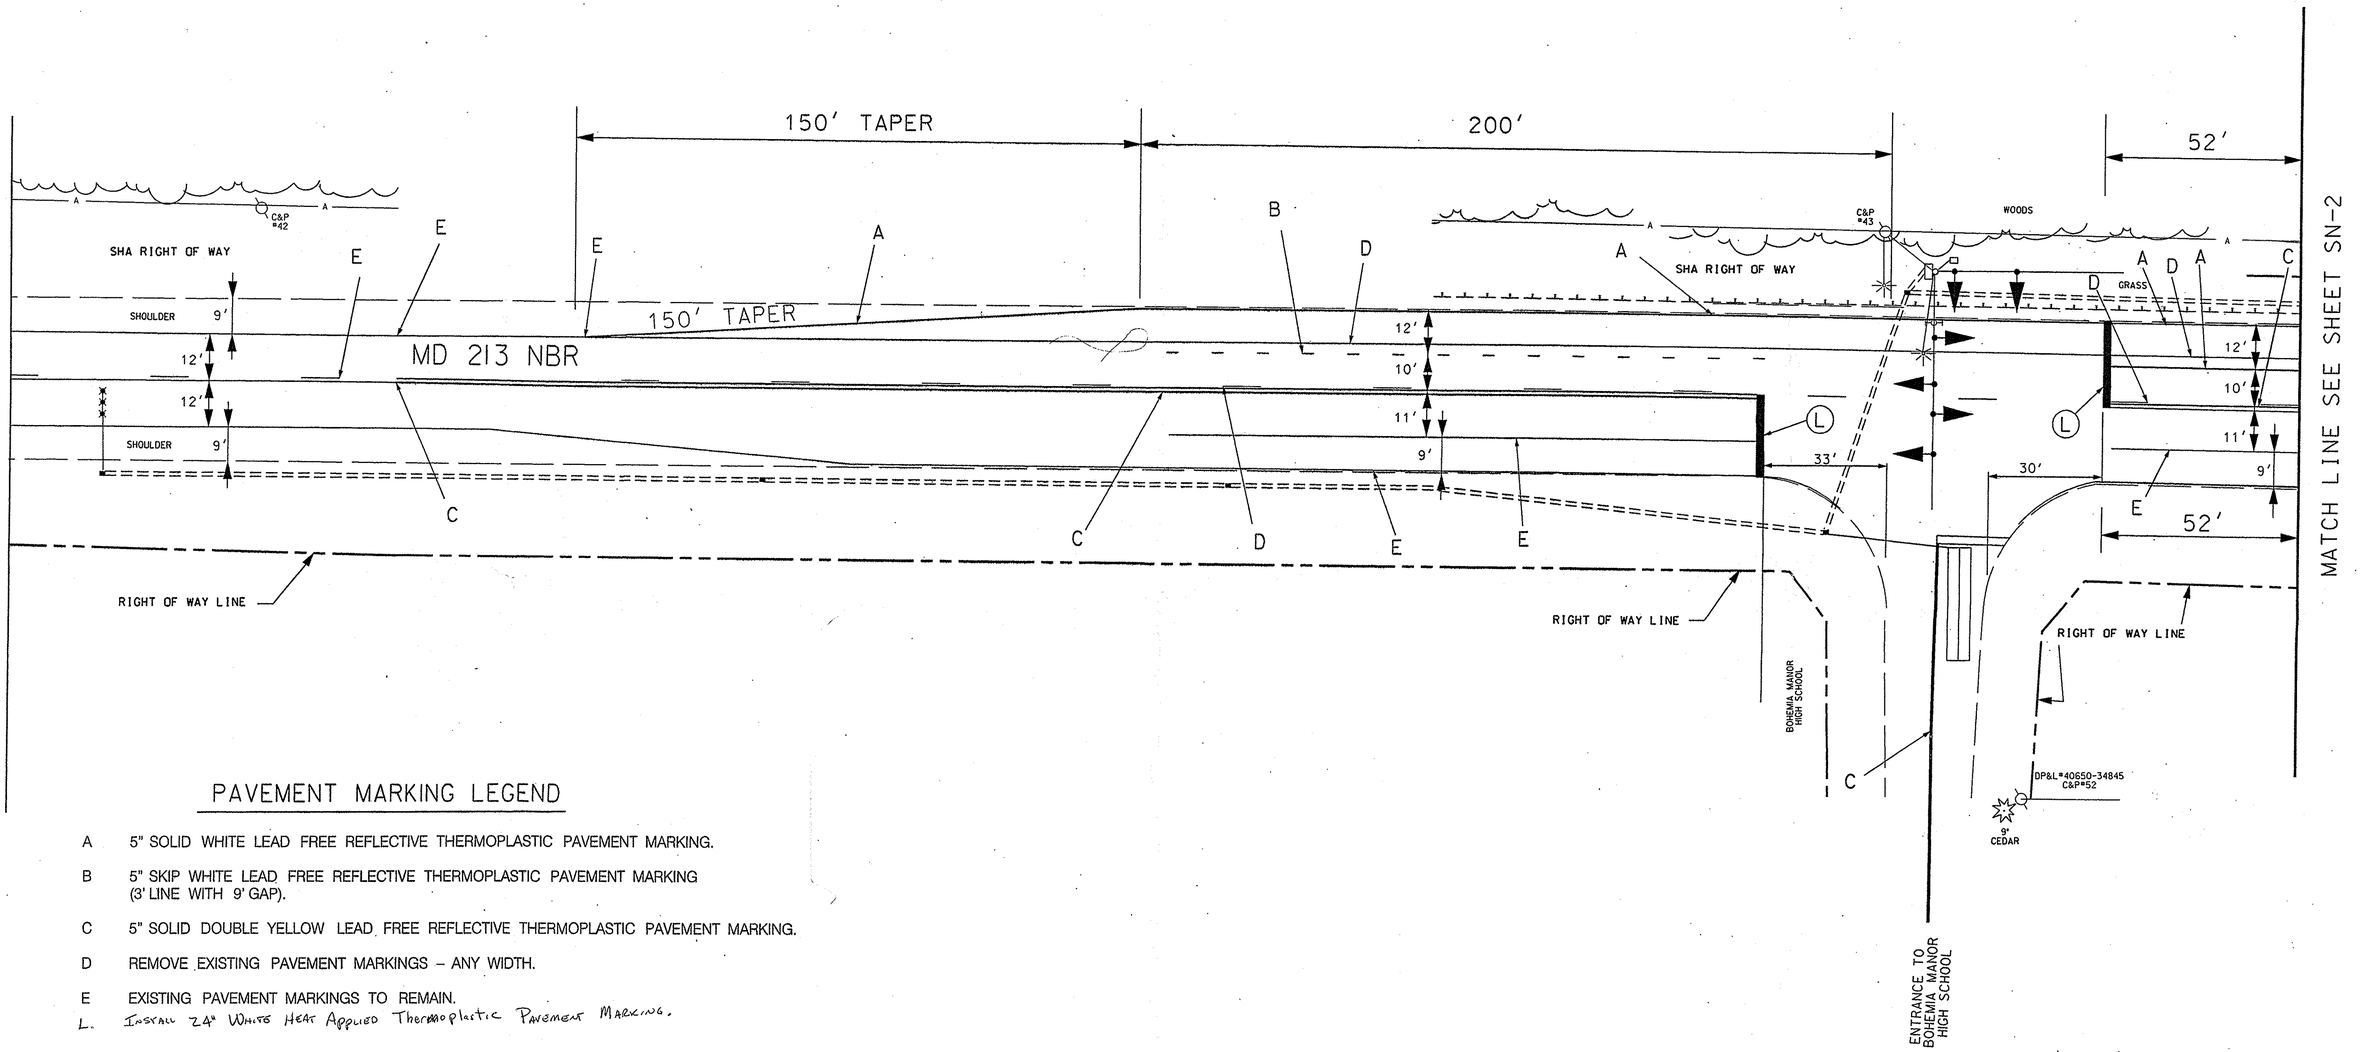

PAVEMENT MARKING LEGEND

A 5" SOLID WHITE LEAD FREE REFLECTIVE THERMOPLASTIC PAVEMENT MARKING.

B 5" SKIP WHITE LEAD FREE REFLECTIVE THERMOPLASTIC PAVEMENT MARKING (3' LINE WITH 9' GAP).

C 5" SOLID DOUBLE YELLOW LEAD FREE REFLECTIVE THERMOPLASTIC PAVEMENT MARKING.

D REMOVE EXISTING PAVEMENT MARKINGS – ANY WIDTH.

E EXISTING PAVEMENT MARKINGS TO REMAIN.

L. INSTALL 24" WHITE HEAT APPLIED THERMOPLASTIC PAVEMENT MARKING.

CENTURY ENGINEERING, INC.
CONSULTING ENGINEERS – PLANNERS
32 WEST ROAD
TOWSON, MARYLAND 21204.

MARYLAND DOT - STATE HIGHWAY ADMINISTRATION
Office of Traffic & Safety
TRAFFIC ENGINEERING DESIGN DIVISION

MD 213 and BOHEMIA MANOR HIGH SCHOOL
CAYOTS, MARYLAND

DRAWN BY:	D. ANDREWS	F.A.P. NO.	XXXXXX	TS NO. 3783 B	SHEET NO. 3 OF 4
CHECKED BY:	D. ANDREWS	S.H.A. NO.	XX-1065185		
SCALE:	1" = 20'	COUNTY:	CECIL	T.I.M.S. NO. F782	
DATE:	08/2004	LOG MILE:	07021308.18		