K&E BALTIMORE 17 0153 PHOENIX 10-78 MC 4156.

F.H.W.A. REGION NO.	STATE	FED. AID PROJ. NO.	SHEET NO.	TOTAL SHEETS
3	MD.		2	5

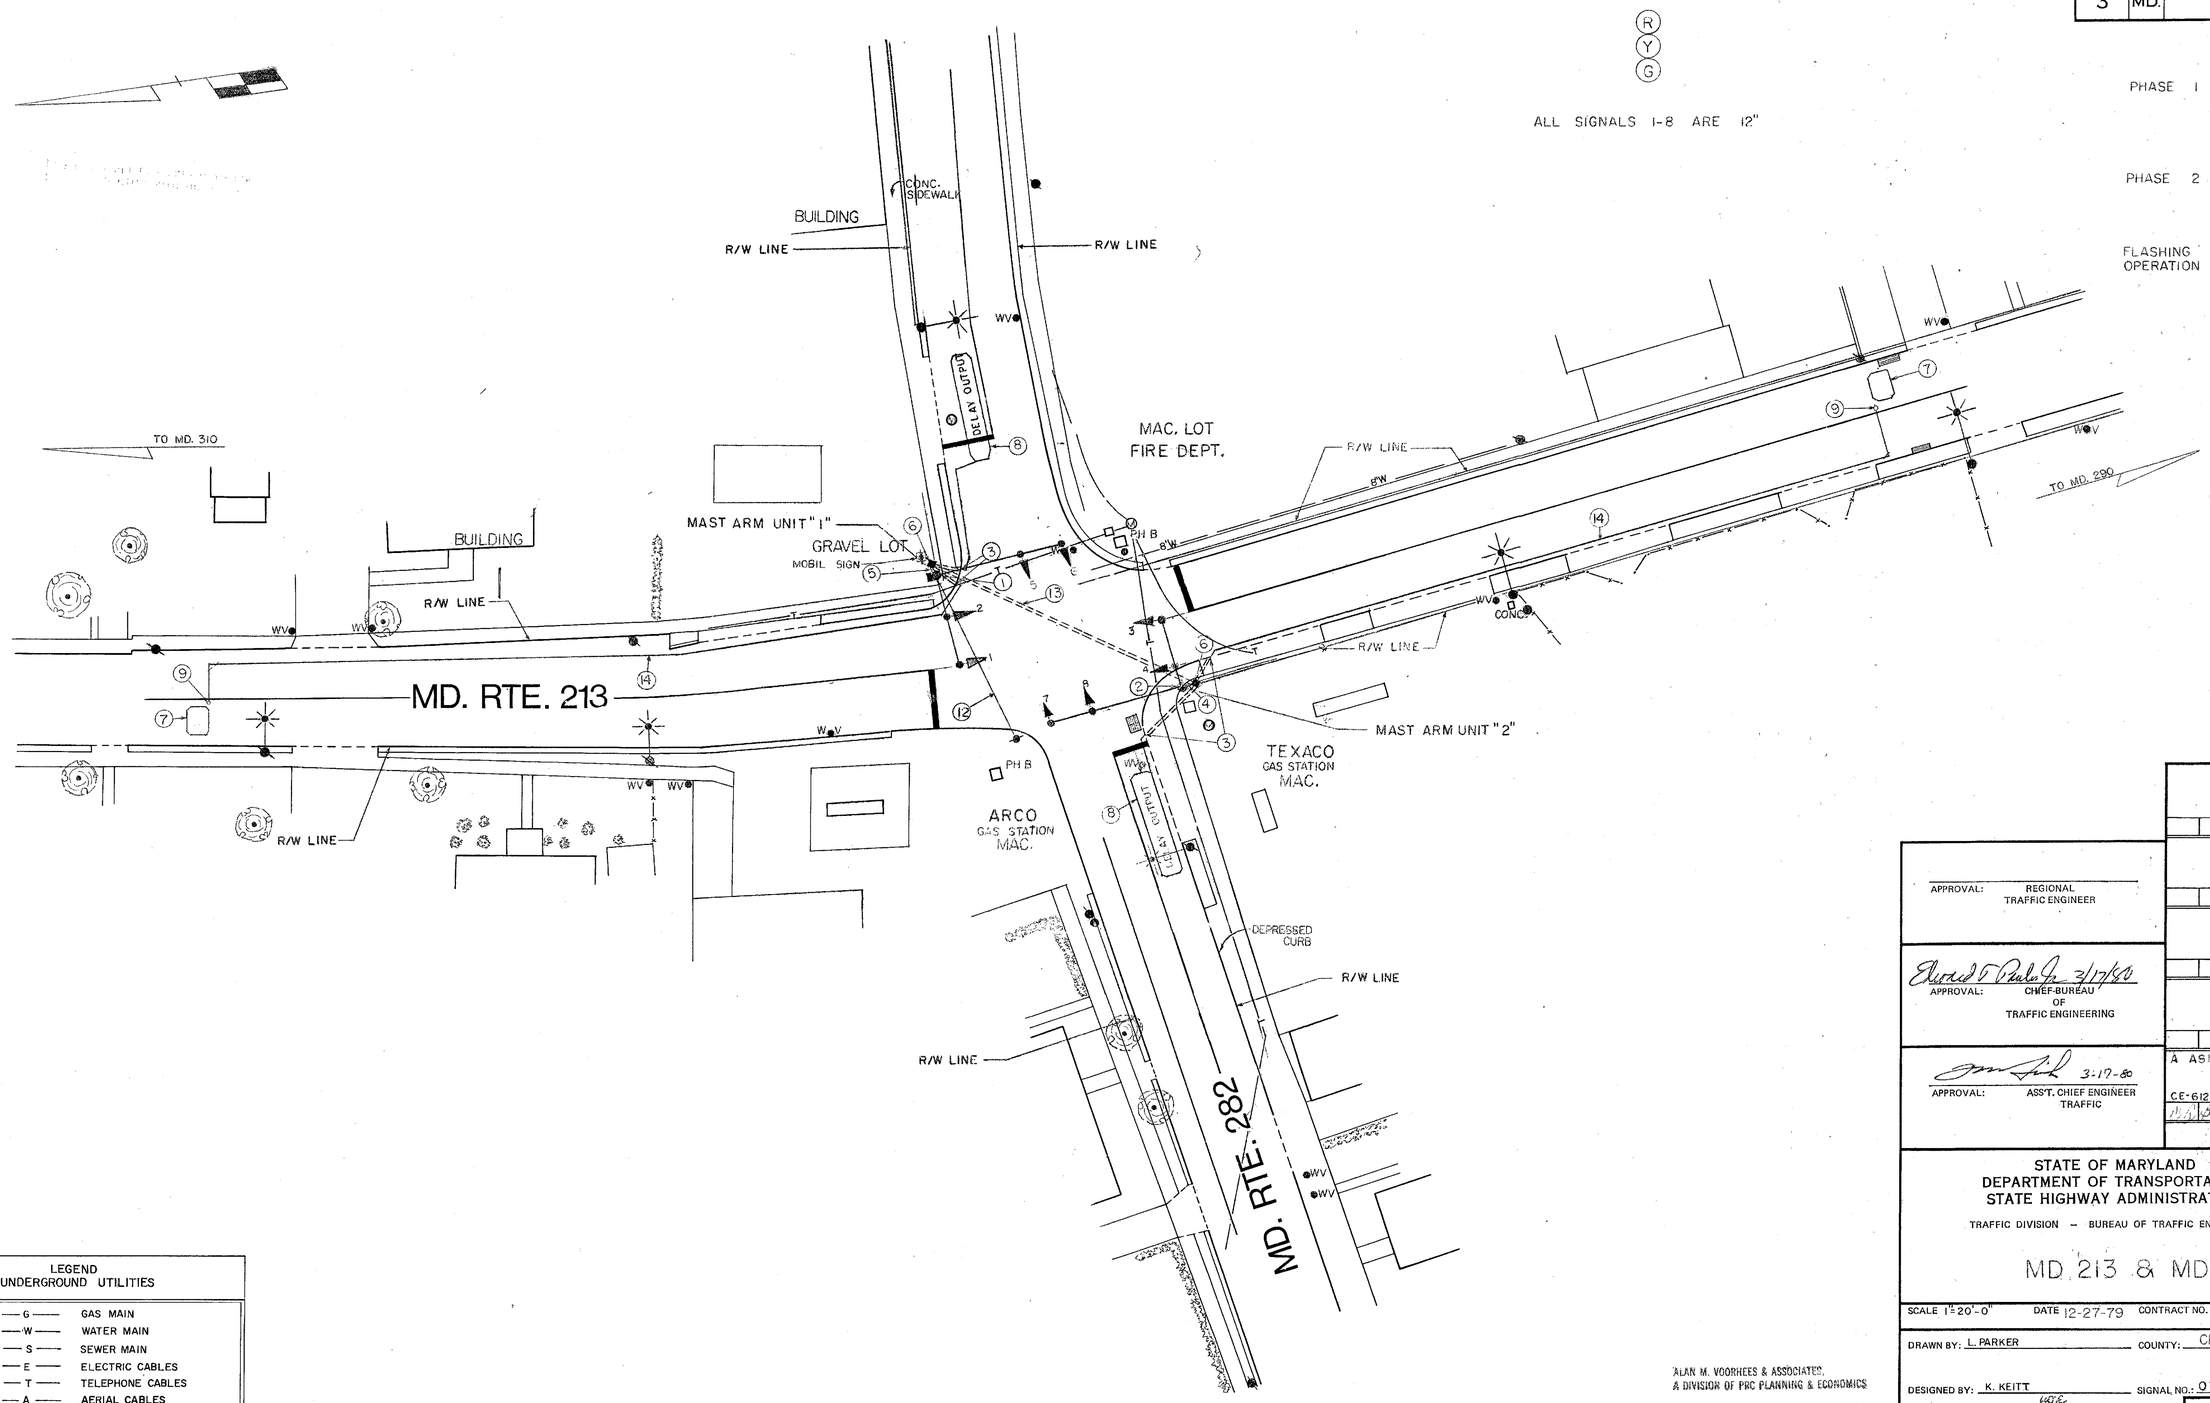

LEGEND
OF UNDERGROUND UTILITIES

—— G —— G ——	GAS MAIN
—— W —— W ——	WATER MAIN
—— S —— S ——	SEWER MAIN
—— E —— E ——	ELECTRIC CABLES
—— T —— T ——	TELEPHONE CABLES
—— A —— A ——	AERIAL CABLES

ALAN M. VOORHEES & ASSOCIATES,
A DIVISION OF PRC PLANNING & ECONOMICS

APPROVAL: REGIONAL TRAFFIC ENGINEER

Edward T. Parker Jr. 3/17/80
APPROVAL: CHIEF-BUREAU OF TRAFFIC ENGINEERING

3-17-80
APPROVAL: ASS'T. CHIEF ENGINEER TRAFFIC

A ASBUILT 7-7-82
CE-612-501-283
REVISIONS

STATE OF MARYLAND
DEPARTMENT OF TRANSPORTATION
STATE HIGHWAY ADMINISTRATION

TRAFFIC DIVISION – BUREAU OF TRAFFIC ENGINEERING

MD 213 & MD 282

SCALE 1" = 20'-0" DATE 12-27-79 CONTRACT NO.

DRAWN BY: L. PARKER COUNTY: CECIL

DESIGNED BY: K. KEITT SIGNAL NO.: 07023

CHECKED BY: 3/14/80

DRAWING NO. TS-306A