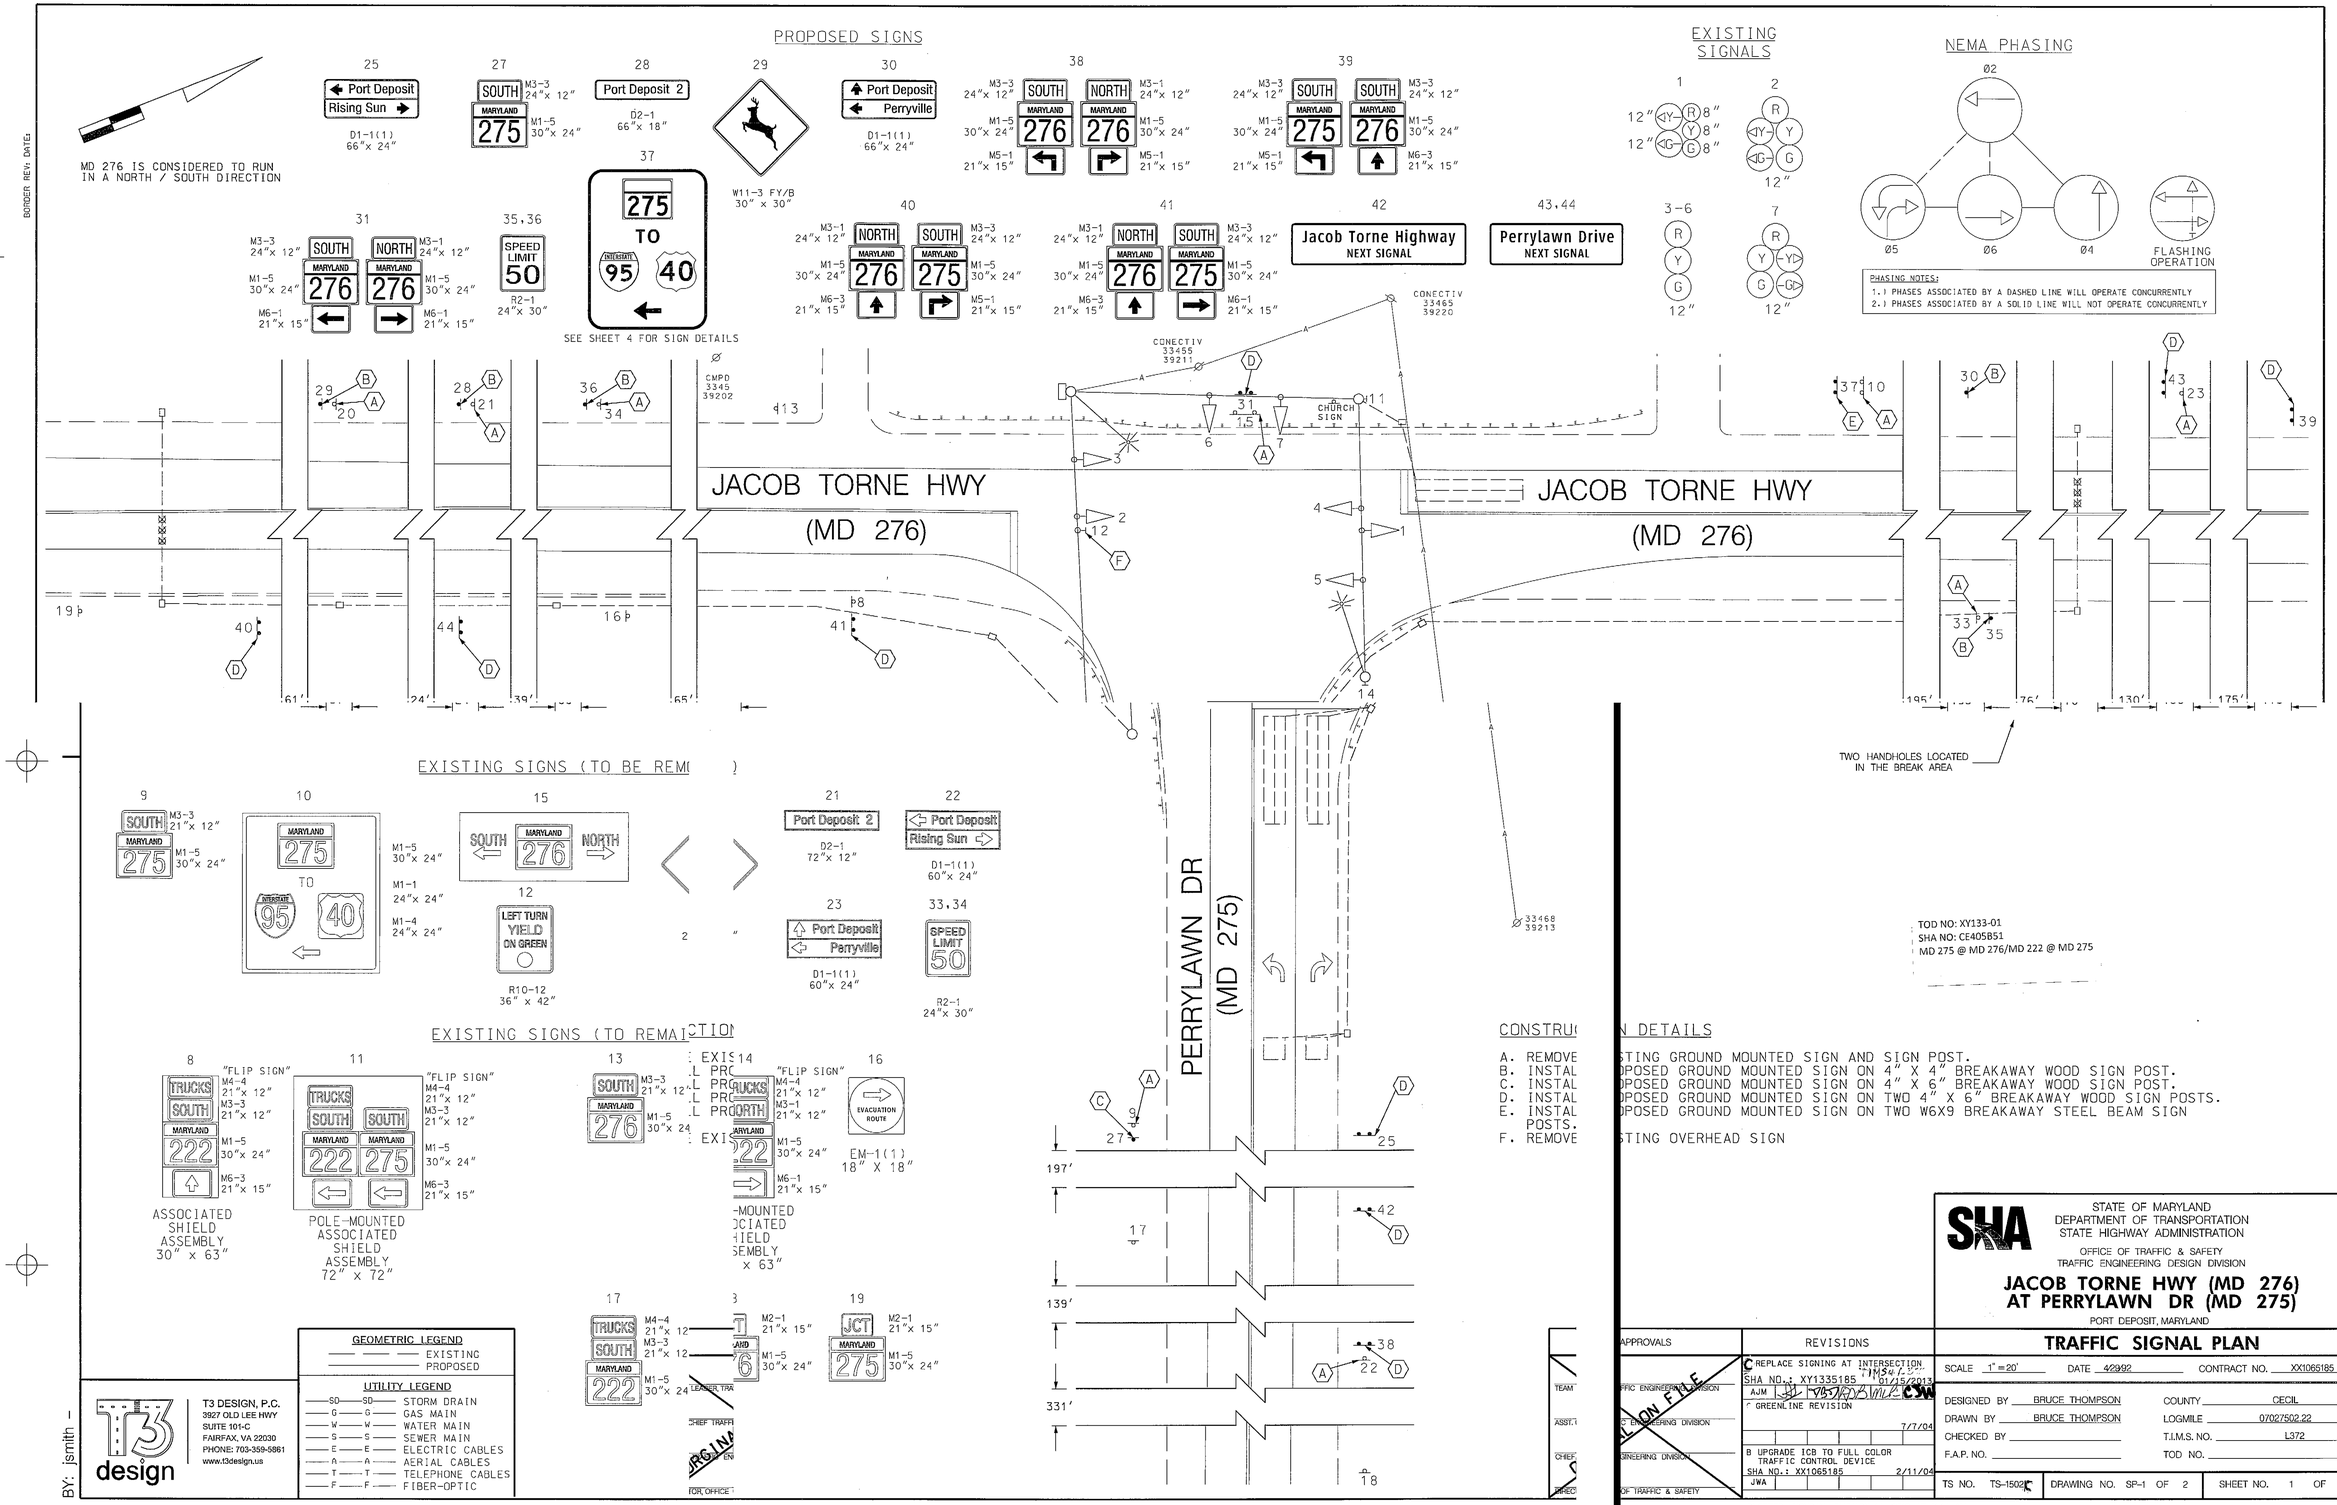

TOD NO: XY133-01
SHA NO: CE405B51
MD 275 @ MD 276/MD 222 @ MD 275

CONSTRUCTION DETAILS

A. REMOVE EXISTING GROUND MOUNTED SIGN AND SIGN POST.
B. INSTALL PROPOSED GROUND MOUNTED SIGN ON 4" X 4" BREAKAWAY WOOD SIGN POST.
C. INSTALL PROPOSED GROUND MOUNTED SIGN ON 4" X 6" BREAKAWAY WOOD SIGN POST.
D. INSTALL PROPOSED GROUND MOUNTED SIGN ON TWO 4" X 6" BREAKAWAY WOOD SIGN POSTS.
E. INSTALL PROPOSED GROUND MOUNTED SIGN ON TWO W6X9 BREAKAWAY STEEL BEAM SIGN POSTS.
F. REMOVE EXISTING OVERHEAD SIGN

STATE OF MARYLAND
DEPARTMENT OF TRANSPORTATION
STATE HIGHWAY ADMINISTRATION
OFFICE OF TRAFFIC & SAFETY
TRAFFIC ENGINEERING DESIGN DIVISION

JACOB TORNE HWY (MD 276) AT PERRYLAWN DR (MD 275)
PORT DEPOSIT, MARYLAND

APPROVALS
TRAFFIC ENGINEERING DIVISION
TRAFFIC ENGINEERING DIVISION
TRAFFIC ENGINEERING DIVISION
OF TRAFFIC & SAFETY

REVISIONS
C REPLACE SIGNING AT INTERSECTION. SHA NO.: XY133518S AJM 01/15/2013 CSW
GREENLINE REVISION 7/7/04
B UPGRADE ICB TO FULL COLOR TRAFFIC CONTROL DEVICE SHA NO.: XX1065185 JWA 2/11/04

TRAFFIC SIGNAL PLAN

SCALE 1" = 20'	DATE 4/2992	CONTRACT NO. XX1065185	
DESIGNED BY BRUCE THOMPSON		COUNTY CECIL	
DRAWN BY BRUCE THOMPSON		LOGMILE 07027502.22	
CHECKED BY		T.I.M.S. NO. L372	
F.A.P. NO.		TOD NO.	
TS NO. TS-1502C	DRAWING NO. SP-1 OF 2	SHEET NO. 1 OF 2	

PLOTTED: MONDAY, JANUARY 14, 2013 AT 11:14 AM