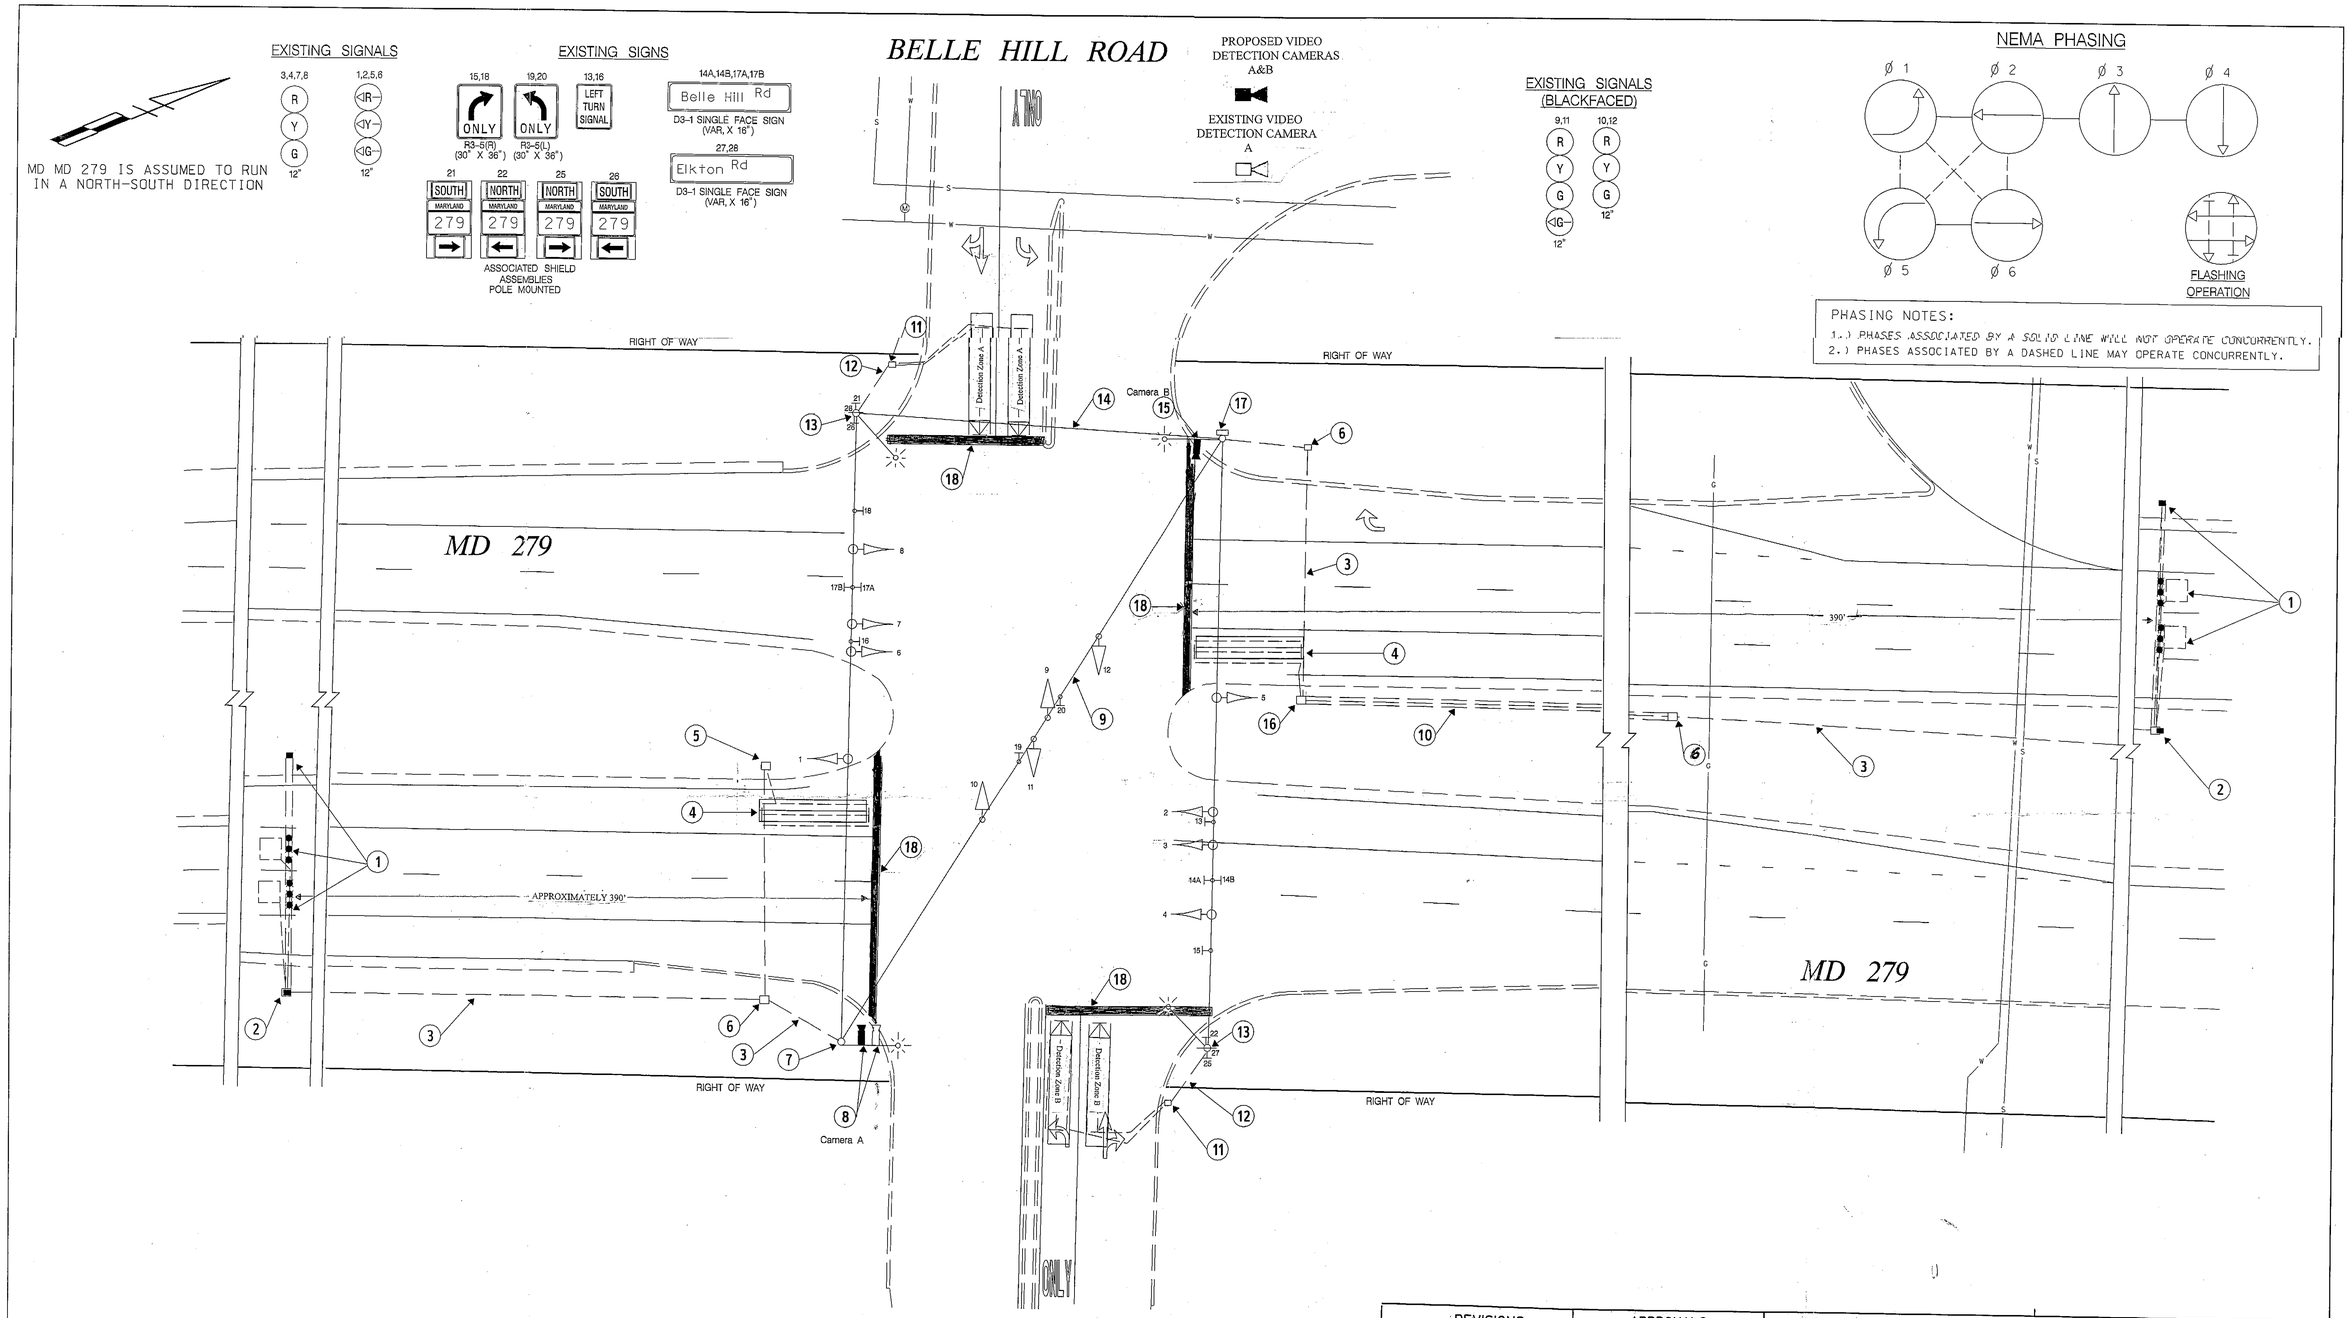

LEGEND OF UNDERGROUND AND OVERHEAD UTILITIES

AERIAL CABLE	A
ELECTRICAL	E
TELEPHONE	T
GAS	G
SEWER	S
WATER	W
CABLE TV	TV

TRAFFIC CONCEPTS, INC.
325 Gambrills Road
Suite E
Gambrills, MD 21054
(410) 923-7101
FAX (410) 923-6473 EMAIL TRACONCEPT@AOL.COM

REVISIONS

(E) Installation of Video Detection & Probe Sets XX6625185 9/2011 L-034

(C) CHANGE SIDE STREET TO SPLIT PHASE 05/2004 SHA NO. XX1065185

M.B.	W.M.	M.A.R.	D.A.I.	R.R.K.	

B CHANGED FLASHING EXCLUSIVE ON MD 279 TO STANDARD EXCLUSIVE PHASE: CONVERT HEADS TO BLACK FACED 08/2001

C.A.S.	M.A.R.	D.A.I.	R.R.K.		T.H.

A AS BUILT: L.T.'S ON MD 279 TO EXCLUSIVE 04/1997

W.M.	S.R.	D.A.I.	T.A.P.		T.H.

APPROVALS

TEAM LEADER, TRAFFIC ENGINEERING DESIGN DIVISION

ASST. CHIEF TRAFFIC ENGINEERING DESIGN DIVISION

CHIEF, TRAFFIC ENGINEERING DESIGN DIVISION

DIRECTOR, TRAFFIC & SAFETY

ORIGINAL ON FILE

MARYLAND DOT - STATE HIGHWAY ADMINISTRATION
Office of Traffic & Safety
TRAFFIC ENGINEERING DESIGN DIVISION
SIGNALIZATION PLAN
MD 279 AND BELLE HILL ROAD

DRAWN BY:	McCrone, Inc.	F.A.P. NO.		TS NO. 2163-E	SHEET NO. 1 OF
CHECKED BY:	M GRAHAM	S.H.A. NO.			
SCALE:	1" = 20'	COUNTY:	CECIL	T.I.M.S. NO.	
DATE:	MARCH, 1986	LOG MILE:	07027903.39		