F.H.W.A. REGION NO.	STATE	FED. AID PROJ. NO.	SHEET NO.	TOTAL SHEETS
3	MD.		7	10

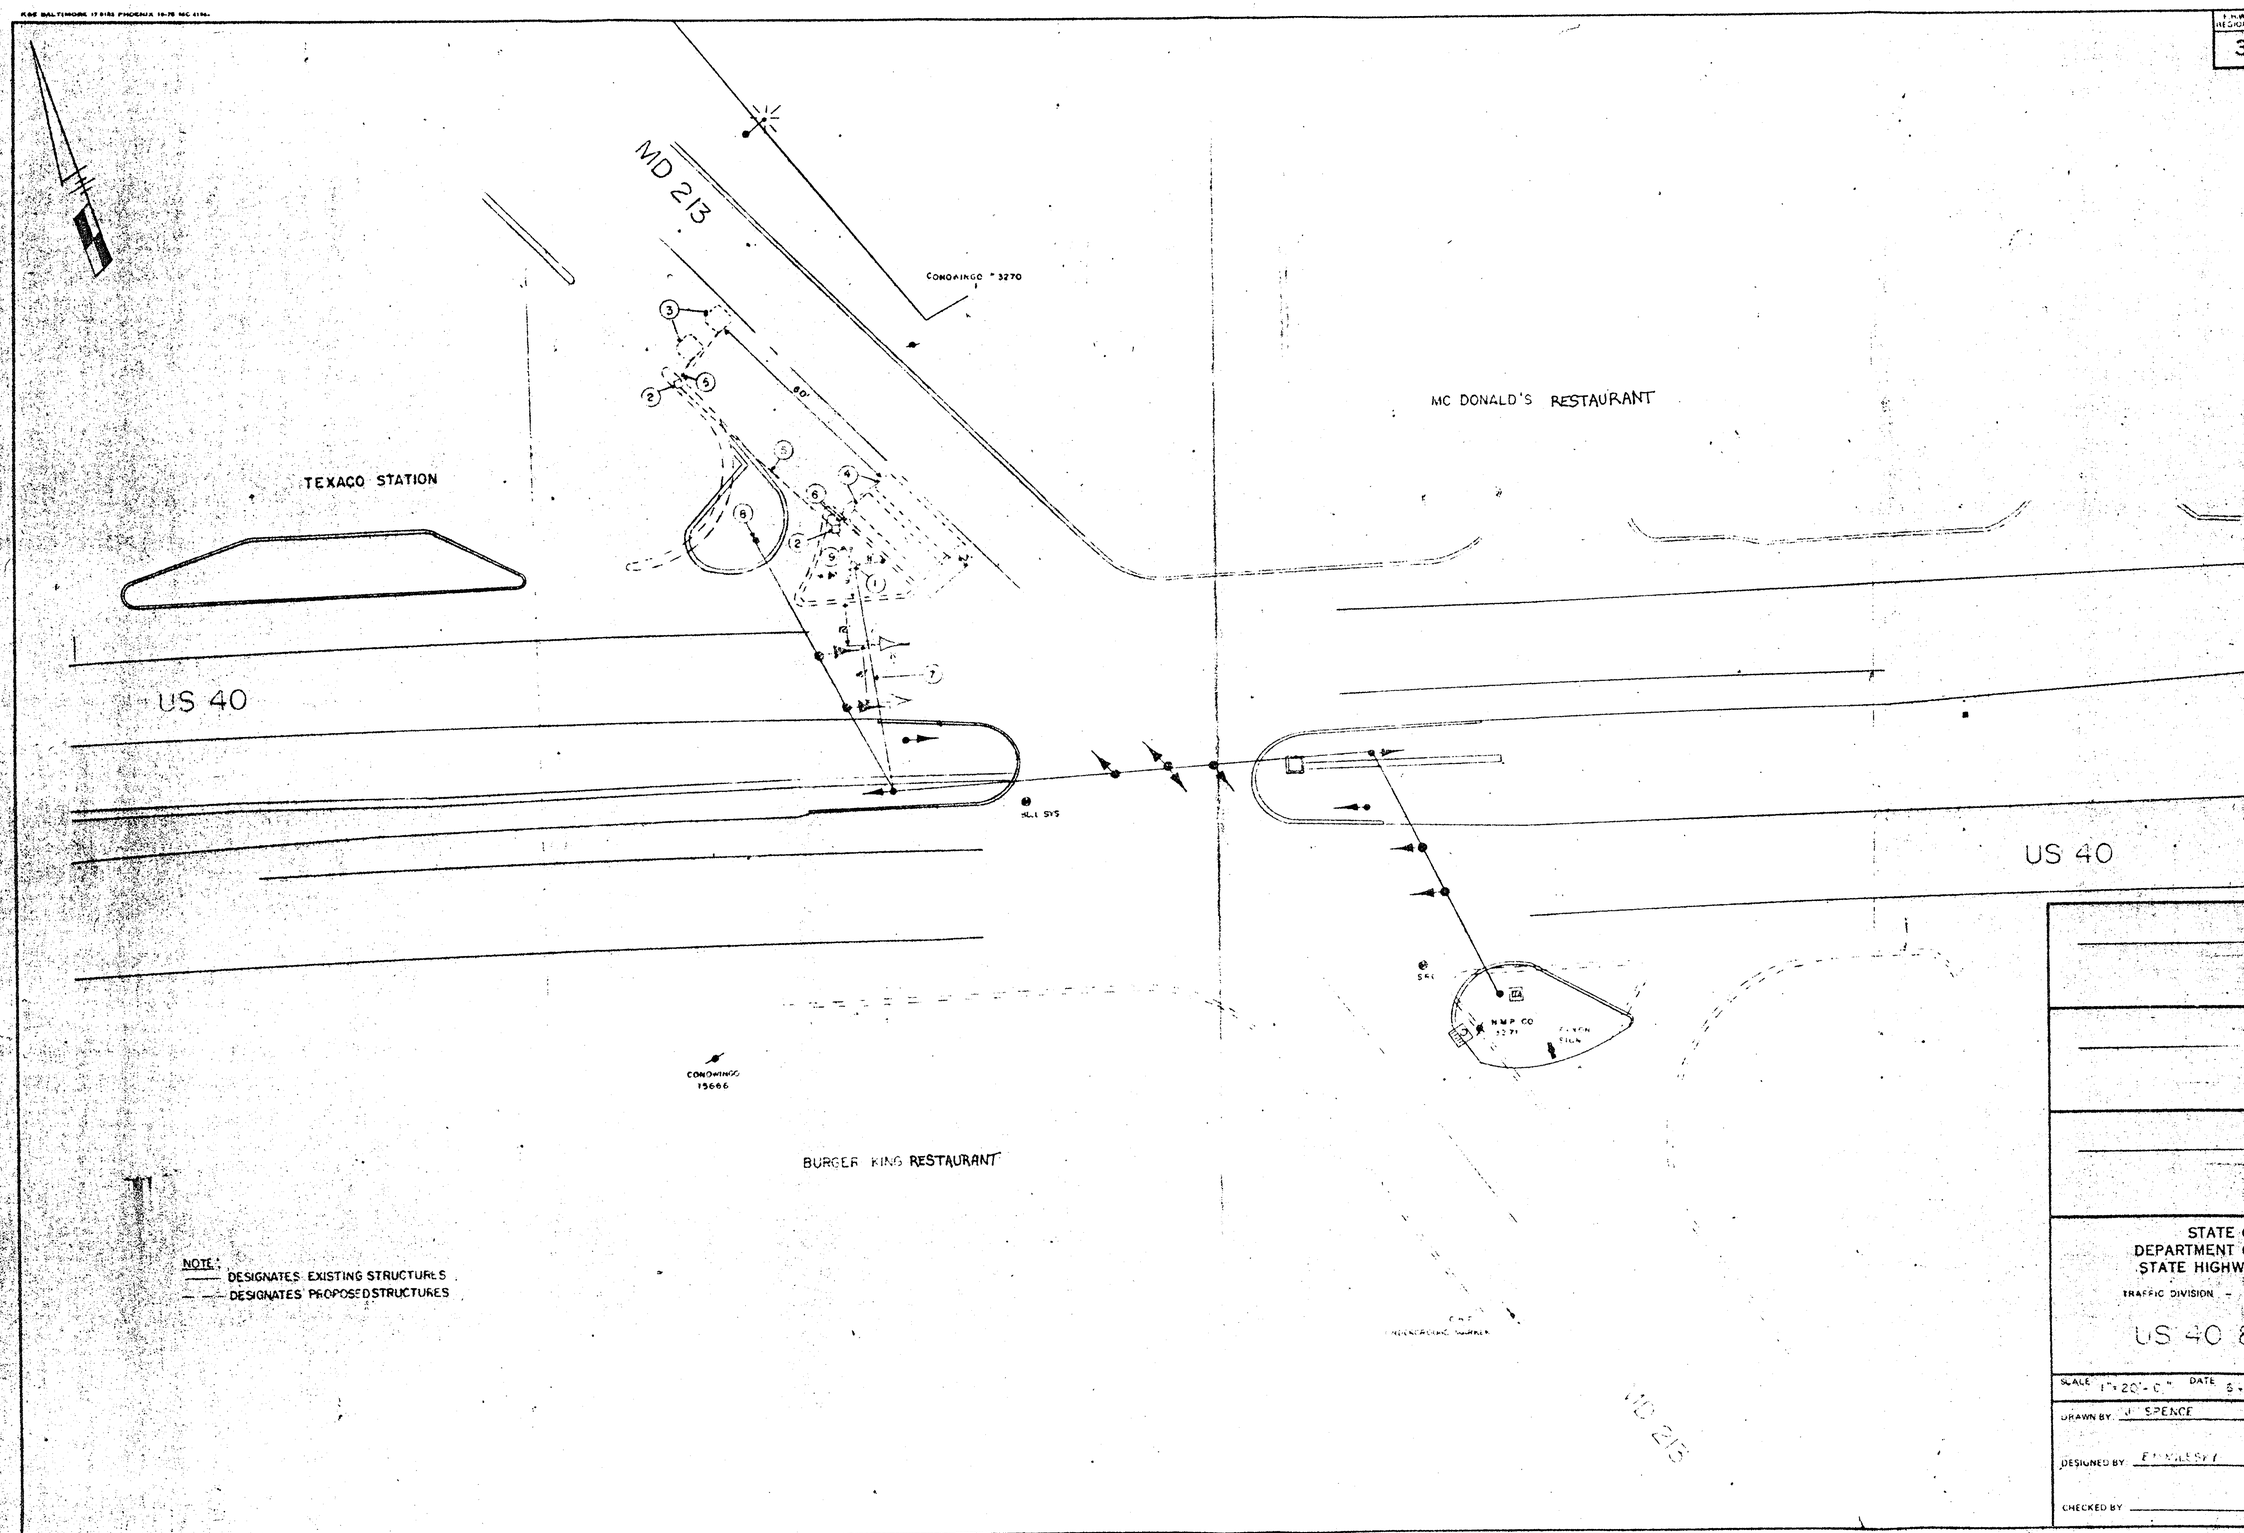

A 4-19-82
RELOCATION OF POLE AND SIGNAL HEADS FOR HWY. CONTRACT # CE 652-501-276

EMM | SR

REVISIONS

STATE OF MARYLAND
DEPARTMENT OF TRANSPORTATION
STATE HIGHWAY ADMINISTRATION

TRAFFIC DIVISION – BUREAU OF TRAFFIC ENGINEERING

US 40 & MD 213

SCALE 1" = 20'-0" DATE 5-10-76 CONTRACT NO. CE 652-501-276

DRAWN BY J. SPENCE COUNTY CECIL

DESIGNED BY E. [illegible] SIGNAL NO.

CHECKED BY

DRAWING NO. TS-272