F H W A REGION NO.	STATE	FED. AID PROJ. NO.	SHEET NO.	TOTAL SHEETS
3	MD			

N

EXISTING PHASE CHART

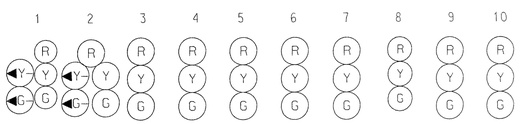

PHASE 1 & 6	◄ G/G	◄ G/G	G	R	R	R	R	R	R	R
1 CHANGE	◄ Y/G	◄ Y/G	G	R	R	R	R	R	R	R
PHASE 2 & 6	G	G	G	G	G	R	R	R	R	R
2 & 6 CHANGE	Y	Y	Y	Y	Y	R	R	R	R	R
PHASE 4 & 8	R	R	R	R	R	G	G	G	G	G
4 & 8 CHANGE	R	R	R	R	R	Y	Y	Y	Y	Y
FLASHING OPERATION	FL/Y	FL/Y	FL/Y	FL/Y	FL/Y	FL/R	FL/R	FL/R	FL/R	FL/R

EXISTING PHASE CHART

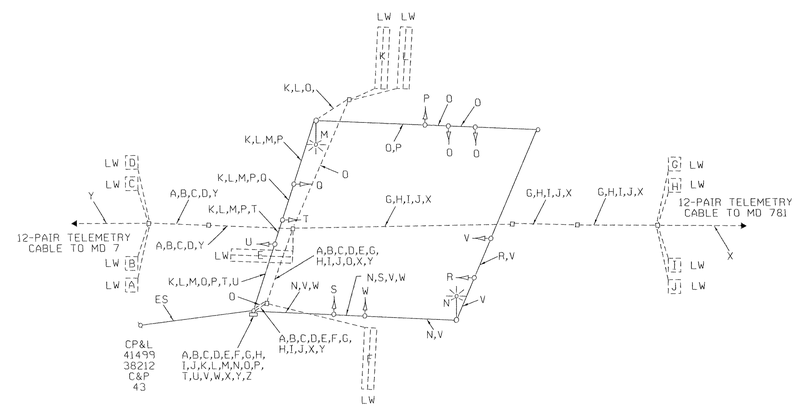

EXISTING WIRING KEY

A B C D E F G H I J K L	2-conductor electrical cable (No. 14 A.W.G.) (aluminum shielded)
M N	2-conductor electrical cable (No. 12 A.W.G.) type THHN tray cable
O P Q R S	5-conductor electrical cable (No. 14 A.W.G.)
T U V W	7-conductor electrical cable (No. 14 A.W.G.)
X Y	12-pair voice grade telemetry cable (No. 19 A.W.G.) jelly-filled.
Z —	3-wire electrical cable (No. 4 A.W.G.)
LW —	Loopwire (No. 14 A.W.G.) encased in ¼" flexible tubing
ES —	Overhead electrical service by CP&L.

REVISION "C" ASBUILT

STREET TRAFFIC STUDIES, LTD.®

Gateway International
1302 Concourse Drive, Suite 104
Linthicum, Maryland 21090
Ph (410) 859-3553
Fax (410) 859-3579

3176ASPC.DGN

REVISIONS

C 6-9-97
ASBUILT
SHA NO. BW969M82
RRZ

B 3-31-97
ADD N/B 08, LOOPS, HEADS
SHA NO. BW969M82
RRZ

A 7-16-92
INSTALL TELEMETRY CABLE AND ASBUILT
F.A.P. NO. CGM-125-1(14)
SHA NO. CE-725-501-285
RRZ

APPROVALS

ASST. CHIEF TEDD SECTION

ASST. DISTRICT ENGINEER, TRAFFIC

CHIEF, TRAFFIC ENGINEERING DESIGN DIVISION

DIRECTOR, TRAFFIC & SAFETY

ORIGINAL ON FILE

MARYLAND DOT - STATE HIGHWAY ADMINISTRATION
Office of Traffic & Safety
TRAFFIC ENGINEERING DESIGN DIVISION

US 40 AND MELBOURNE BLVD

DRAWN BY: R. RUSSELL	COUNTY: CECIL	TS NO. 2378C	SHEET NO. 2 OF 2
CHECK BY: ZIAD A. SABRA	LOG MILE: 07004016.55		
DATE: 10-2-81	F.A.P. NO.	T.I.M.S. NO.	
SCALE: NONE	S.H.A. NO.		

JUN 13 1997

(E-2)