FHWA REGION NO.	STATE	FED. AID PROJ. NO.	SHEET NO.	TOTAL SHEETS
3	MD			

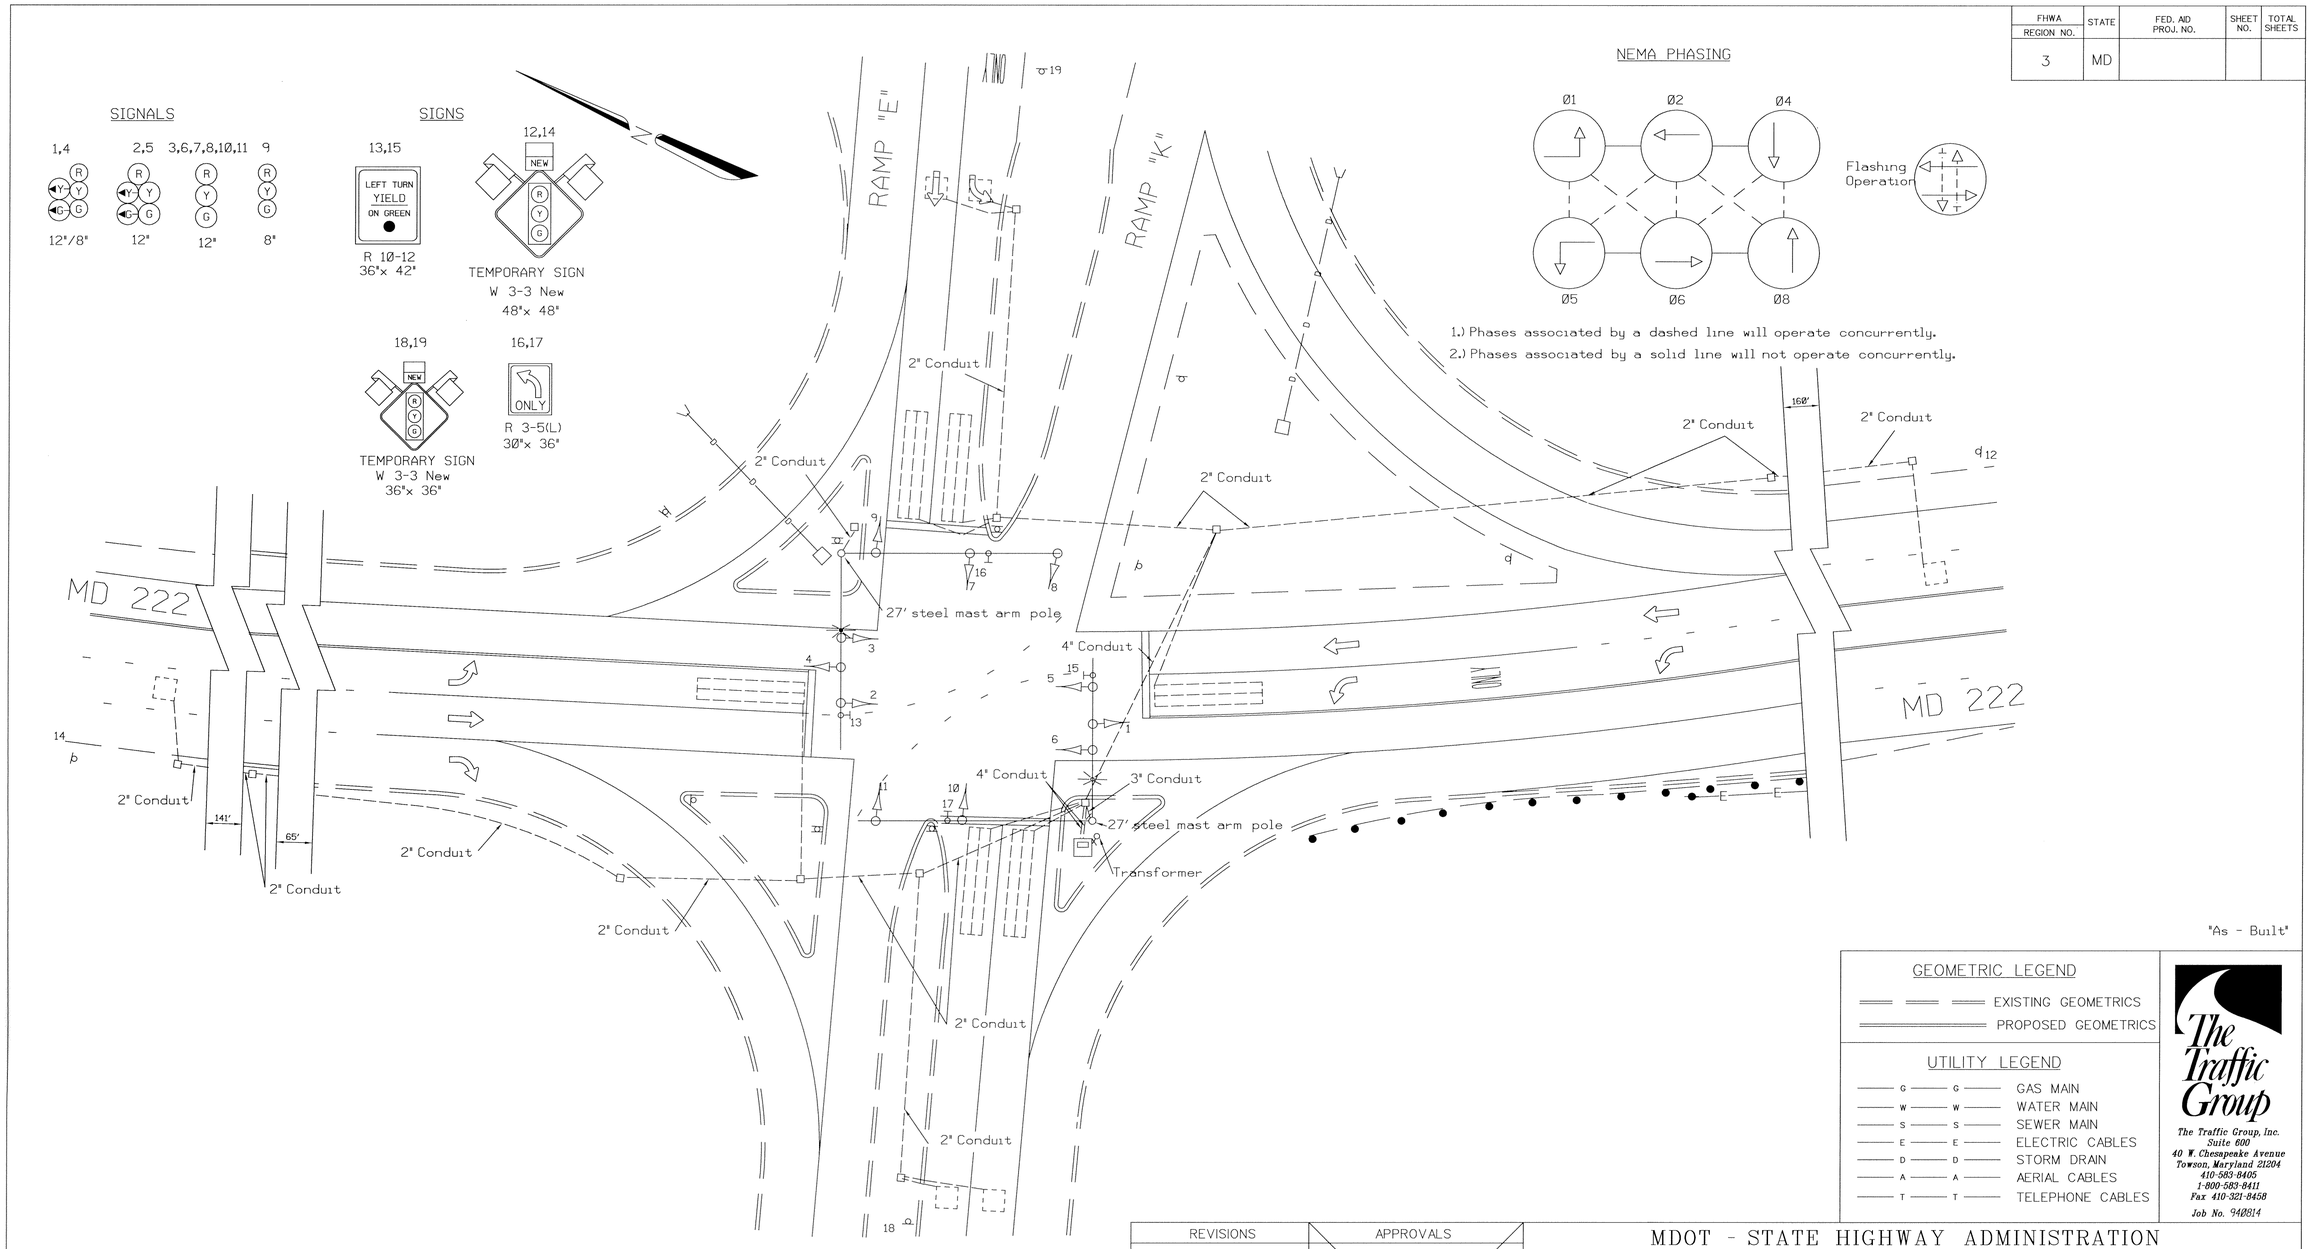

"As - Built"

GEOMETRIC LEGEND

EXISTING GEOMETRICS

PROPOSED GEOMETRICS

UTILITY LEGEND

G	GAS MAIN
W	WATER MAIN
S	SEWER MAIN
E	ELECTRIC CABLES
D	STORM DRAIN
A	AERIAL CABLES
T	TELEPHONE CABLES

The Traffic Group

The Traffic Group, Inc.
Suite 600
40 W. Chesapeake Avenue
Towson, Maryland 21204
410-583-8405
1-800-583-8411
Fax 410-321-8458

Job No. 940814

REVISIONS	APPROVALS
	ASST. DIVISION CHIEF TRAFFIC ENGINEERING DESIGN DIVISION
	CHIEF, TRAFFIC ENGINEERING DESIGN DIVISION
	ASST. DISTRICT ENGINEER - TRAFFIC
June 16, 1996 "AS-BUILT" S.H.A. NO.: BW-768-802-212 M.A.M.	DIRECTOR, OFFICE OF TRAFFIC & SAFETY

ORIGINAL ON FILE

MDOT - STATE HIGHWAY ADMINISTRATION

Office of Traffic & Safety

TRAFFIC ENGINEERING DESIGN DIVISION

DRAWN BY: M.A. MEARS

DES. BY: M.A. MEARS

CHK. BY:

DATE: March 17, 1995

SCALE: 1" = 20'

F.A.P. NO.

S.H.A. NO.

TRAFFIC SIGNAL PLAN

MD 222 AT RAMP "E" FROM SB I-95/ RAMP "K" TO SB I-95

COUNTY: CECIL

LOG MILE • 07022202.06

TS/STD. NO. 3494B-P

SHEET NO.